


SEE

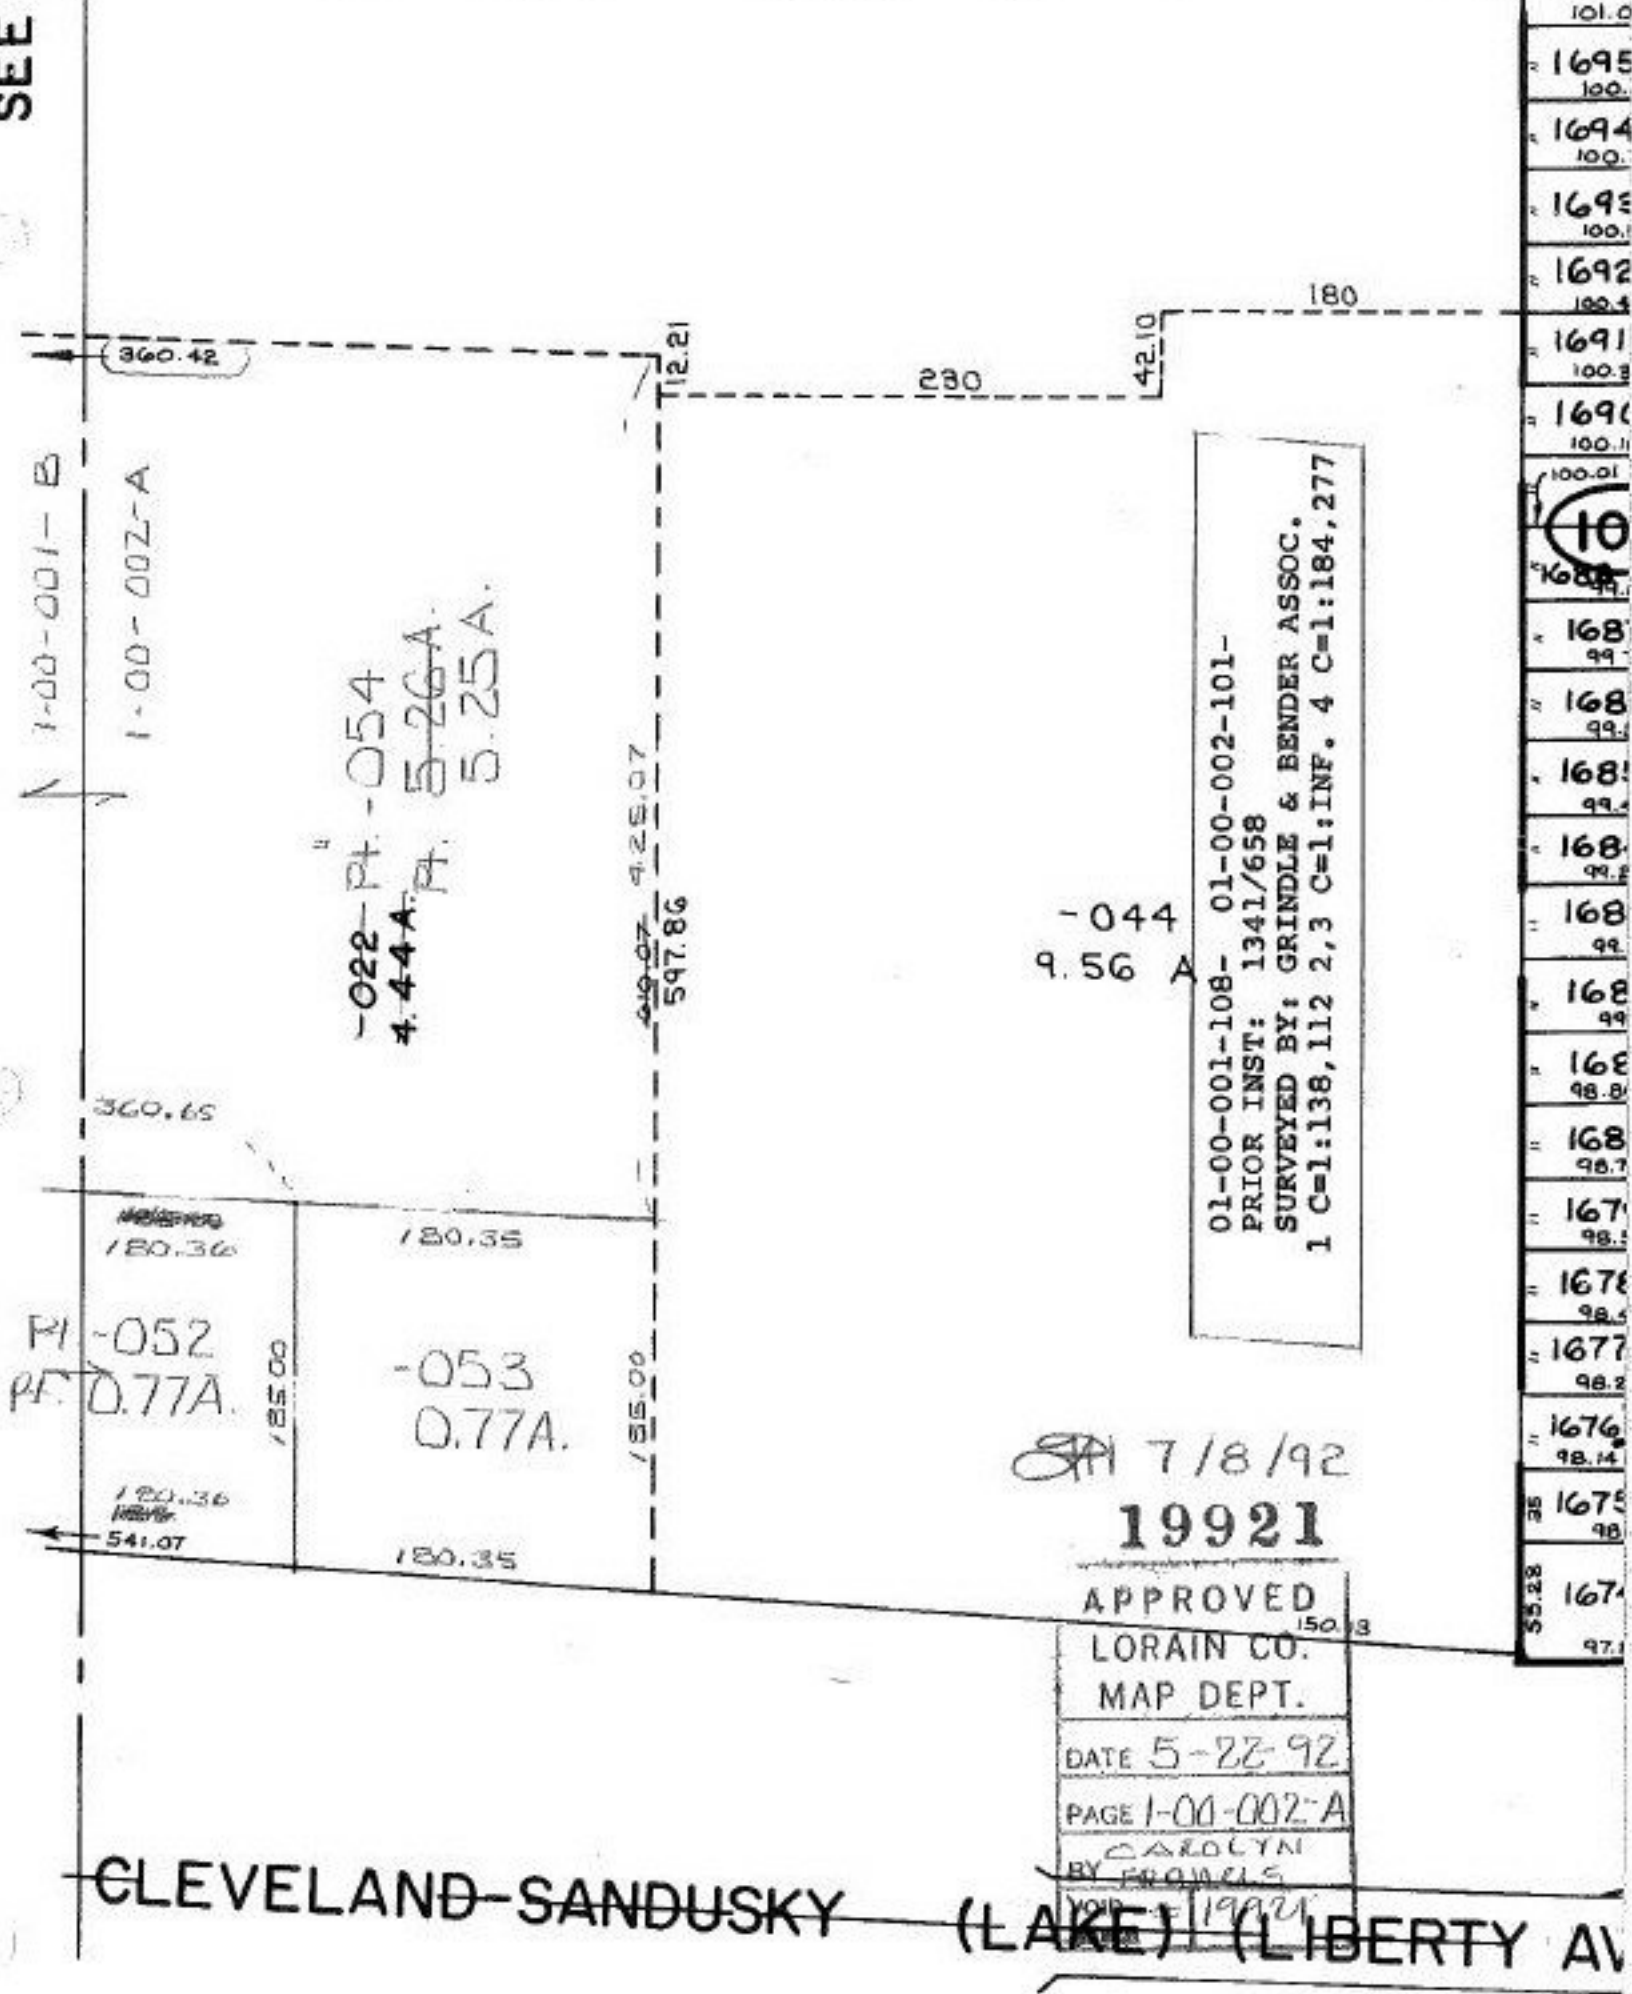

101.0
1695
100.
1694
100.
1693
100.1
1692
100.4
1691
100.2
1690
100.11
100.01
10
1689
1688
99.
1687
99.1
1686
99.4
1685
99.2
1684
99.
1683
99.
1682
98.8
1681
98.7
1680
98.5
1679
98.4
1678
98.2
1677
98.14
1676
98.
1675
98.
1674
97.1

CLEVELAND-SANDUSKY (LAKE) (LIBERTY AV)

SEE 1-00-002-C