

HORSESHOE

BLOCK X

105

DRIVE

BLOCK Y


106

RUN

QUARTER HORSE

HICKORY

WEBSTER

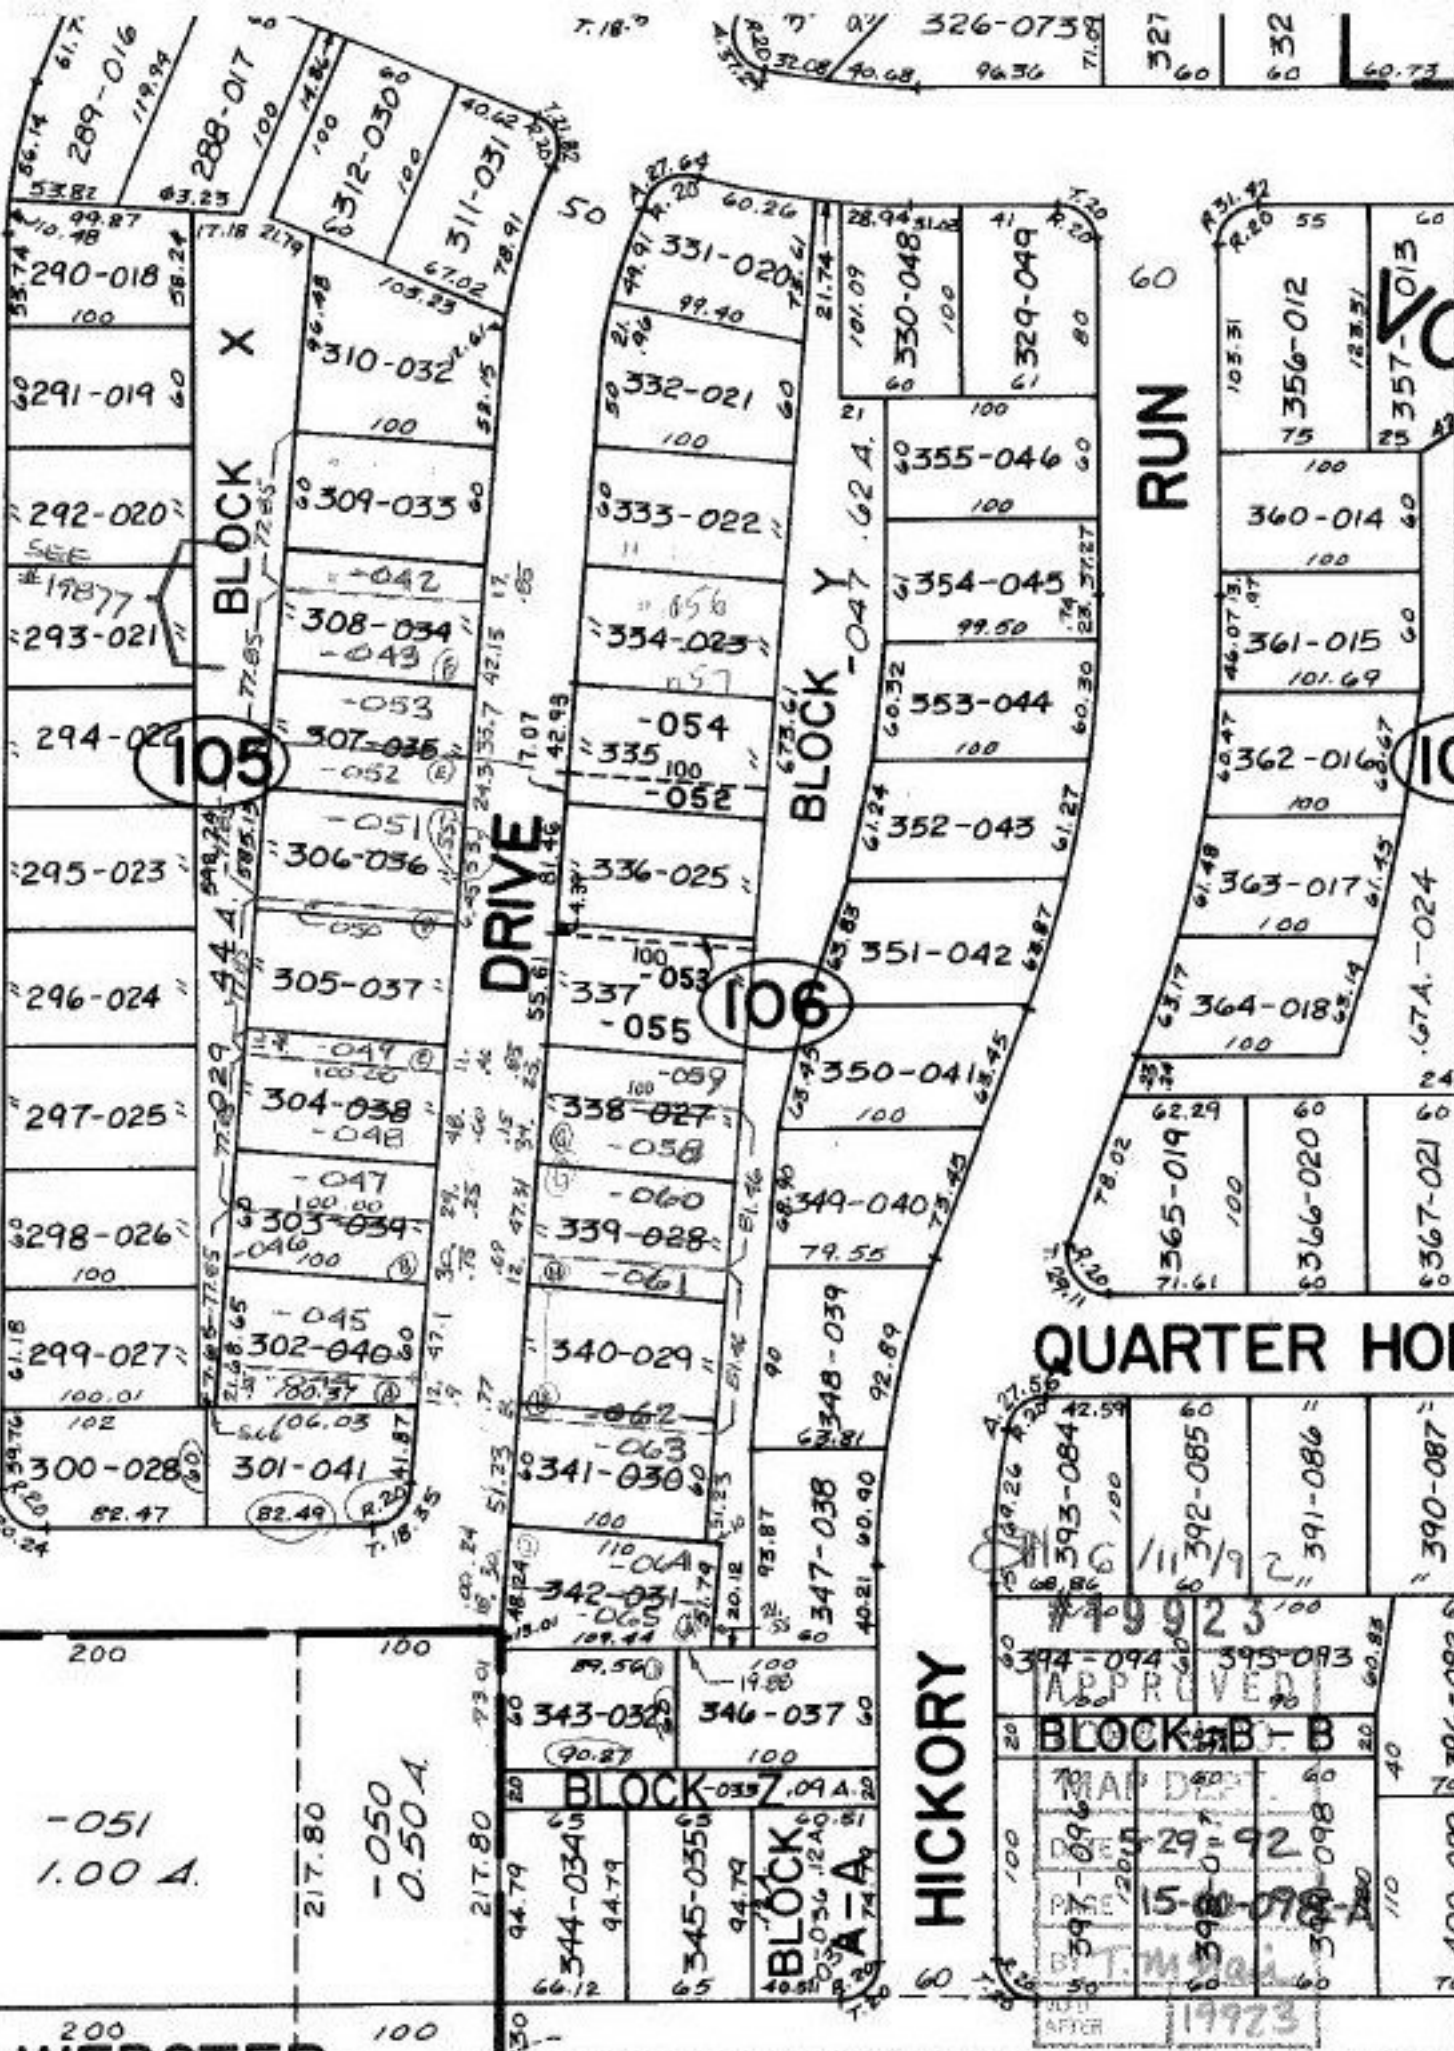

7.18.0
 326-073
 321
 60
 32
 60.73

APPROVED
 BLOCK B-B
 MAN DEPT
 15-0192
 19973