


SEE 15-00-046-A
MAIN

303

CONTRACT

ST.

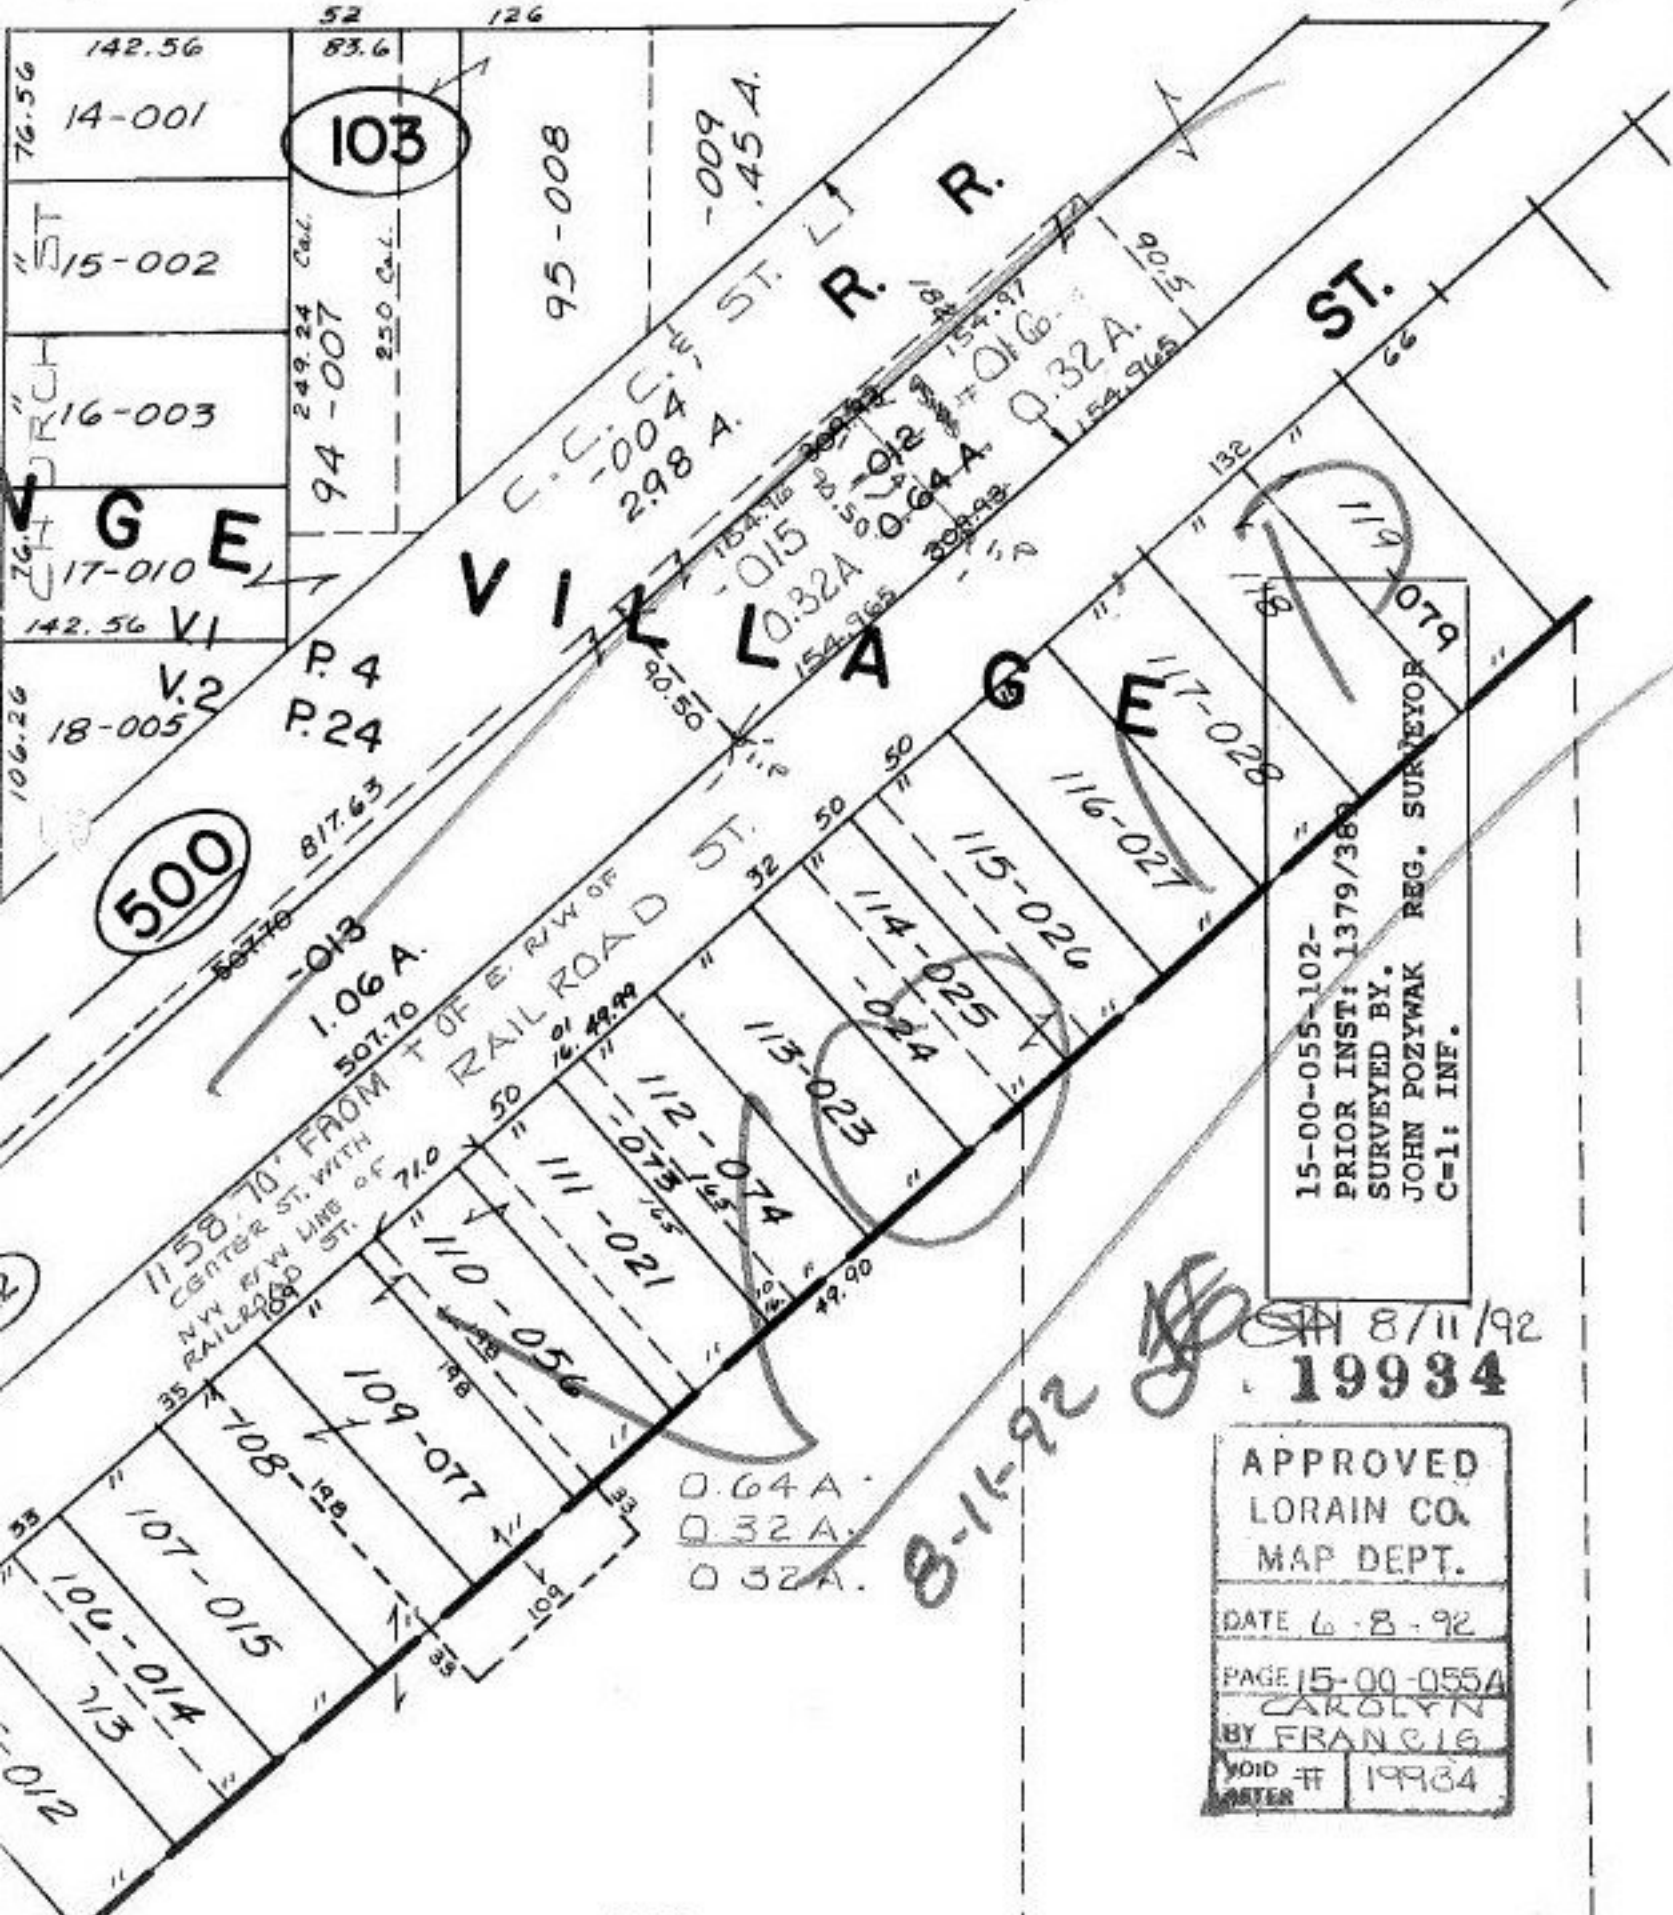

15-00-055-102-
 PRIOR INST: 1379/38
 SURVEYED BY:
 JOHN POZYWAK REG. SURVEYOR
 C=1: INF.

8/11/92
19934

APPROVED
 LORAIN CO.
 MAP DEPT.
 DATE 6-8-92
 PAGE 15-00-055A
 CAROLYN
 BY FRANCIS
 VOID # 19934
 AFTER

8-16-92

0.64 A.
 0.32 A.
 0.32 A.