
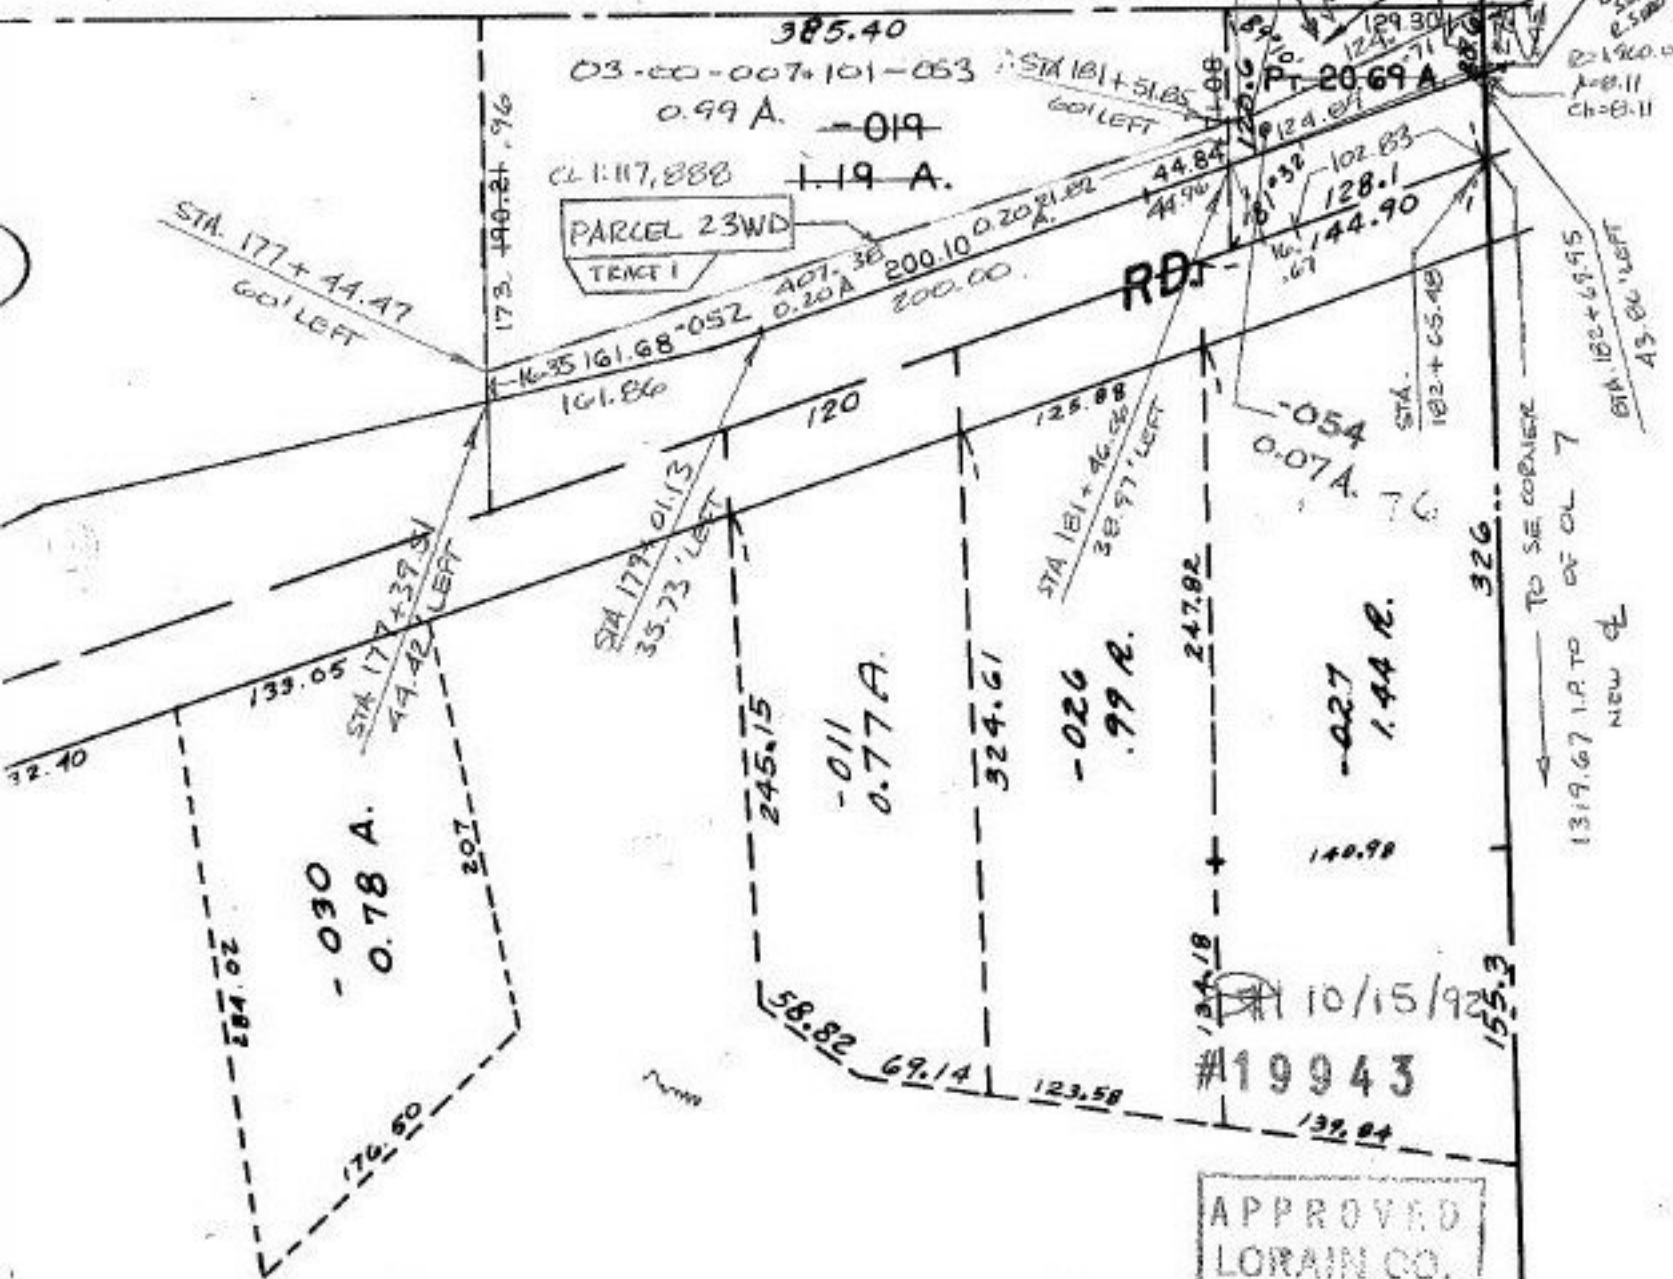
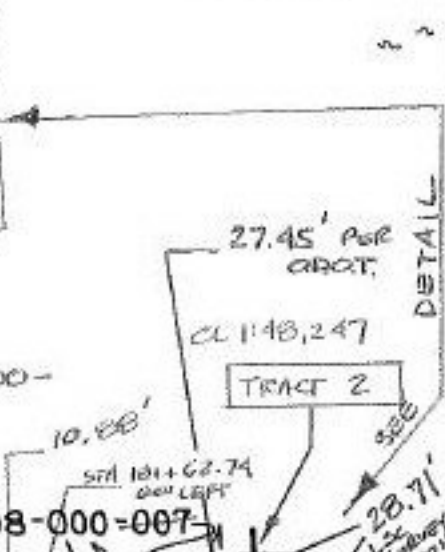


0 - 008 - B

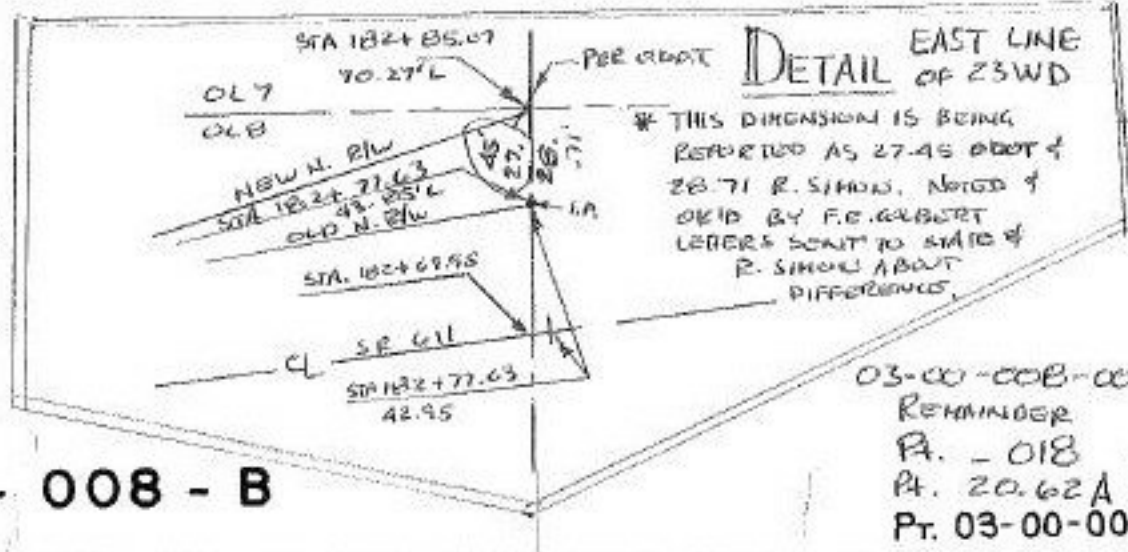

NOTE: PROCESS THIS SPLIT AMOUNT OF #19940 TO KEEP ASSIGNED NUM'S. IN SEQUENCE

SPLIT / INTO COMBINATIONS

Sheet 1/2

COMPLETED 8-27-92

APPROVED	
LORAIN CO.	
MAP DEPT.	
DATE	6-4-92
PAGE 3-00-007-B	
BY T. McNamee	
NO. APPLICANT	19943