


LAFAYETTE

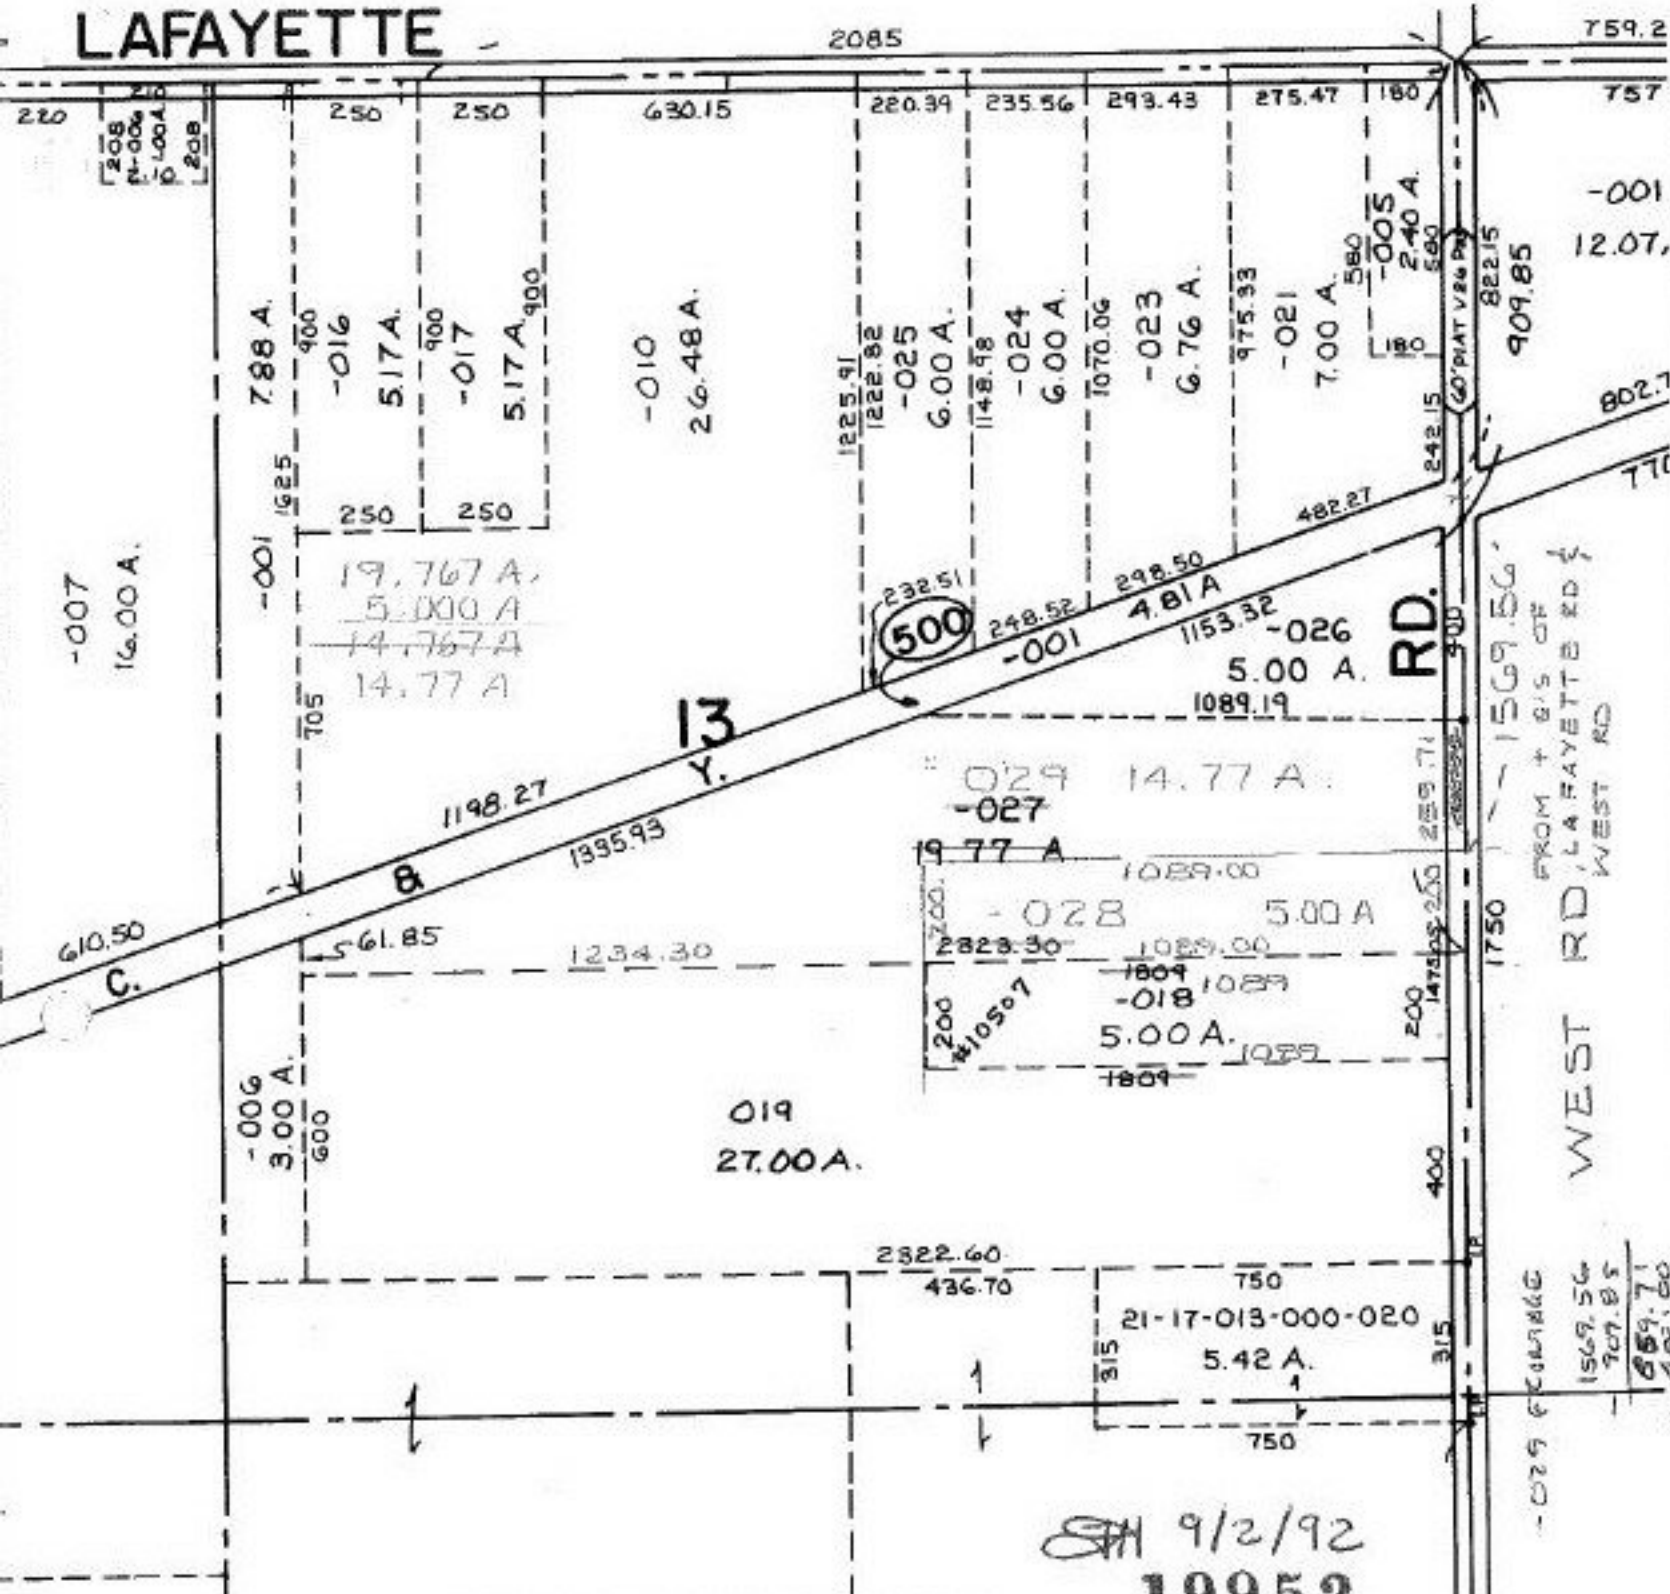

21-17-013-000-
 PRIOR INST: 491/138
 507/797
 SURVEYED BY: LAUNDON, SIMON, CAHL
 C=1: INF. & ASSOC.

9/2/92
19952

APPROVED
 LORAIN CO.
 MAP DEPT.
 DATE 6-12-92
 PAGE 21-H
 BY CAROLYN
 FRANCIS
 VOID AFTER # 19952

-029 EASEMENT
 1569.56
 909.85
 859.71
 400.00
 389.71

1325.69
 1375

03
 0 A.