

SEE 21-F FOR P.


ASHLAND

TRACT

NEW LONDON - EASTERN

1.15 A	1.15 A	-016	2.50 A	D19	2.59 A
0.84 A	0.84 A		0.84 A	16	0.31 A
0.31 A	0.31 A		1.66 A		2.28 A
			-001		
			57.37 A.		

1964.30

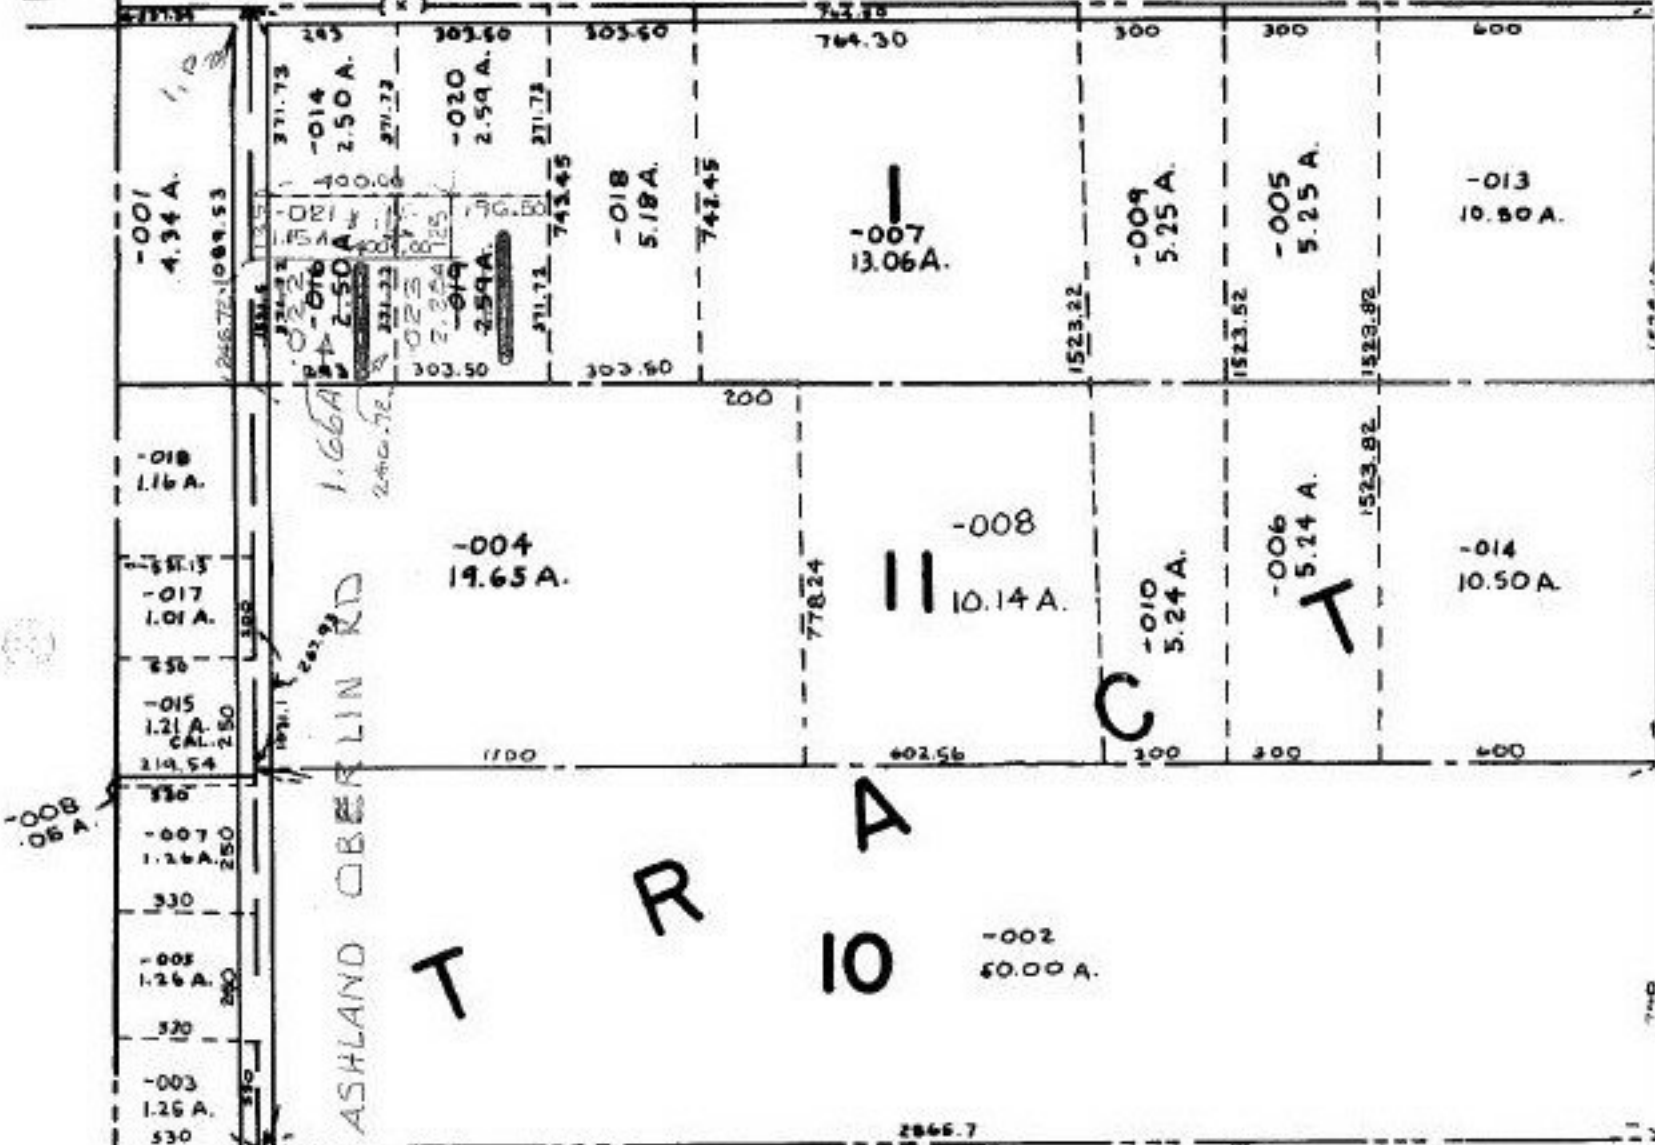

ASHLAND OBERLIN RD

TRACT



21-08-001-000- PRIOR INST: 1362/829
 SURVEYED BY: DOUG MOSLEY REG. SURV.
 C=1: INF.

9/12/92
19953

APPROVED
 LORAIN CO.
 MAP DEPT.
 DATE 6-16-92
 PAGE 21-C
 BY CAROLYN
 FRANCIS
 VOID AFTER # 19953