


#19970

COLLEGE

South Main St

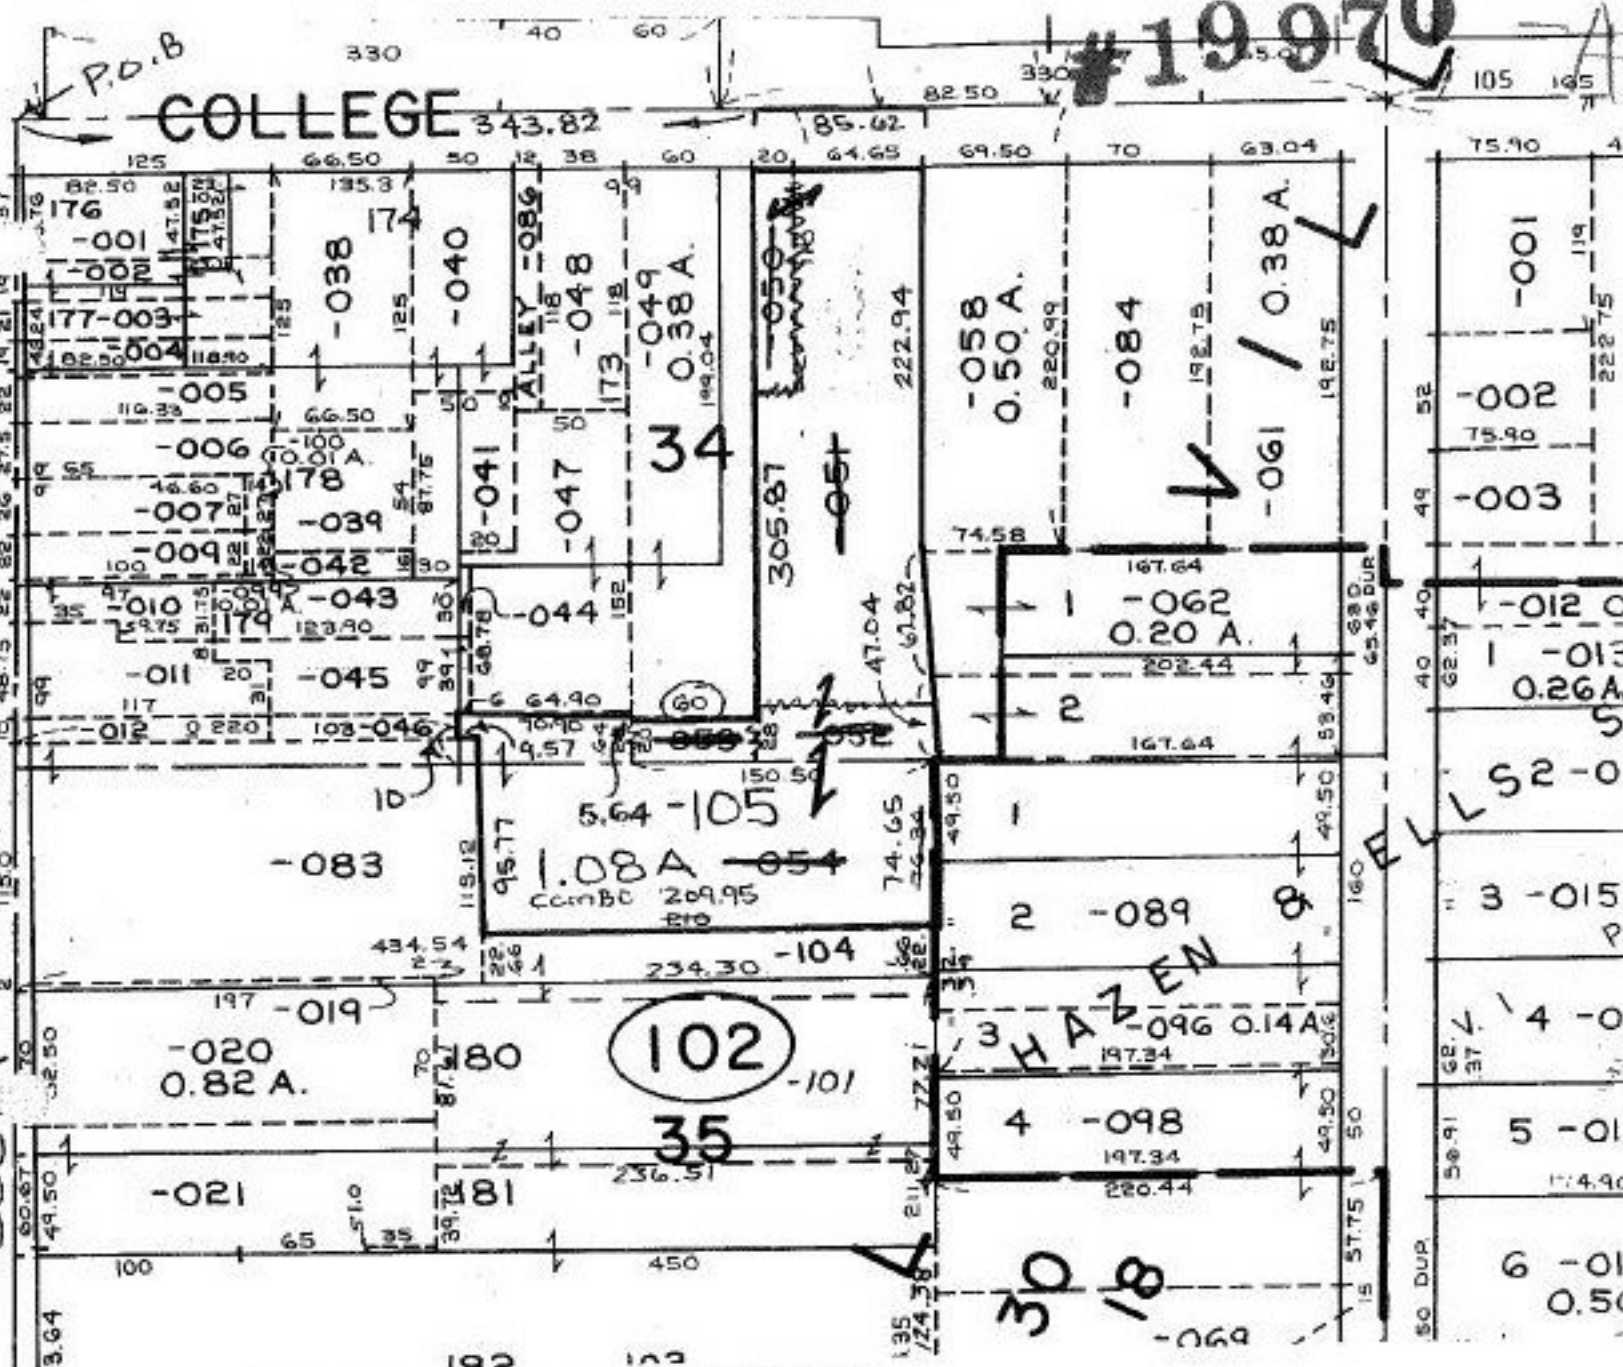

COMBINATION
 PER SURVEY BY
 David L. Elwell
 IN MAY 1992.

#19970-A

APPROVED
 LORAIN CO.
 MAP DEPT.
 DATE 4-30-97
 PAGE 9-00-086A
 BY R BELL
 # 19970-A