


DUP. REG CORR. TAX MAP O.K

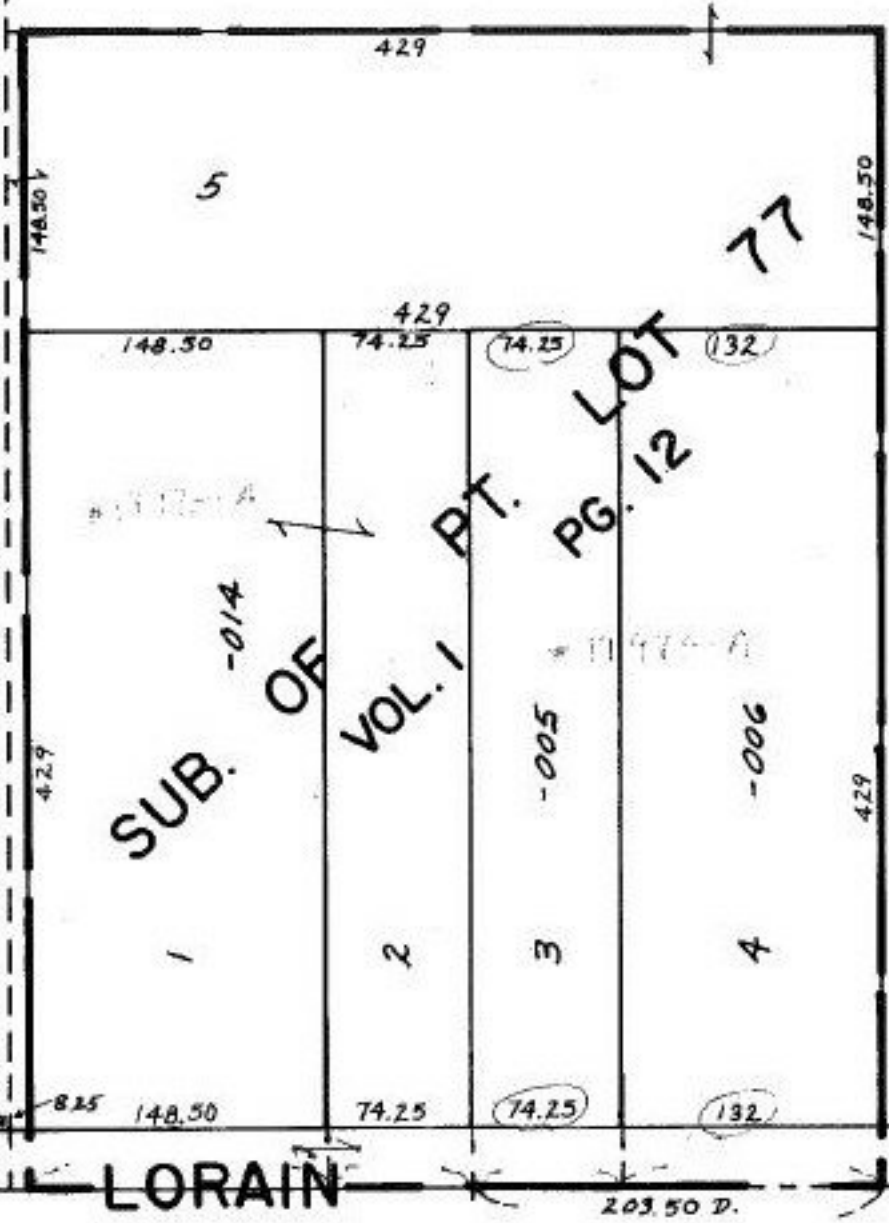

SUB. OF VOL. 1

PT. PG. 12

200
200
299.97
40

CORR.
CORR.
CORR.
CORR.

PROBLEMS PARCELS CORRECTED:	
09-00-077-101-005,006,014	
INST: 005	DEED VOL. 1059/39
006	111
014	1151/306

SEE 9-00-087

SM 11/9/92

19978-A

APPROVED
LORAIN CO.
MAP DEPT.

DATE 10-27-92

PAGE 9-00-077-A

CAROLYN
BY FRANCIS

VOID
AFTER # 19978