


SEE 2-02-014-A

140  
60 - 022  
60 .19A.  
140

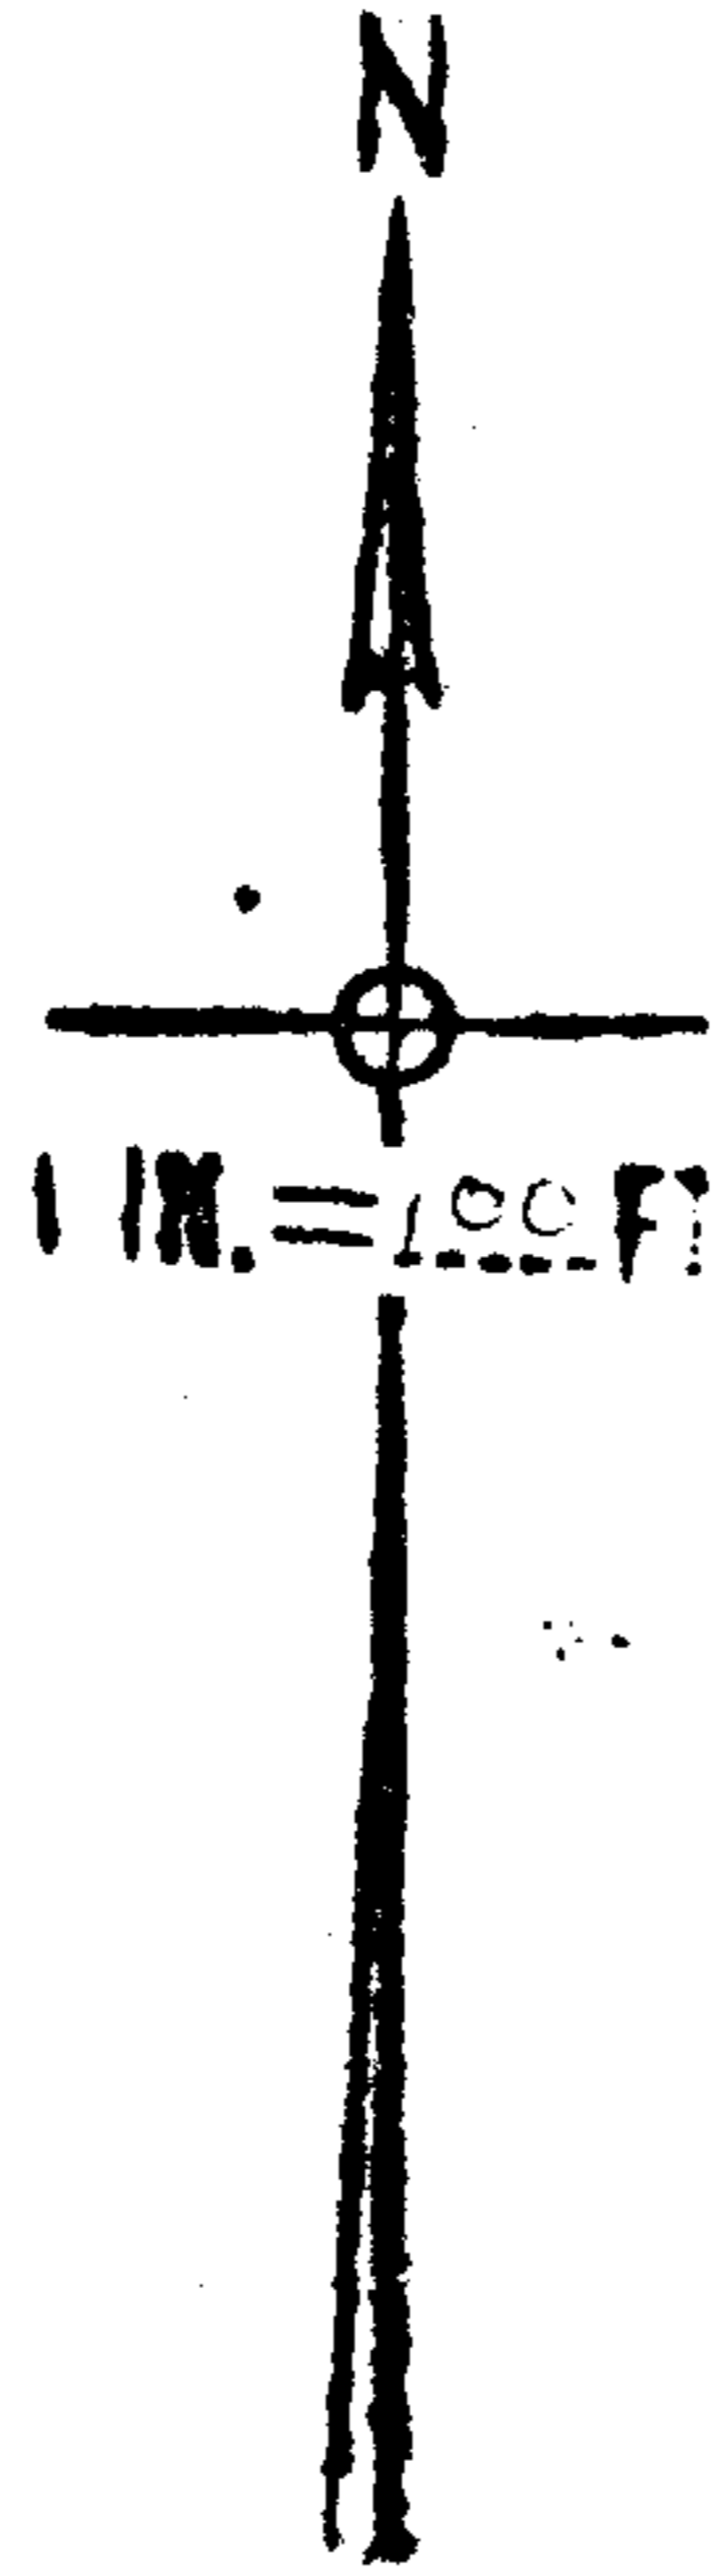

1998

7-14-86 S.S.

APPROVED
LORAIN CO.
MAP DEPT.
DATE 8-2-68
2-02-007-A
BY <i>R. K.</i>



~~-019~~      -023  
~~29.43A.~~    29.24A.

9/23/68  
R.K.