


ADD TO DUPLICATE
-060
0.13 Ac. (CALC.)

Black

WEST

RD.

LOW WATER MARK

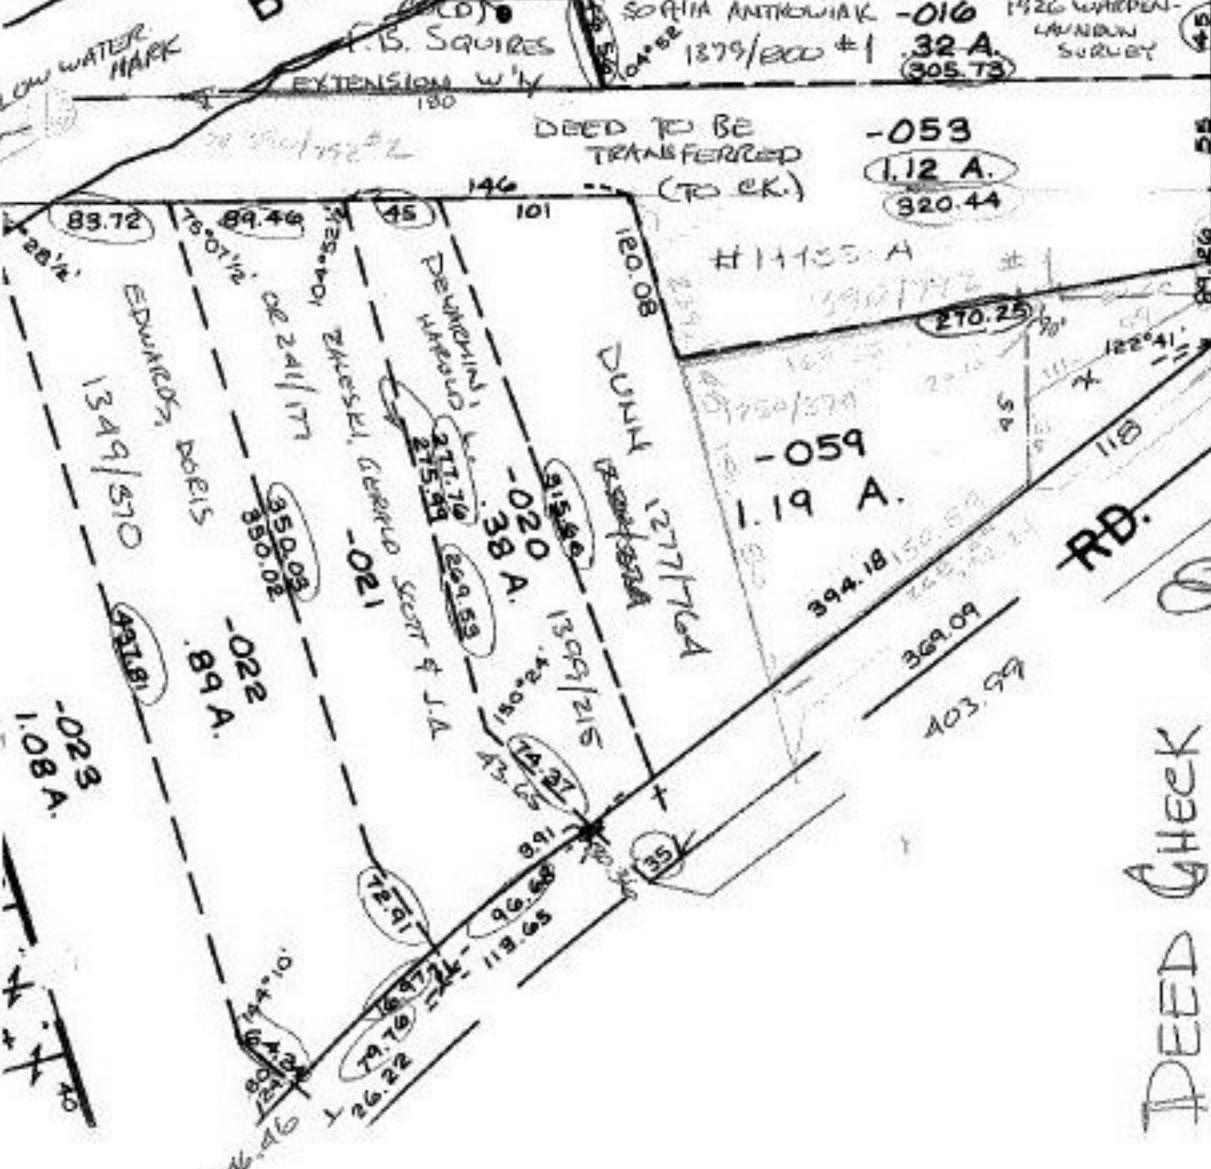

8/17/92
#19985-A

APPROVED
LORAIN CO.
MAP DEPT.

DATE 7-10-92

PAGE 10-00-003 e

BY T. McMain

VOID AFTER 19985-A

DEED CHECK