


SEE 2-03-006-

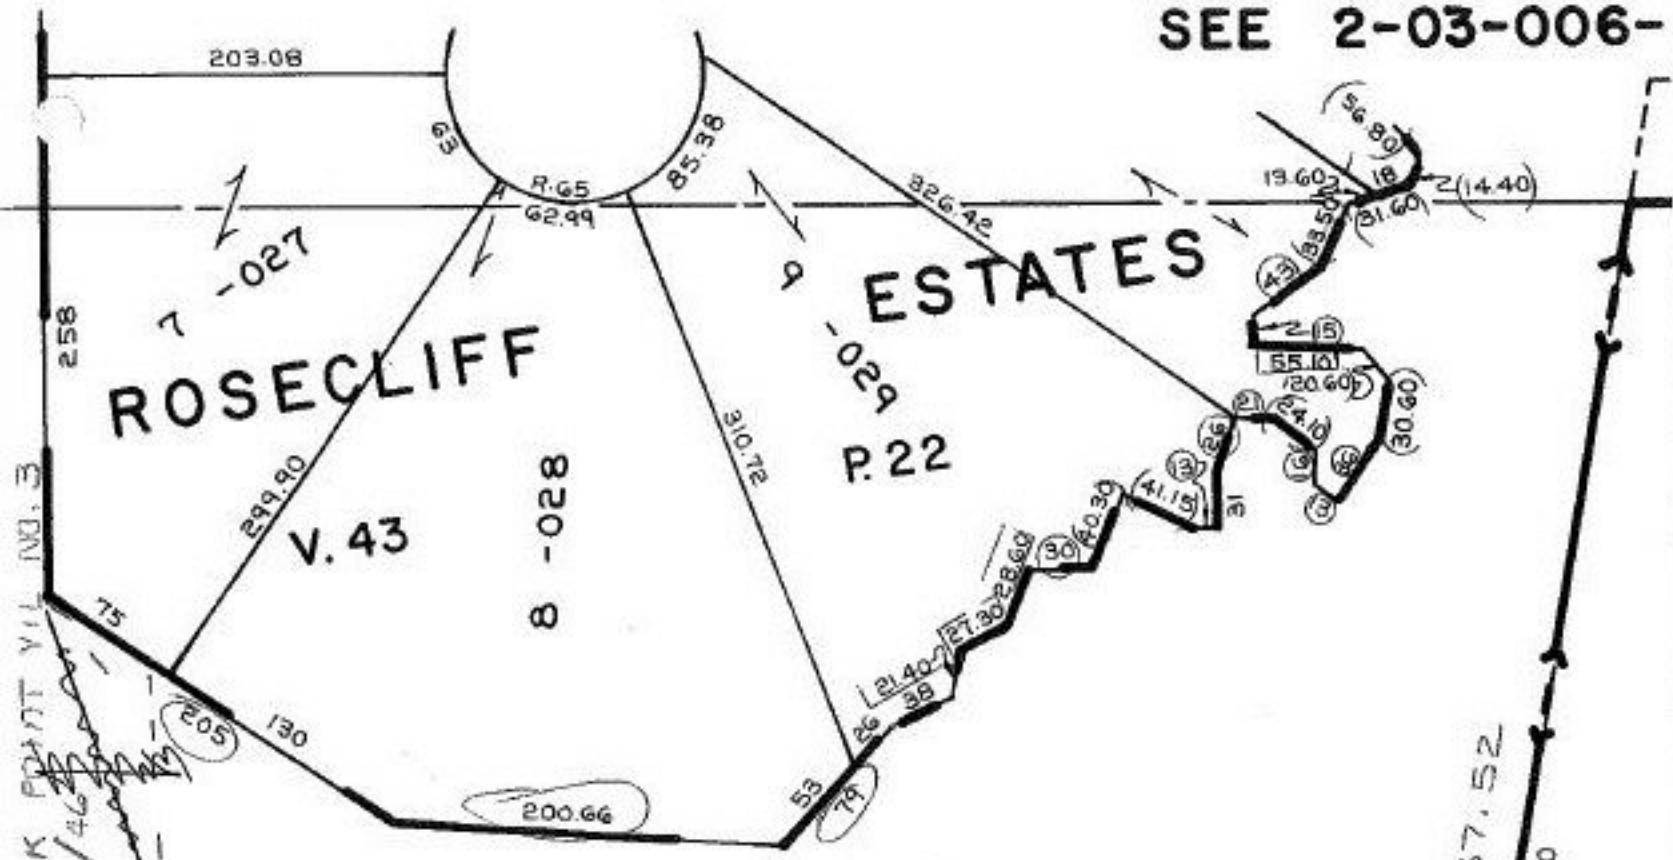

OAK POINT VIL. INC. 3  
47/46

~~Pt - 106~~  
~~- 104~~

~~Pt. - 069~~  
~~Pt. 19.38 A.~~

~~+ 2.47 A~~  
~~Pt. 15.26 A~~

12.85 A PER DEED

LORAIN CITY  
AMHERST CITY

7/20/92  
19988

APPROVED
LORAIN CO.
MAINT. DEPT.
1986 ±
DATE 7-7-92
PAGE 5-00-020-B
CAROLYN
BY FRANCIS
VOID # 19988
AFTER

05-00-020-000- PRIOR INST: \_\_\_\_\_  
PT. OF COMBINATION OF 003, & 104

667.45

75  
85  
182.54  
41.58  
69.04  
45.95

5297.70

2418