


COMBINE - 003
- 015

0.75 A
0.19 A
0.94 A

COMBINATION DEED
DV. 0. R 540 / 421
FILED 5-15-92

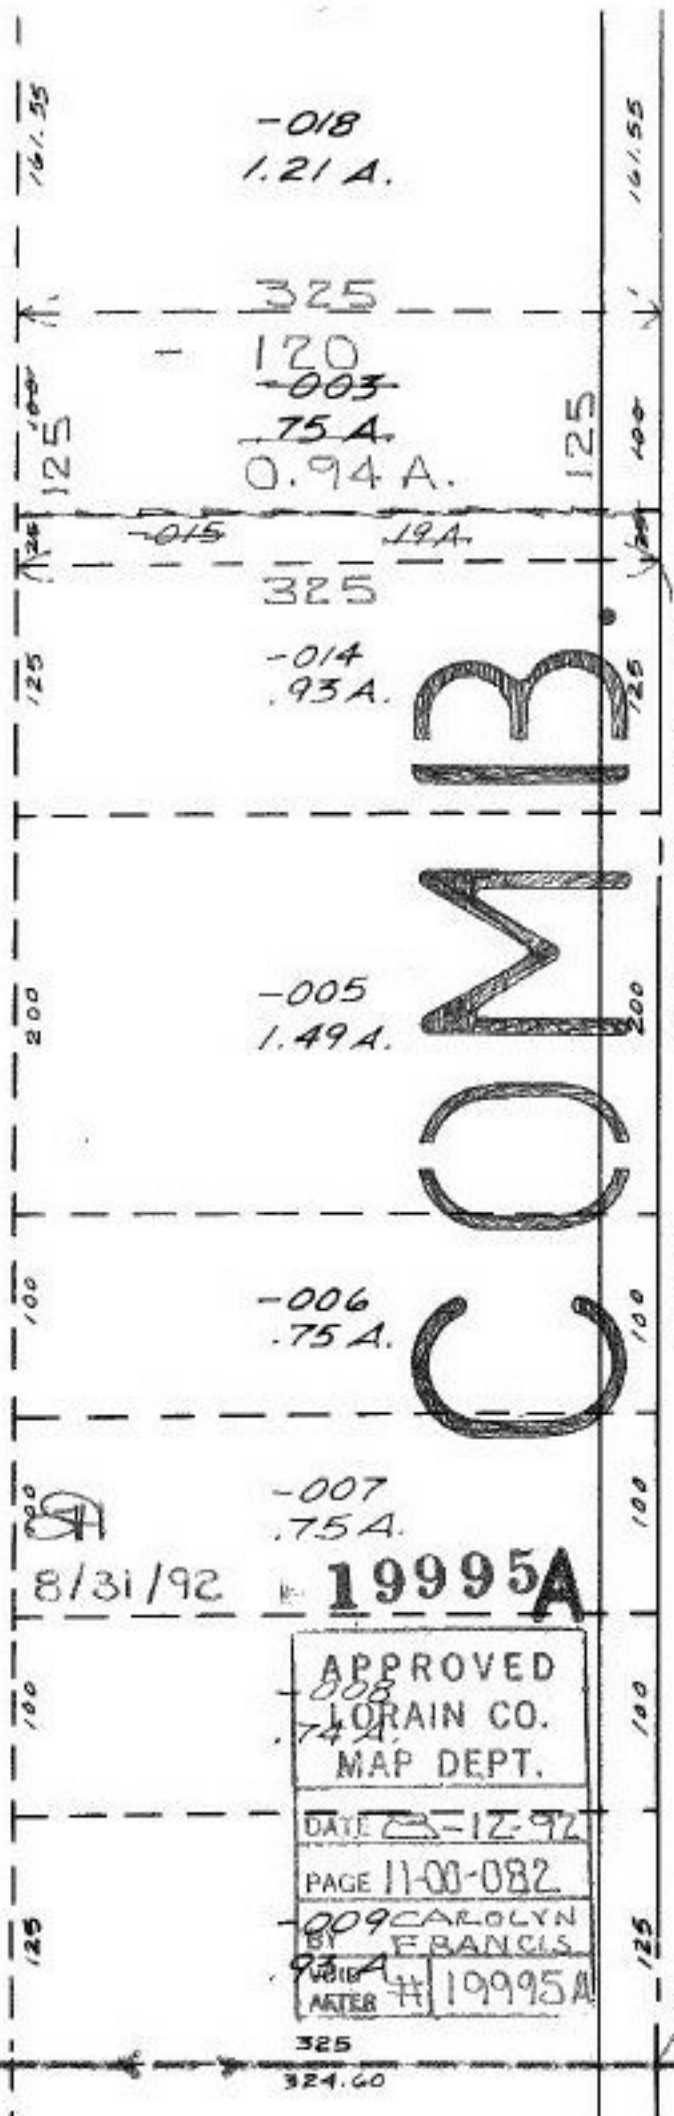

SEE RD. 11-00-079-A

750
DURKEE

APPROVED
008 LORAIN CO.
74 A. MAP DEPT.
DATE 8-12-92
PAGE 11-00-082
009 CAROLYN
BY FRANCIS
93 A
MAP # 19995A

325
324.60