

SEE 9-00-085-B

ST.

ST.


60



MILTON

SEE MAP 9-E AT BOTTOM

(600)-001
16x16
Pt. 09-00-103-000-018

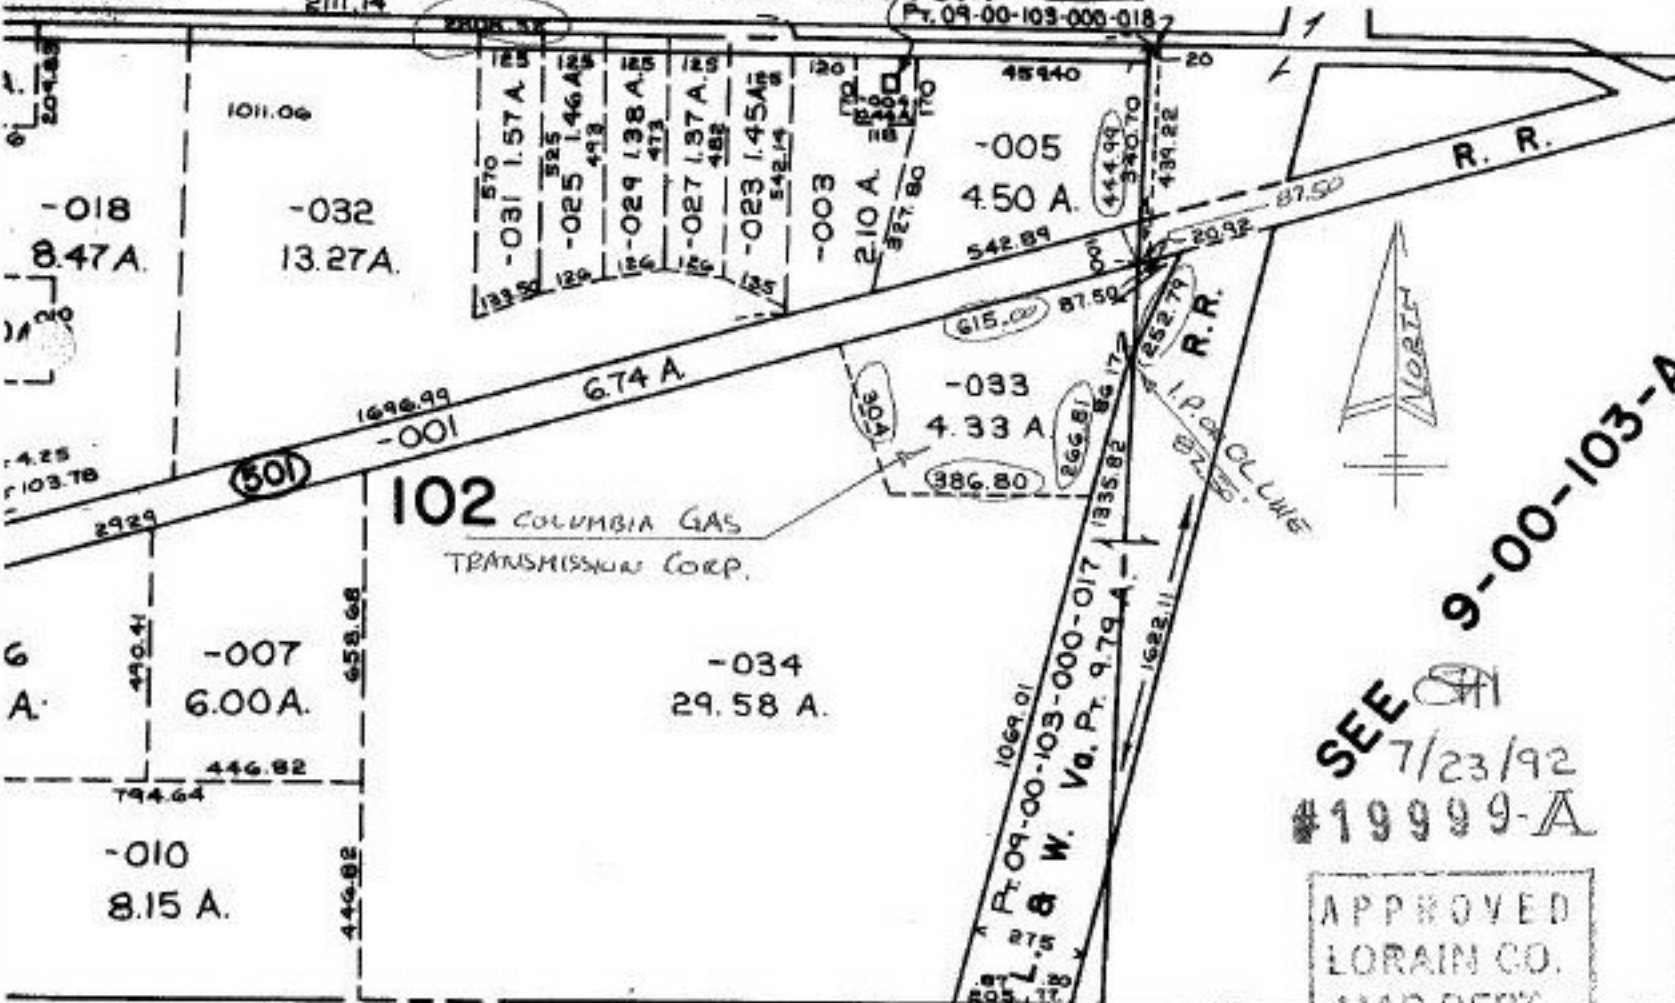

SEE 9-00-103-A

7/23/92
#19999-A

APPROVED
LORAIN CO.
MAP DEPT.

DATE 7-14-92

PAGE 9-F

BY T. McMan

VOID AFTER 19999-A