
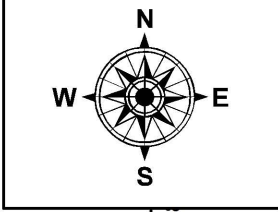


PARENT PARCEL: 11-00-045-000-053

CHILD PARCEL: 11-00-045-000-059 & -060

STARTING POINT: I.P. MON. BOX, CL OF WOOSTER AVON LAKE RD. (S.R. 83) & N.W. CORNER OF O.L. 45

20-00766

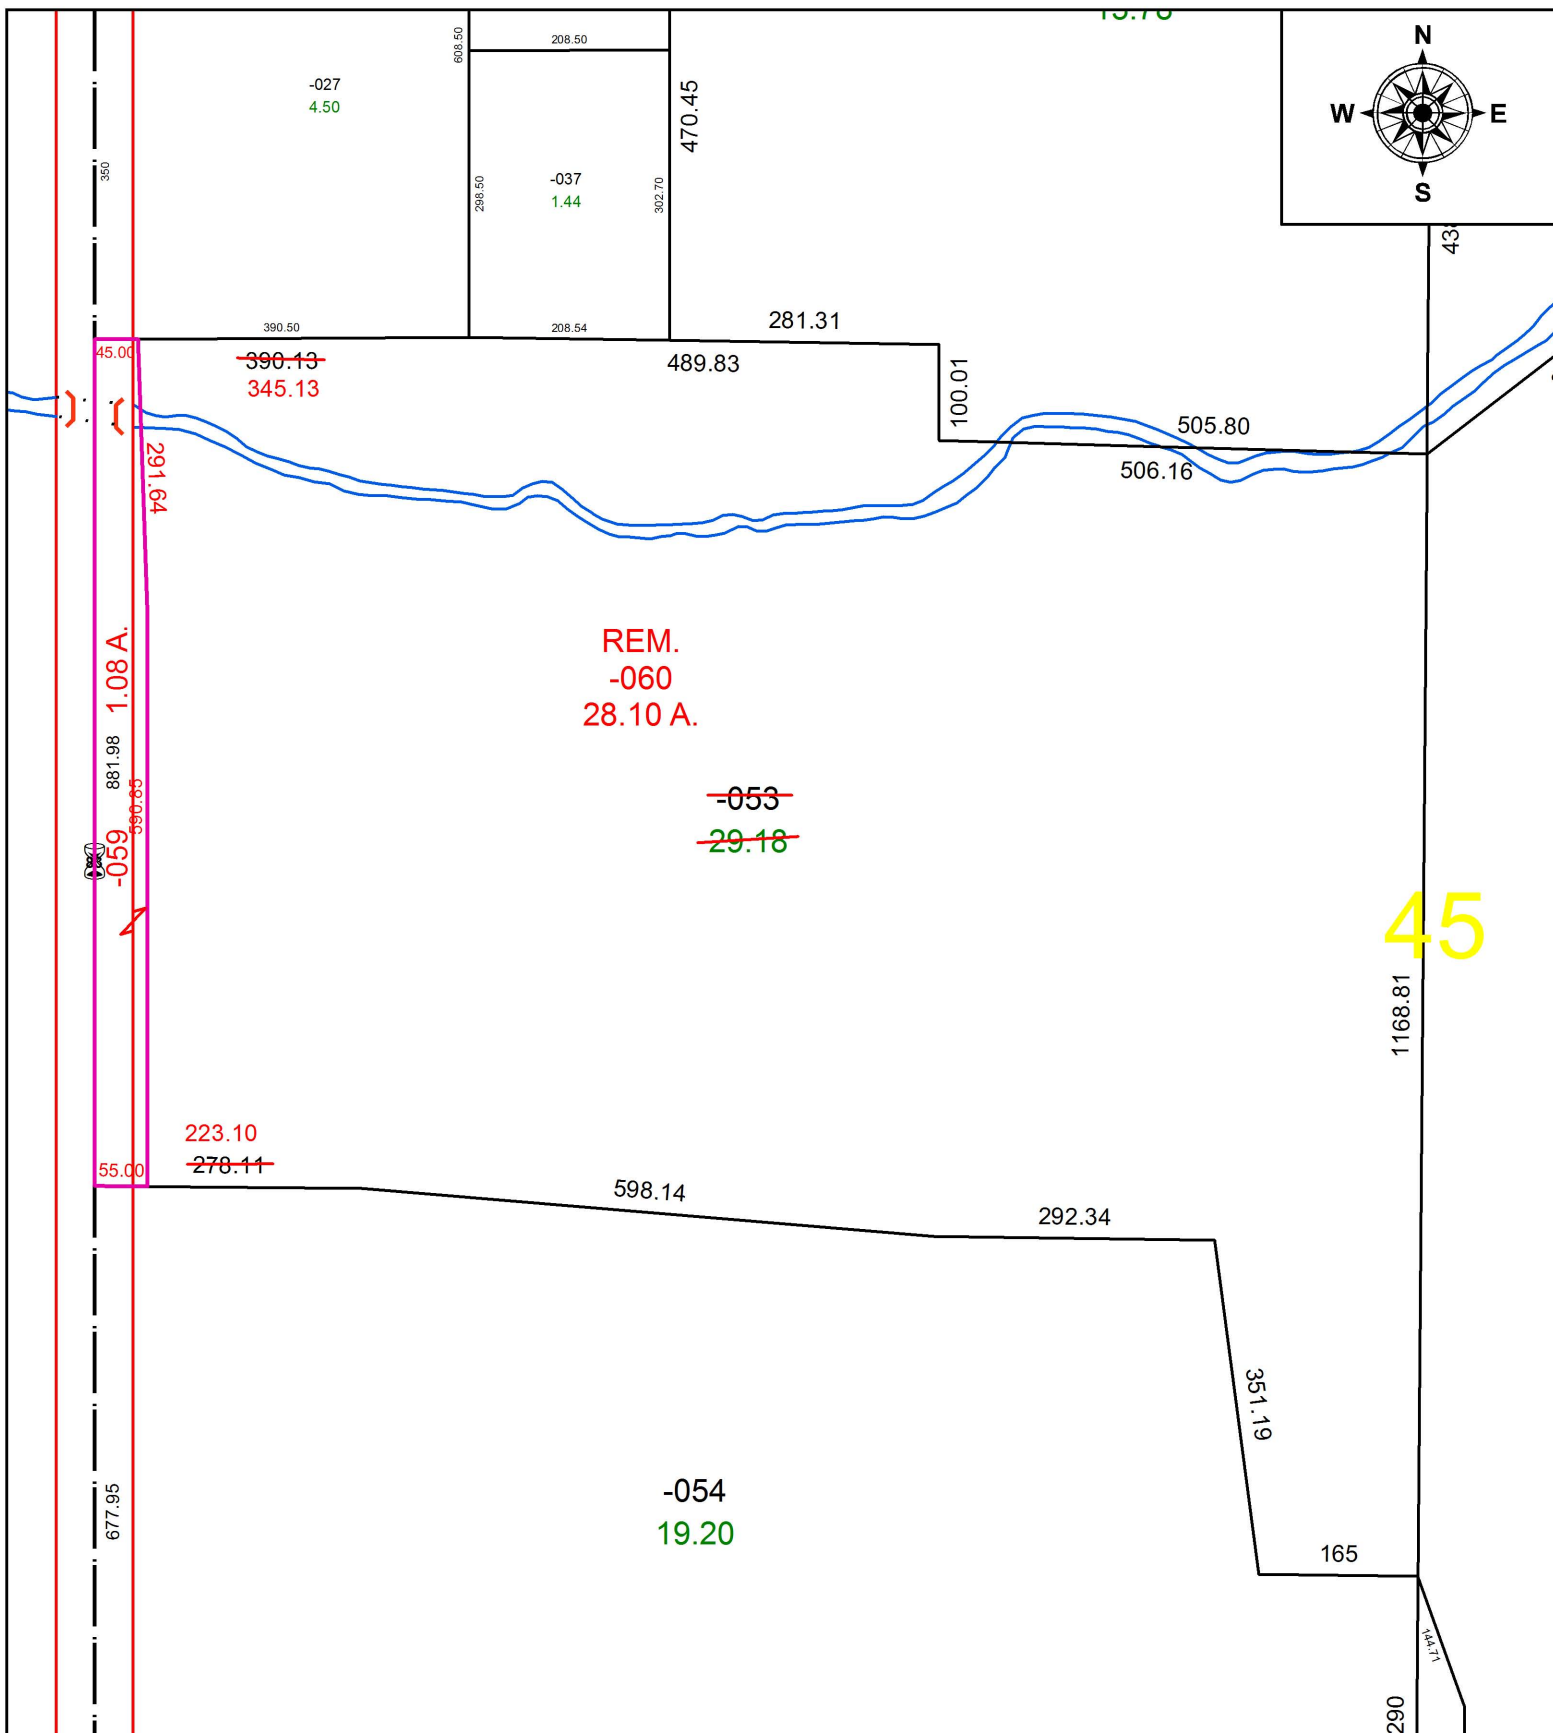

45


REM.  
-060  
28.10 A.

~~-053~~  
~~29.18~~

-054  
19.20

223.10  
~~278.11~~

~~390.13~~  
345.13

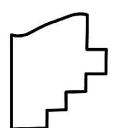

**SPLITS/DEEDS PROCESSED**  
 LORAIN COUNTY TAX MAP DEPARTMENT  
 226 MIDDLE AVE. ELYRIA, OH

SURVEYED BY: ANDREW G. PLANET  
 CLOSURE: 1: 100,000  
 MAP PAGE(S): 11-00-045  
 APPROVED BY: TJS DATE: 6/30/2020  
 SCALE: 1" = 200 PRIOR INSTRUMENT: 2018-0688718