
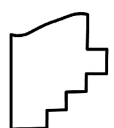


PARENT PARCEL: 08-00-087-000-015, -016

CHILD PARCEL: 08-00-087-000-028 THRU -031

STARTING POINT: INTERSECTION OF C/L OF S.R.113 AND C/L OF BAUMHART RD.

20-00771

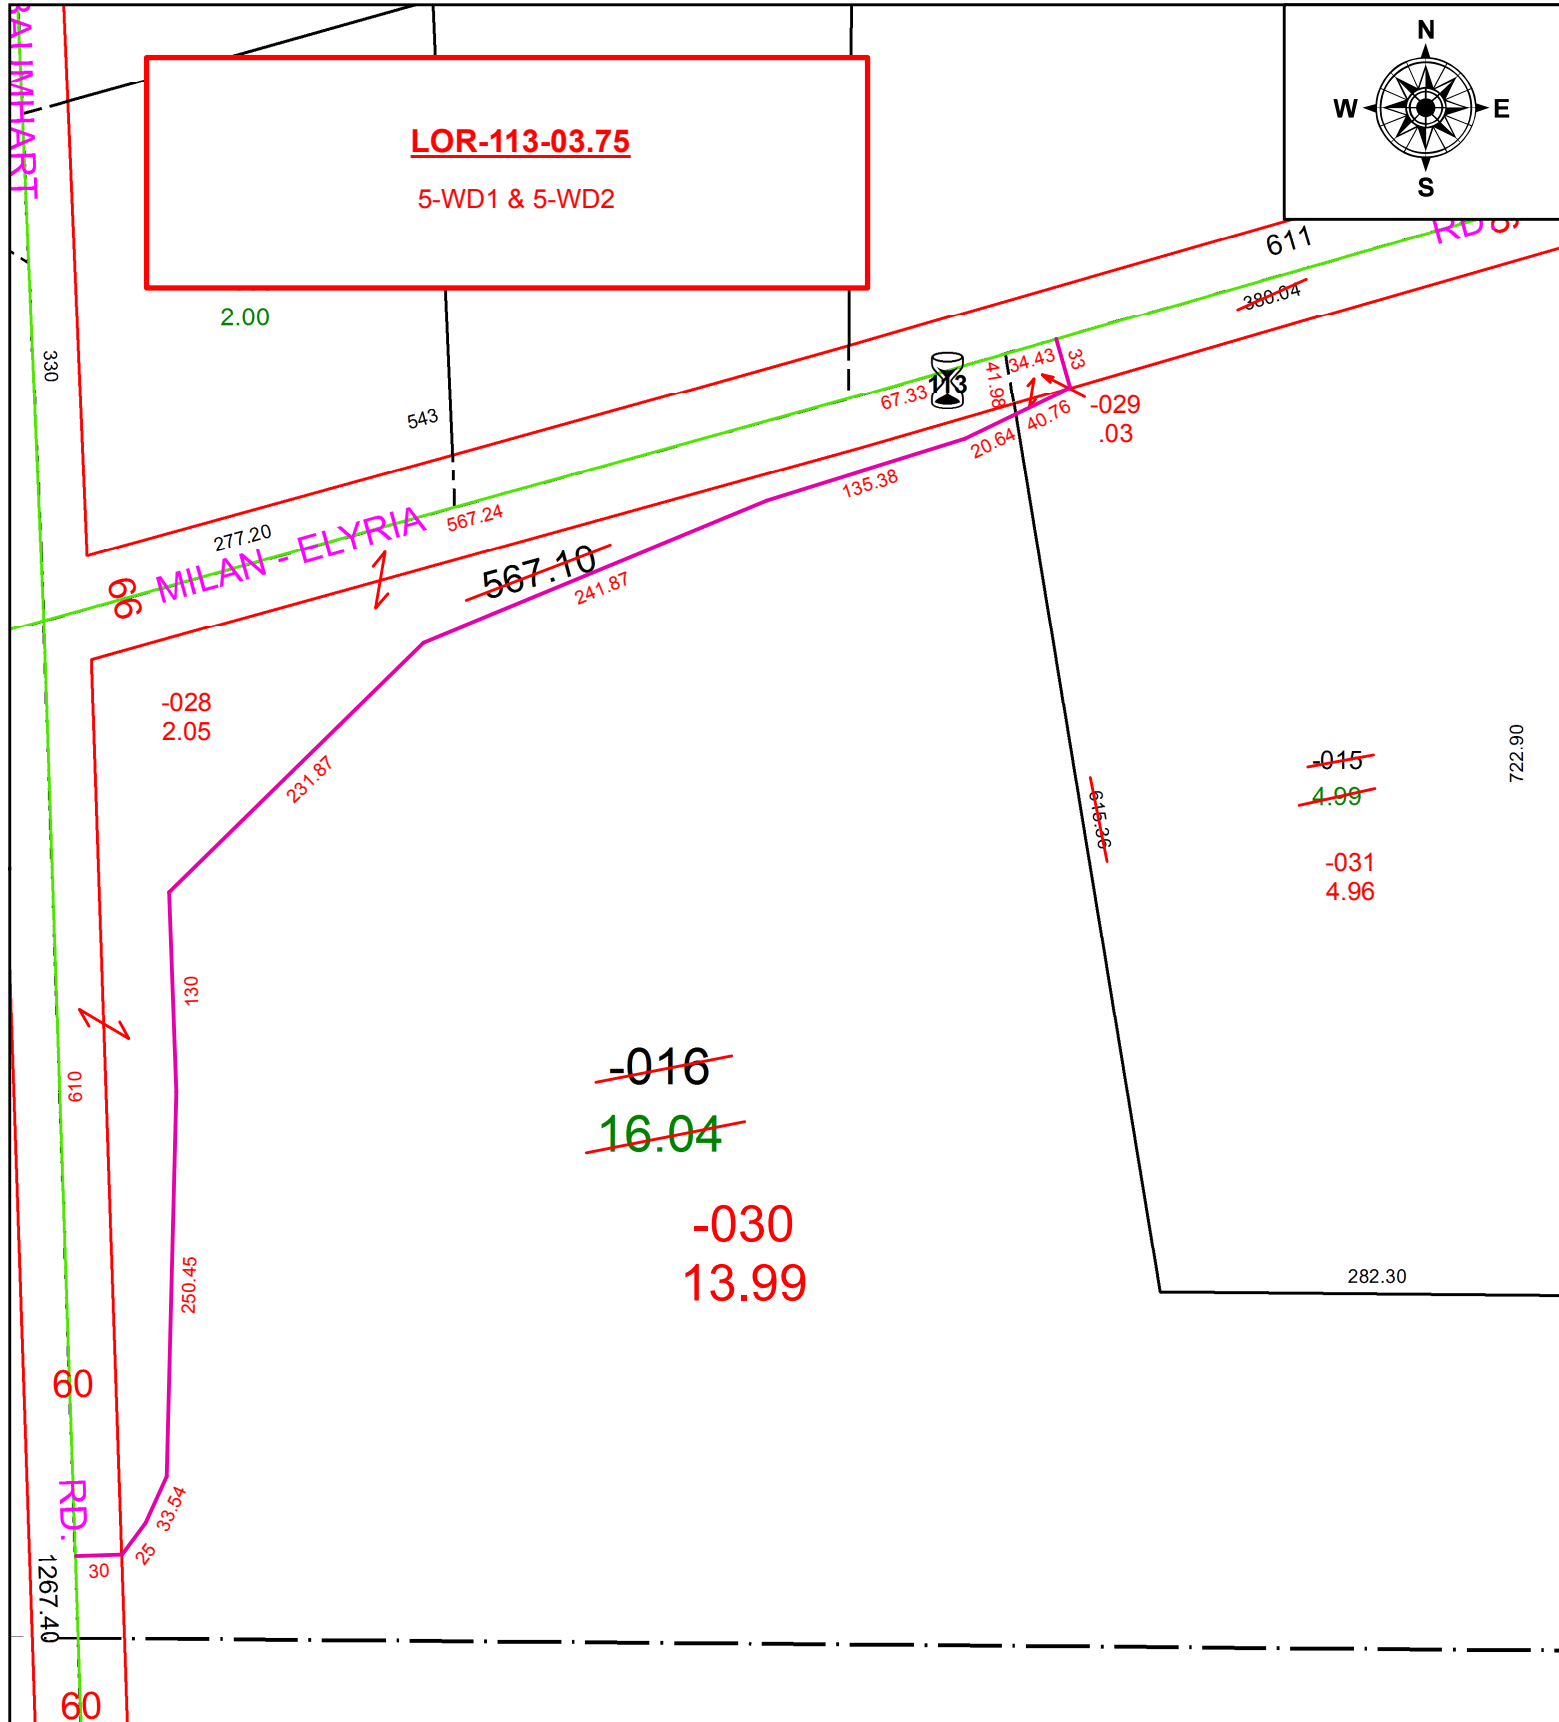

SPLITS/DEEDS PROCESSED
 LORAIN COUNTY TAX MAP DEPARTMENT
 226 MIDDLE AVE. ELYRIA, OH

SURVEYED BY: JEFFREY M. BAIRD
 CLOSURE: 1:494,201
 MAP PAGE(S): 8-00-087
 APPROVED BY: RRM DATE: 7-7-20
 SCALE: 1" = 125 PRIOR INSTRUMENT: 20190726437