


PARENT PARCEL: 03-00-046-104-010


CHILD PARCEL: 03-00-046-104-017, 03-00-047-110-021

STARTING POINT: S/L 63 IN COLLAR DAY ALLOT.

20-04368-U

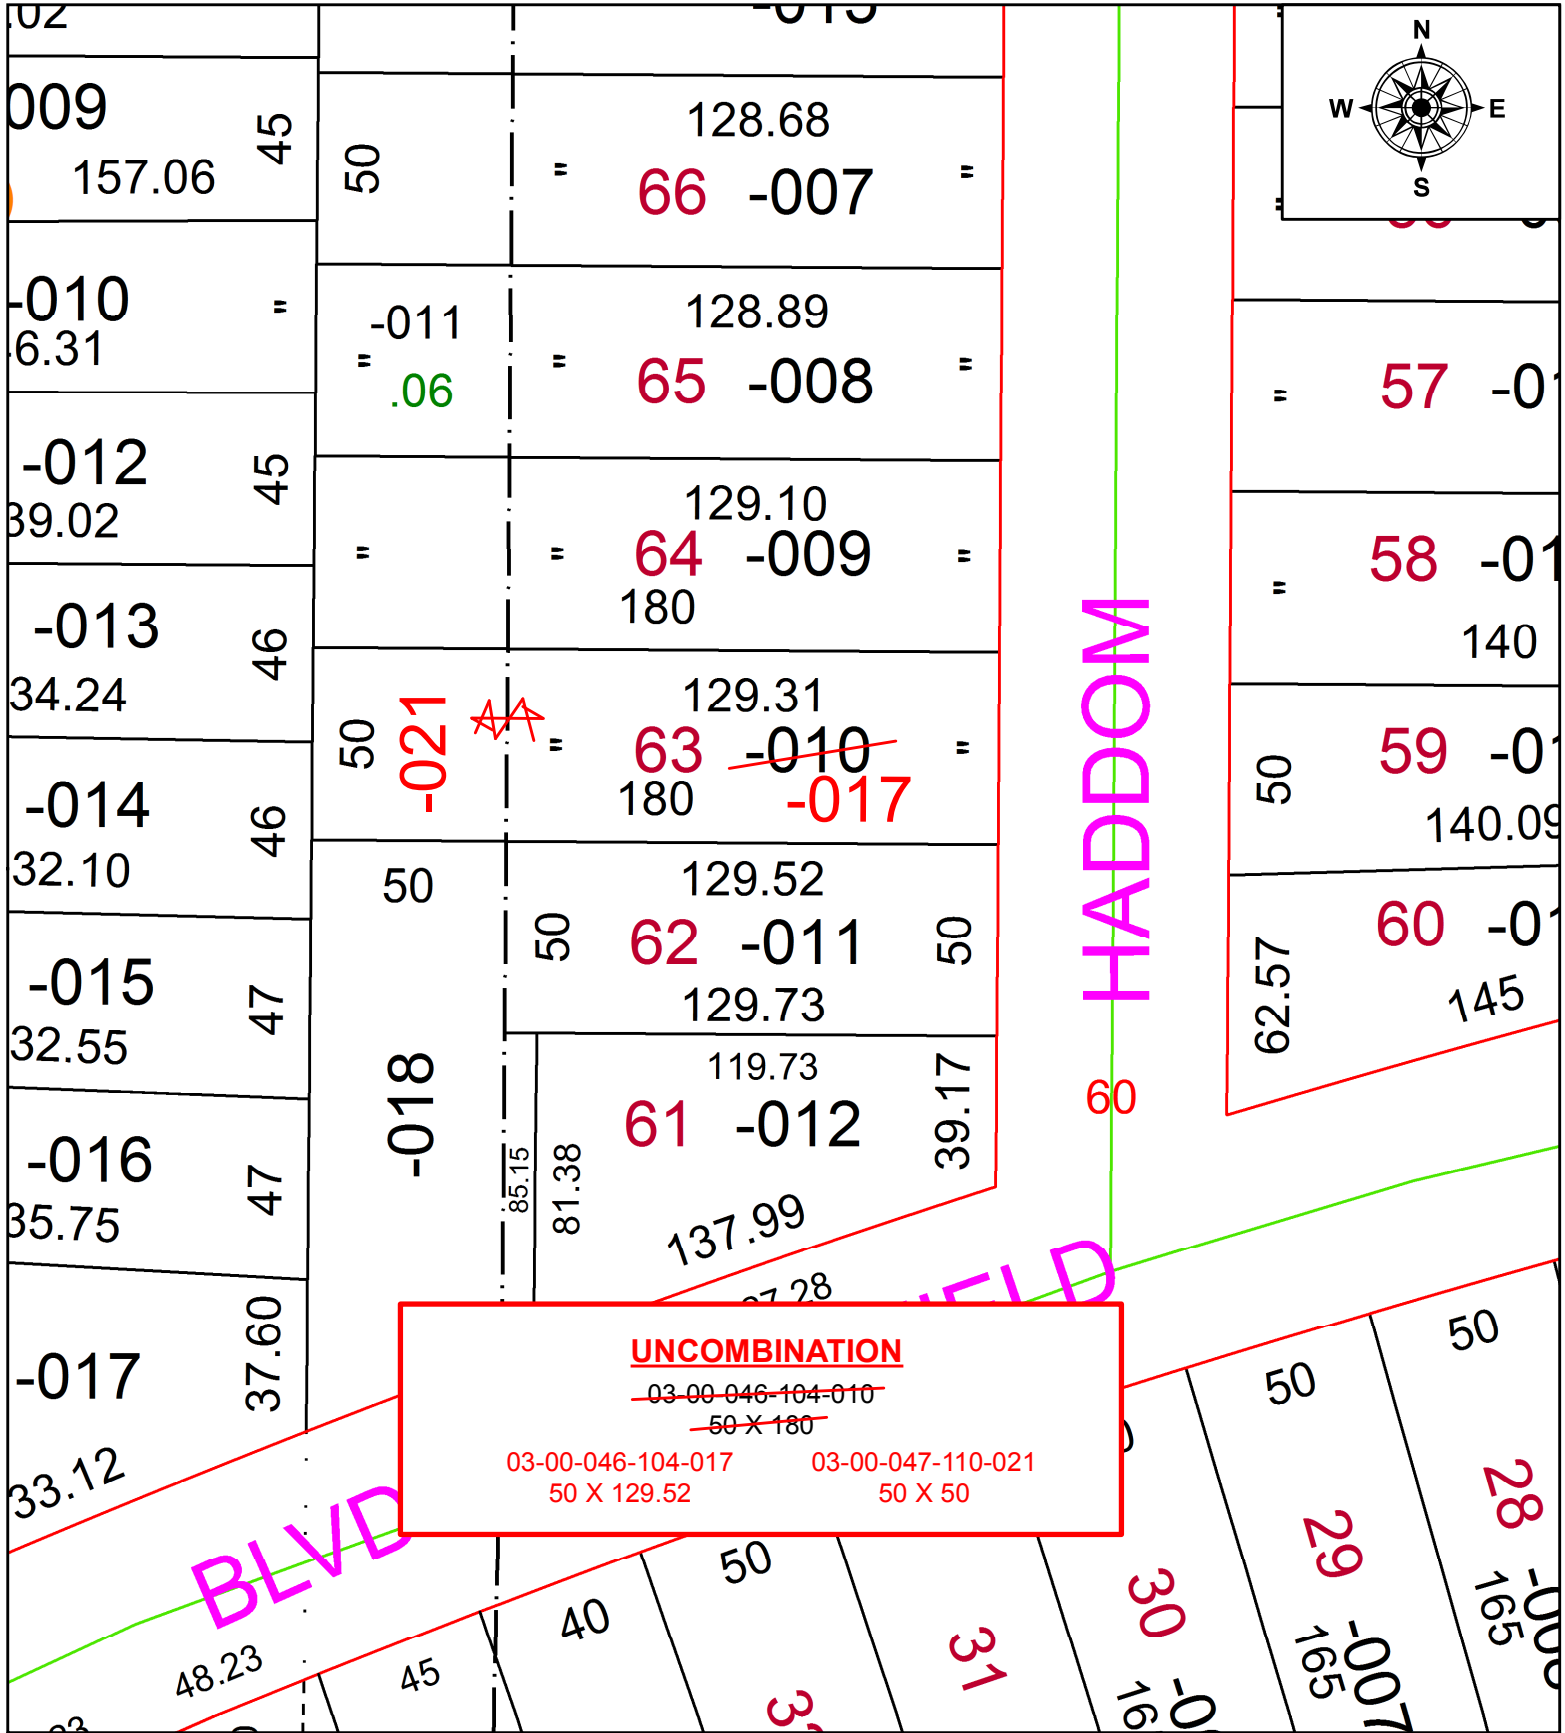

UNCOMBINATION
~~03-00-046-104-010~~
~~50 X 180~~
 03-00-046-104-017 03-00-047-110-021
 50 X 129.52 50 X 50

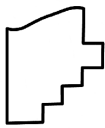

SPLITS/DEEDS PROCESSED
 LORAIN COUNTY TAX MAP DEPARTMENT
 226 MIDDLE AVE. ELYRIA, OH

SURVEYED BY: N/A
 CLOSURE: N/A
 MAP PAGE(S): 3-00-046
 APPROVED BY: RRM DATE: 7-15-20
 SCALE: 1" = 50' PRIOR INSTRUMENT: 20130478380