


SEE 7-00-0

315.3

1041.34

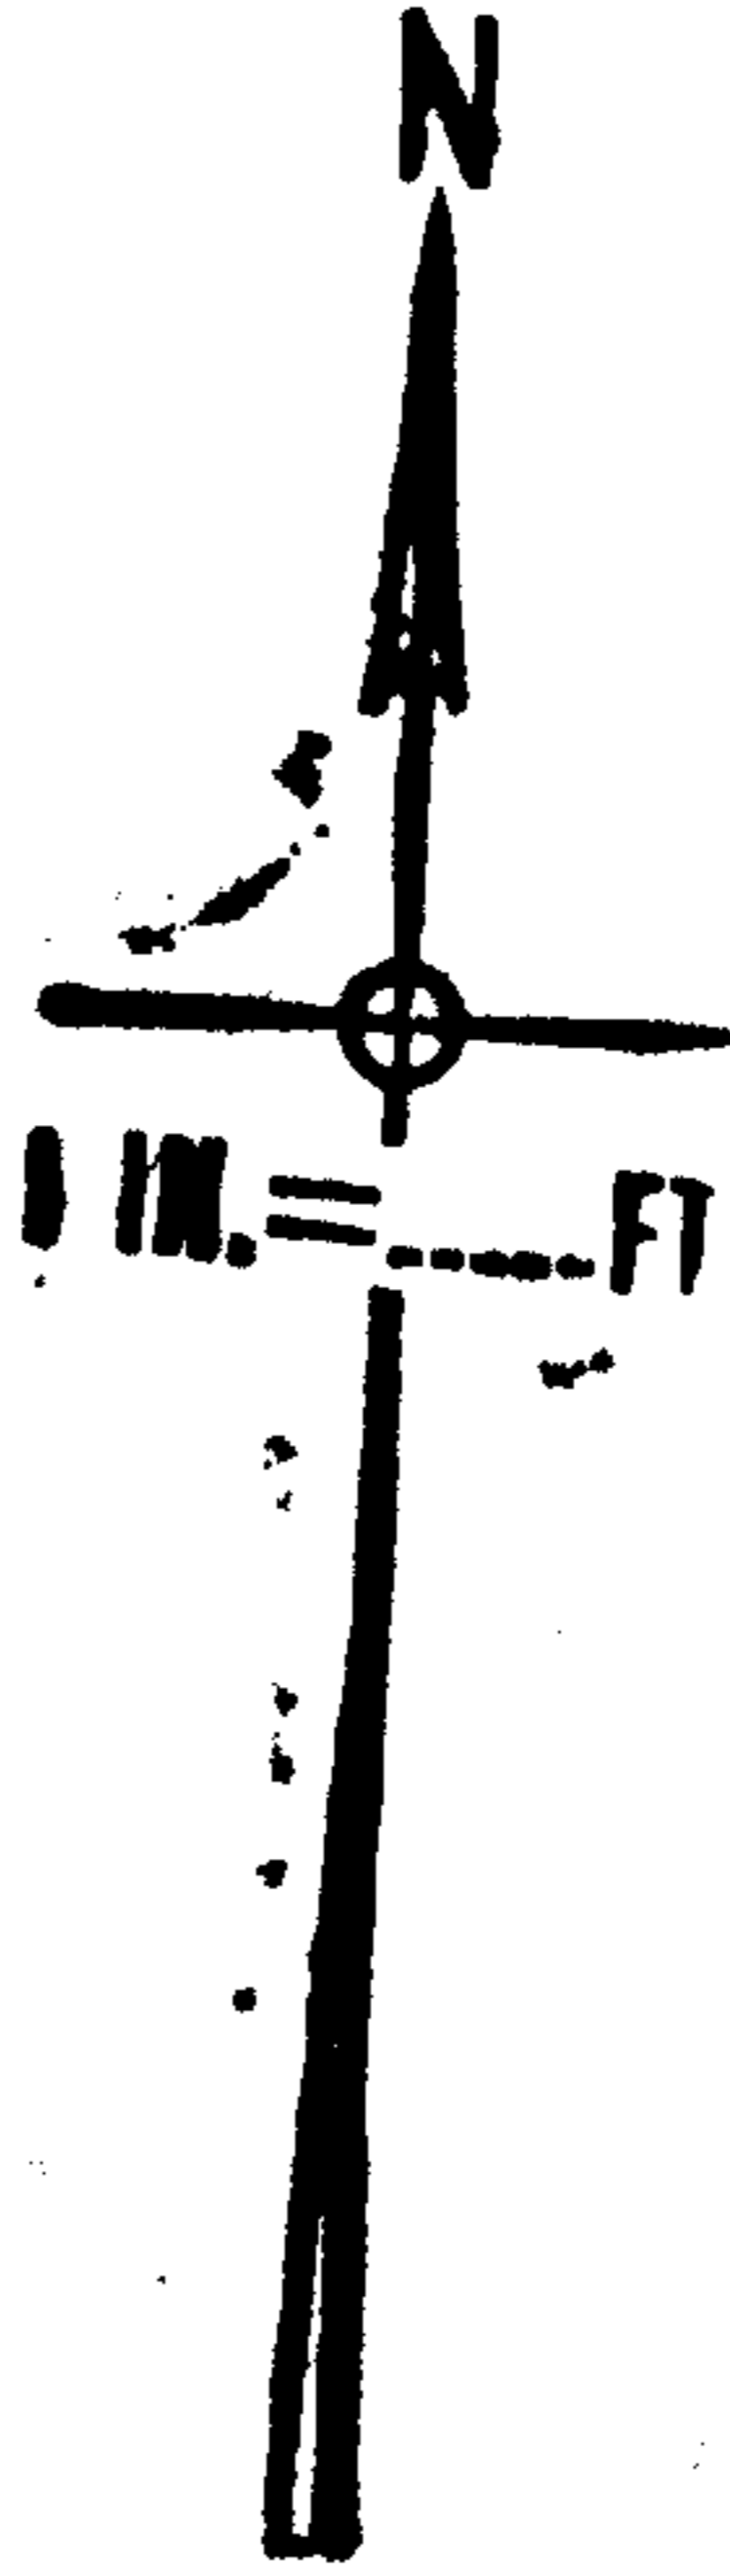


-059

PT - 001

PT. 2250A.

17.44 A.

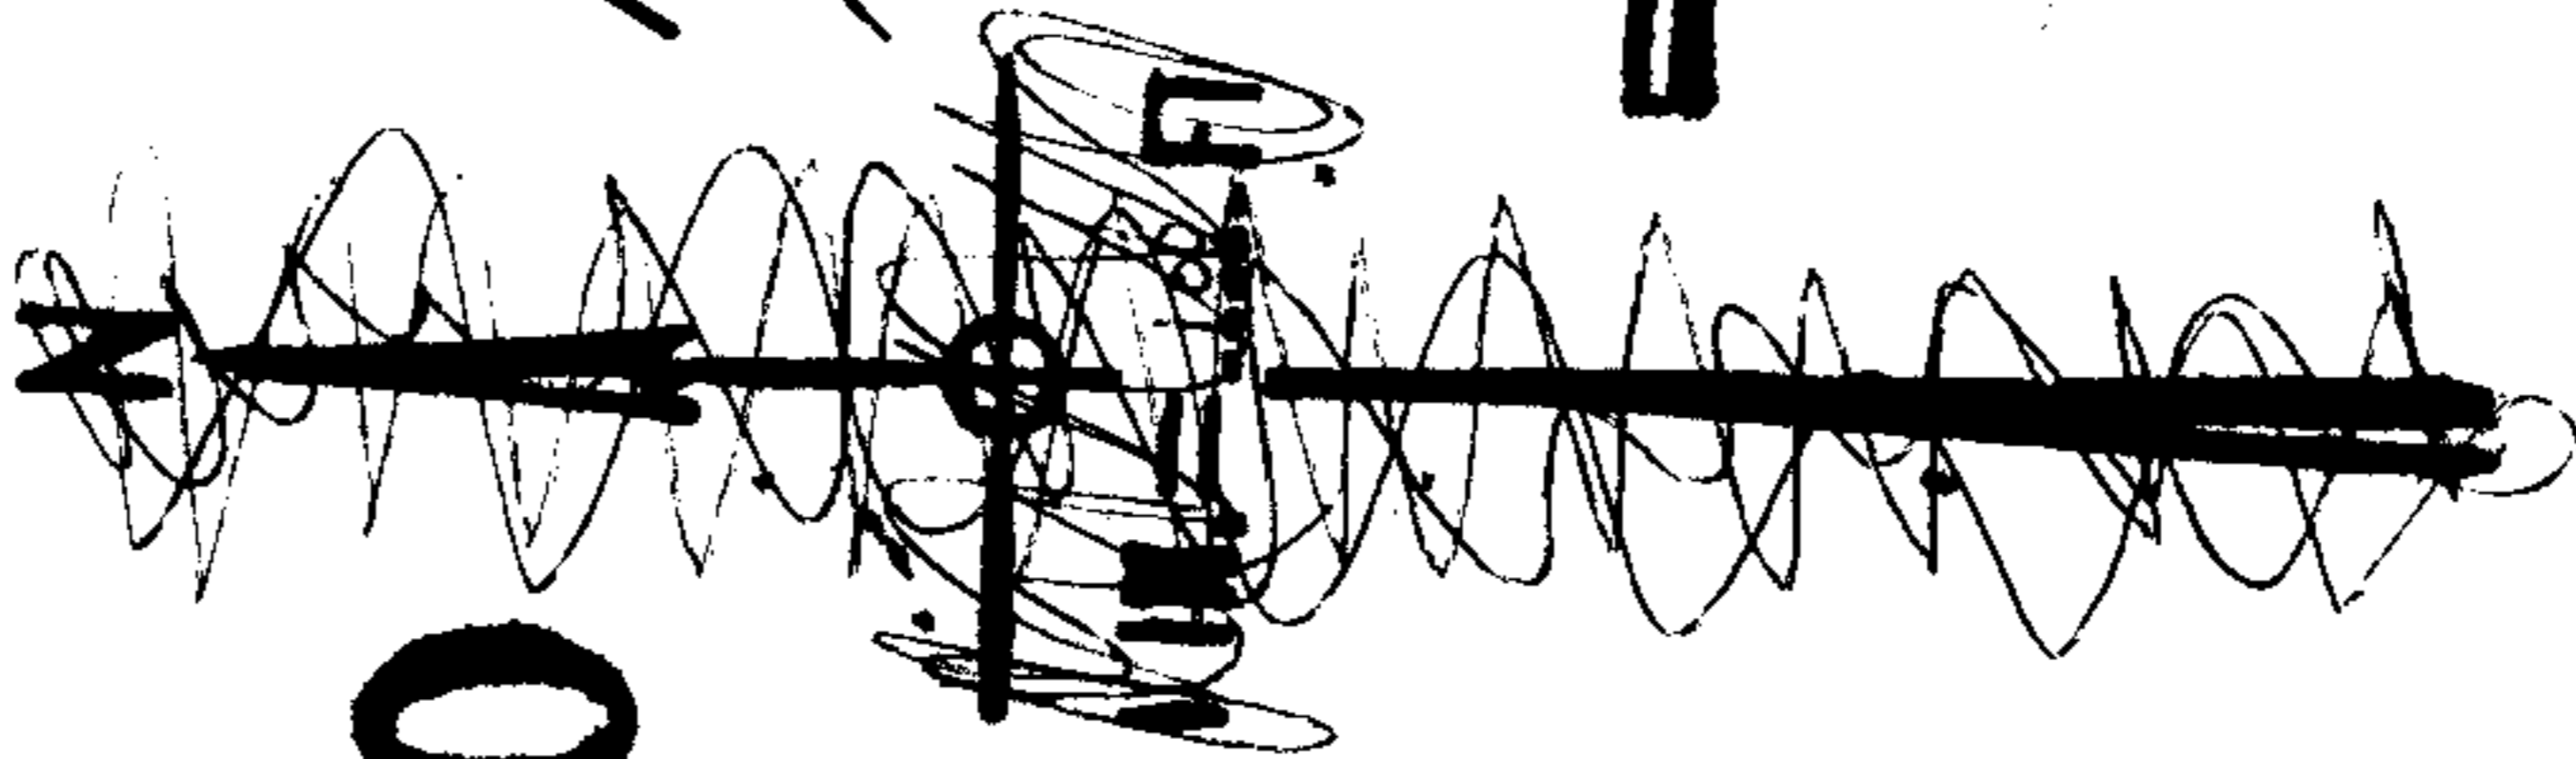

2000

APPROVED
LORAIN CO.
MAP DEPT.
DATE 8-2-68
7-00-019-C
BY <i>Hollink</i>

9/26/68 R.V.K.

7-14-86 - L.L.

782.21

594

3-D