

647.48
1925.78
238.34
1265.82


INTERSTATE

* NOTE -
HOOK GOES UP
TO 85' FRONT
PARCEL ON
COOPER FOSTER PARK

12.70 A

5.08 A

90

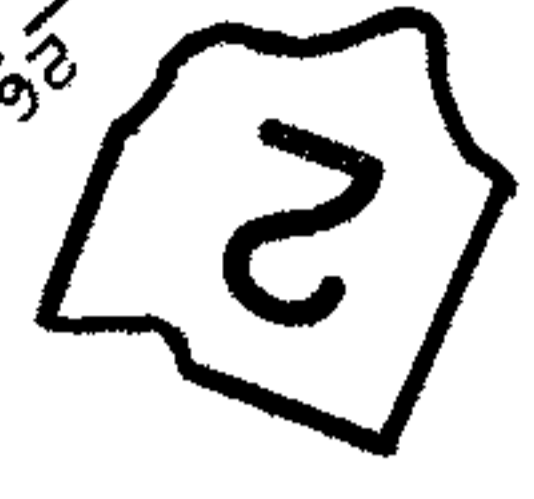

VOID #	20012
AFTER	
BY	FRANCIS
DATE	7-30-92
PAGE	5-00-060-A
MAP DEPT.	LORAIN CO.
APPROVED	

8/31/92
20012

05-00-060-101- PRIOR INST: 99/39
SURVEYED BY: NORMAN R. HURA & ASSOC.
C=1:1074,314

101

045
042 51.56A
39.25A

SEE 5-00

1182.09

ANNEXATION DATA
COMM. RES. CITY
65-776

66

