

254

SEE

DETAIL  
EXHIBIT  
SCALE 1" = 100'



EVERGREEN DR.

ED SMITEK SUB. NO. 2

V. 37

P. 56

EVERGREEN DRIVE

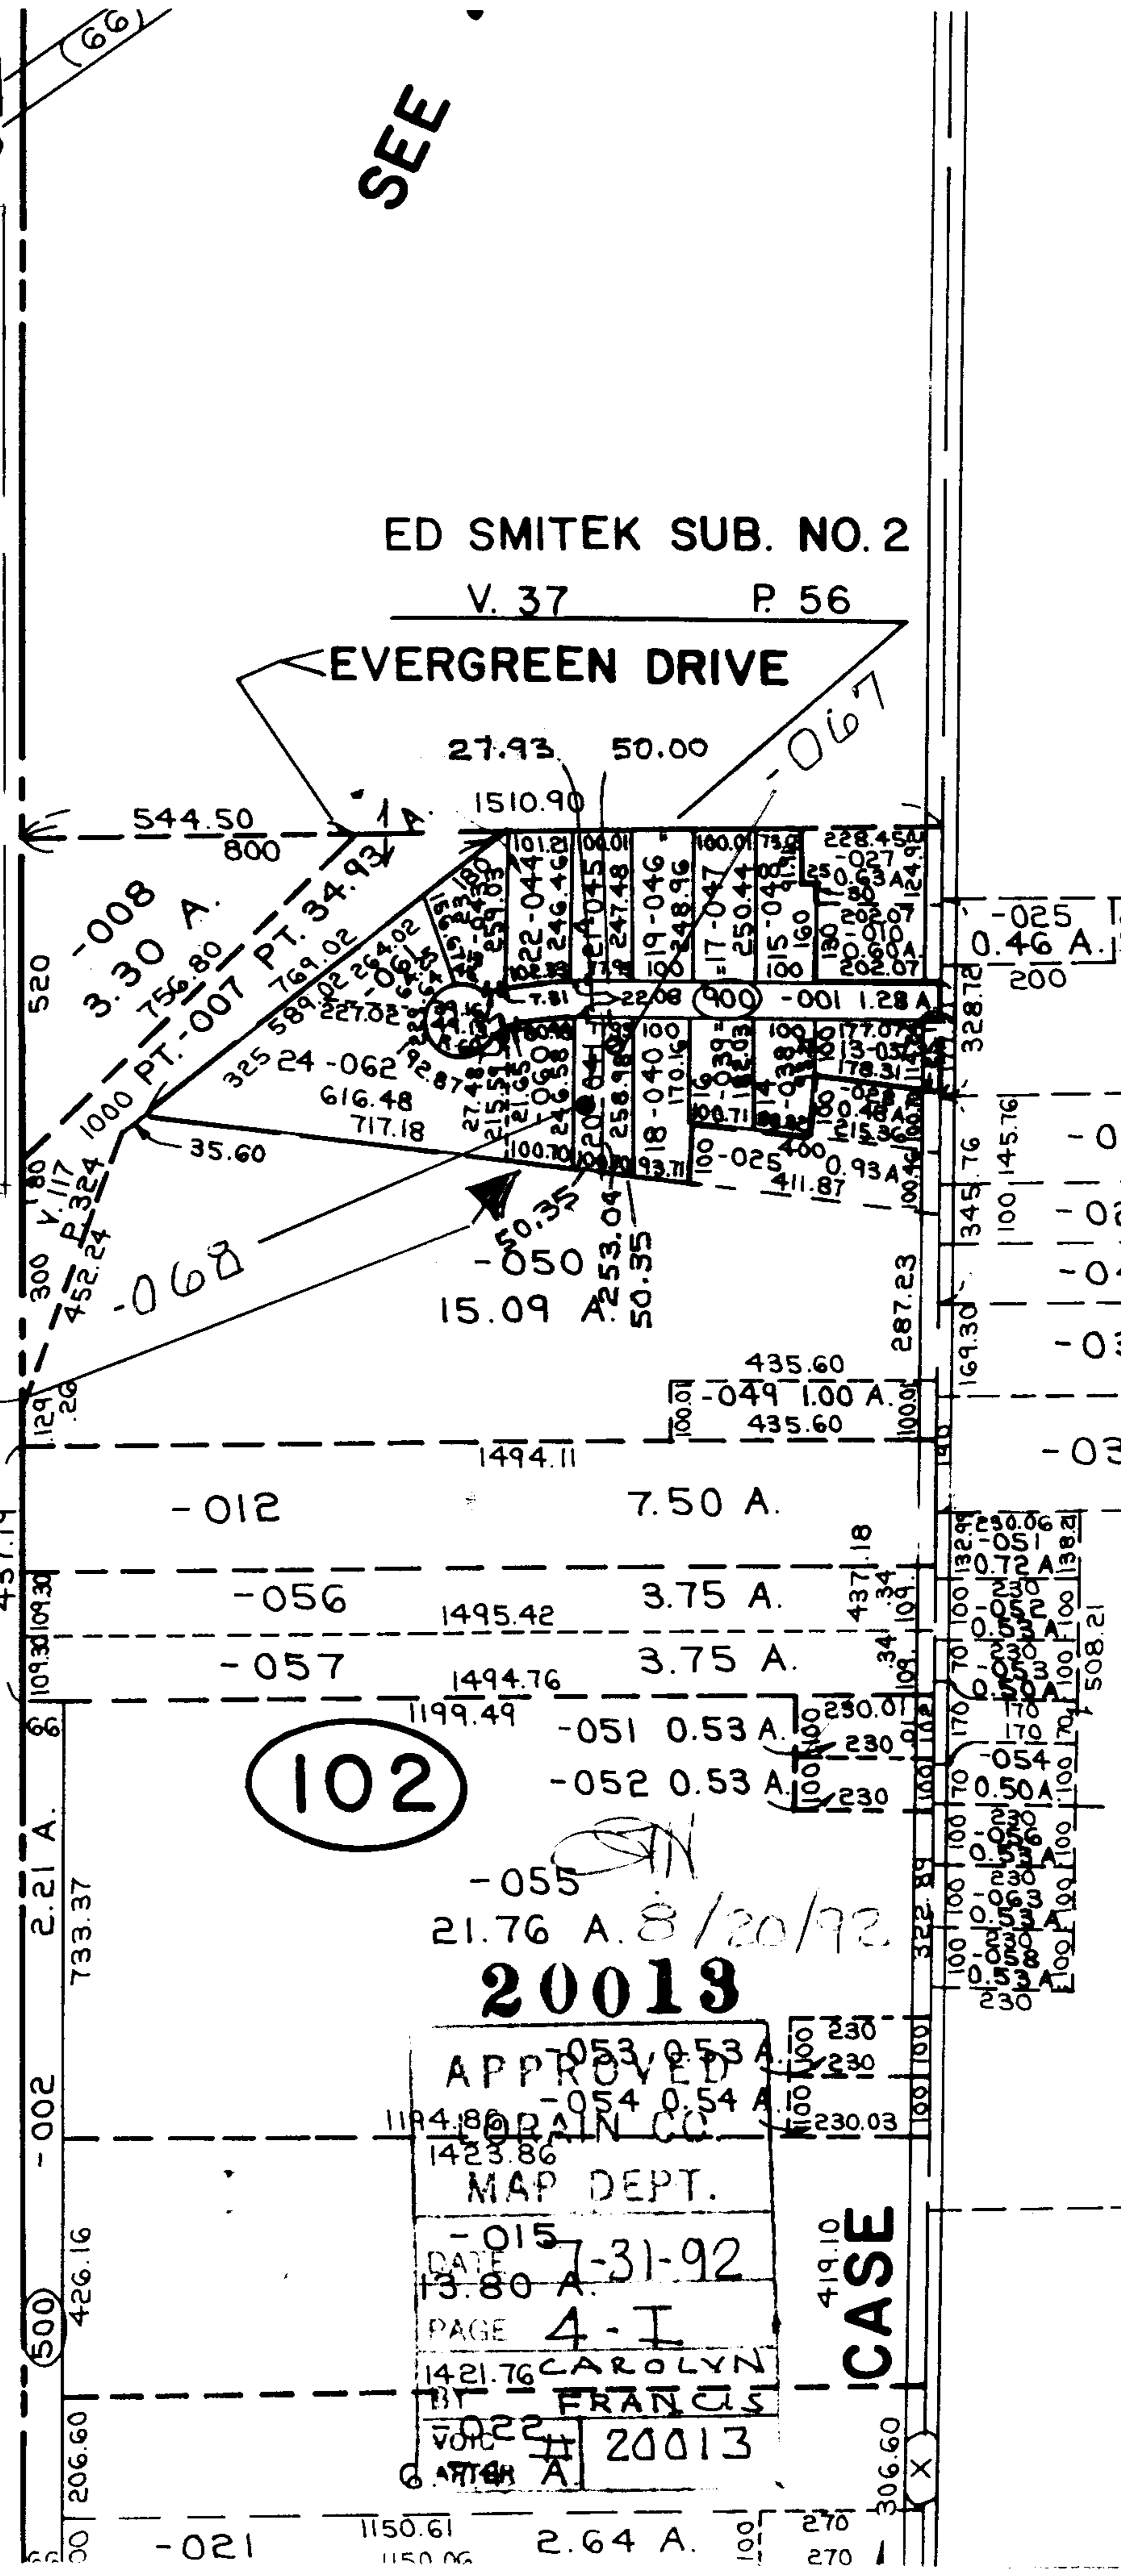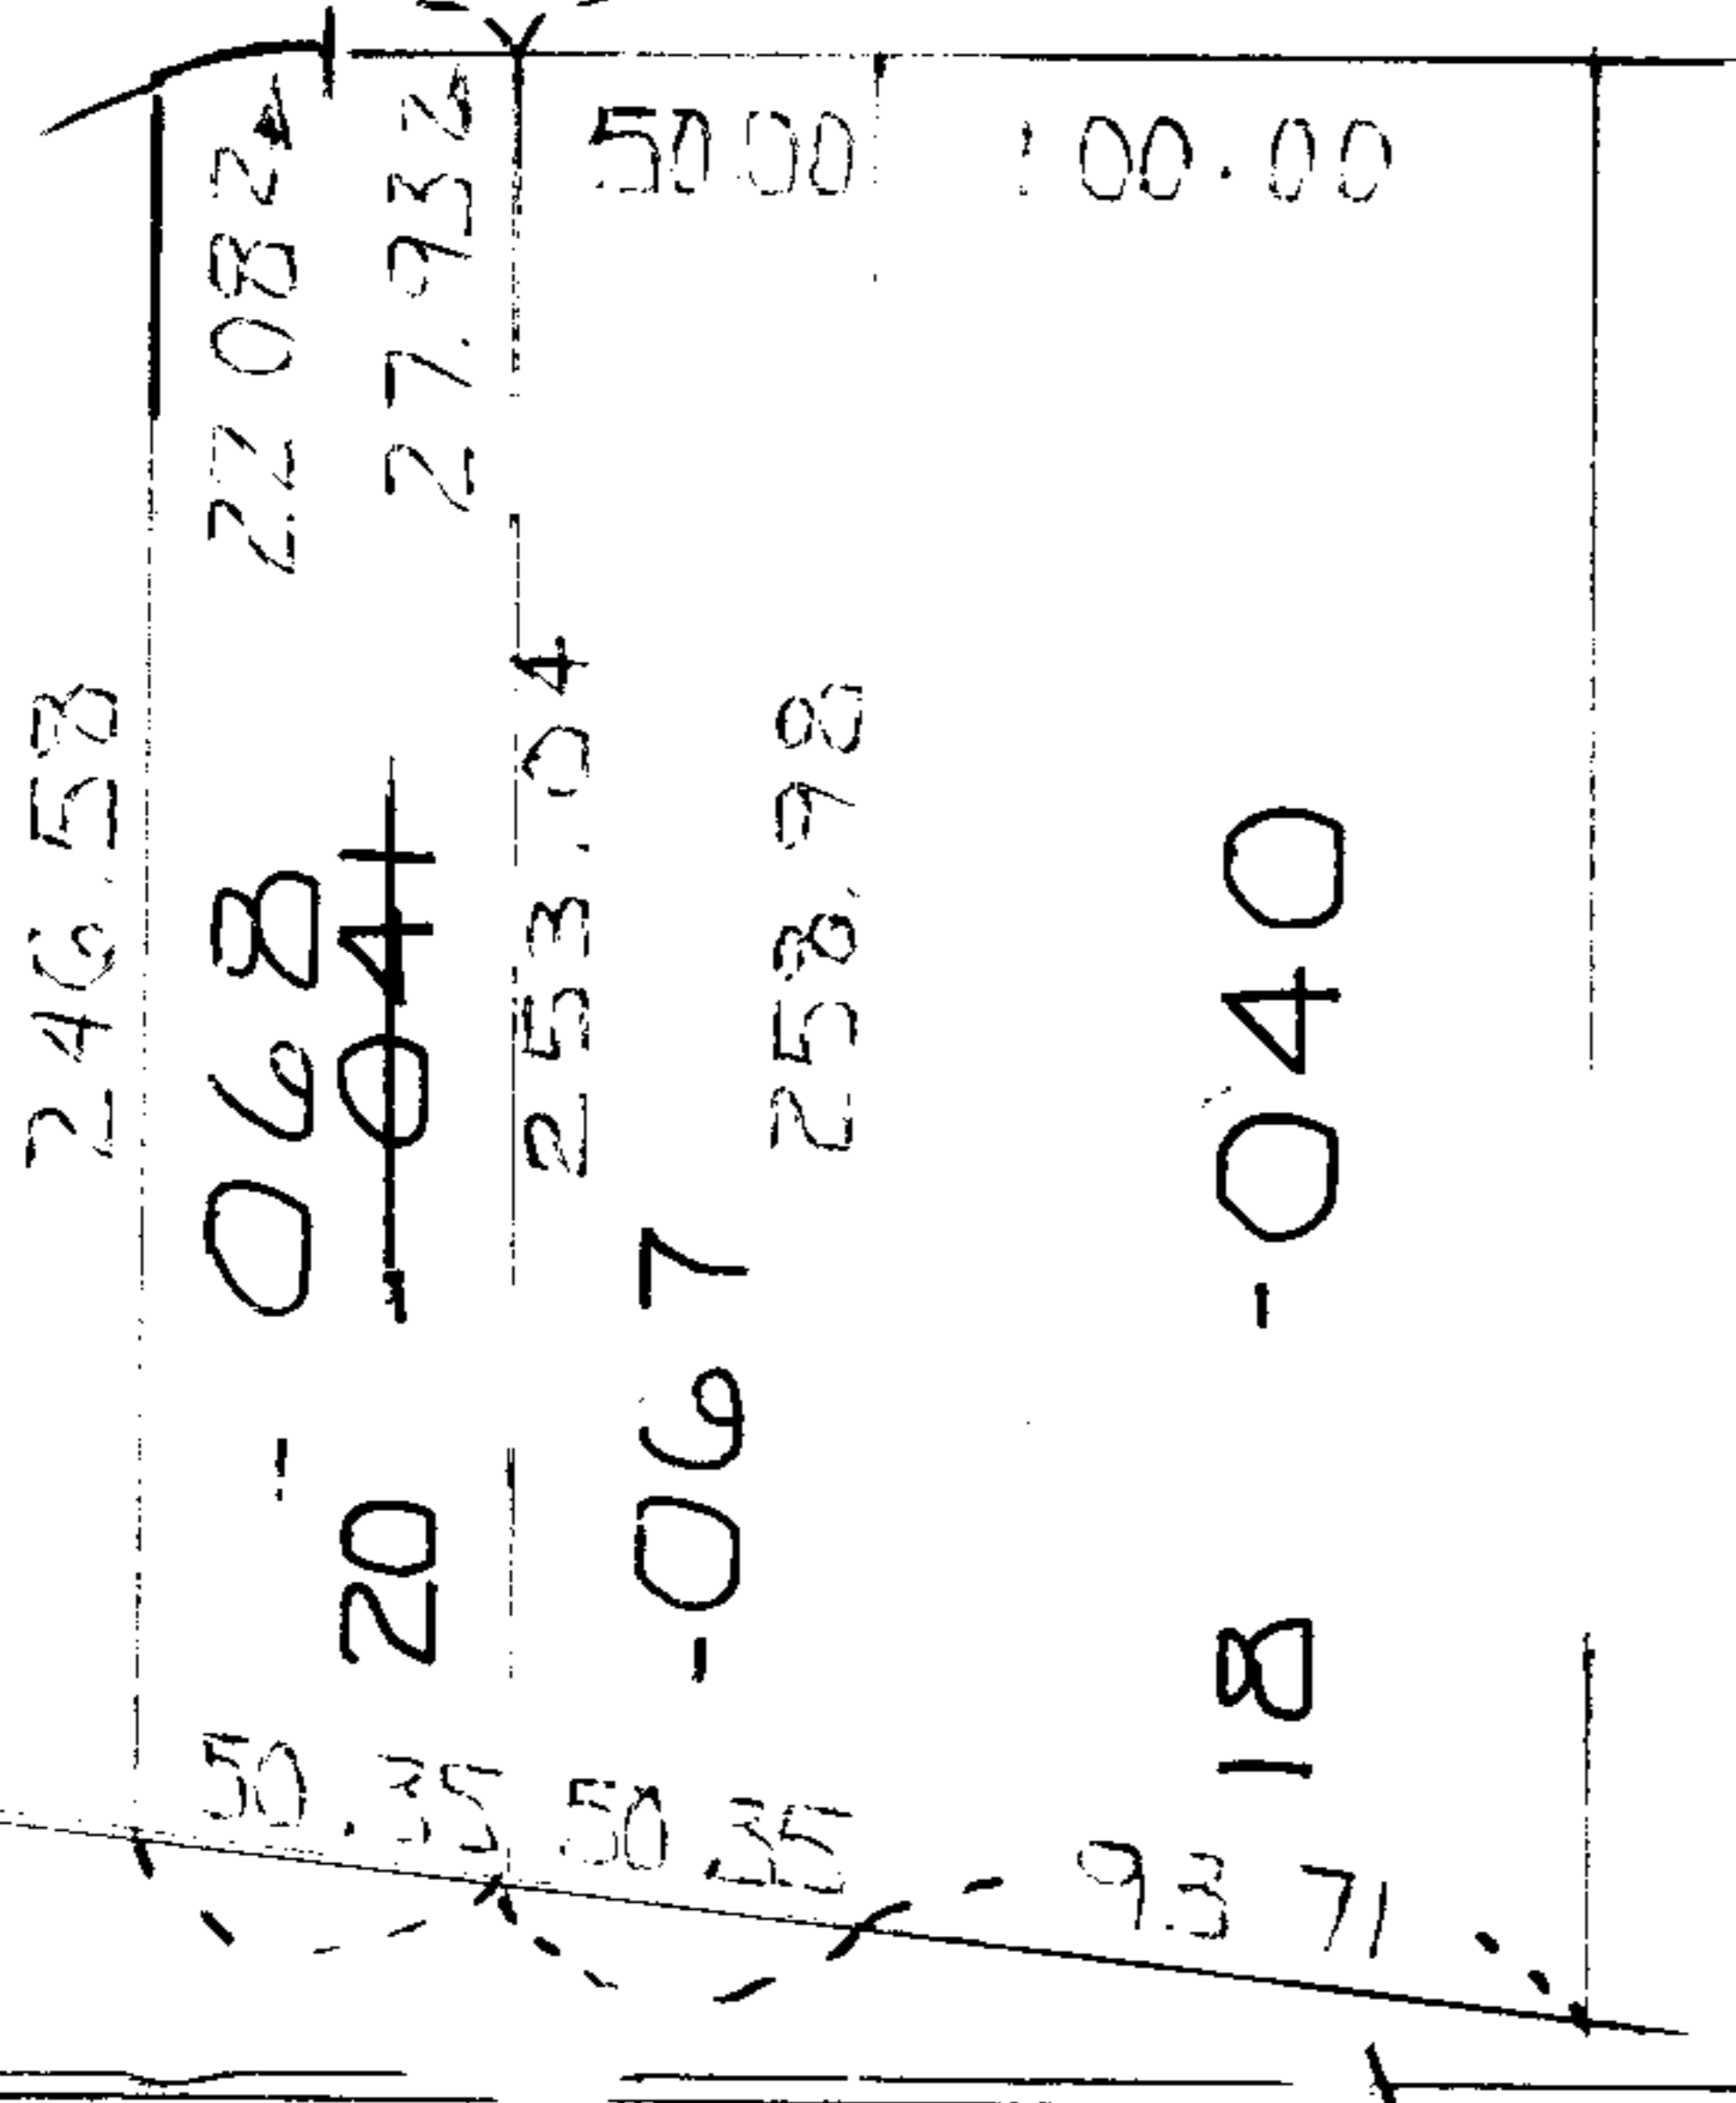

04-00-001-102-  
 PRIOR INST: O.R. 210/458  
 SURVEYED BY: JAMES A. RESAR  
 C=1: ~~129~~ 814 REG. SURVEYOR  
 3343, 133

102

20013  
 8/20/92

APPROVED  
 MAP DEPT.  
 DATE 7-31-92  
 PAGE 4-I  
 BY CAROLYN FRANCIS  
 20013

CASE

N. Y. C. R. R.