




2002

8.8 98-41-1

APPROVED
LORAIN CO.
MAP DEPT.
DATE 8-2-68
700-016-D
BY <i>[Signature]</i>
9/27/68 R.R.

BAINBRIDGE

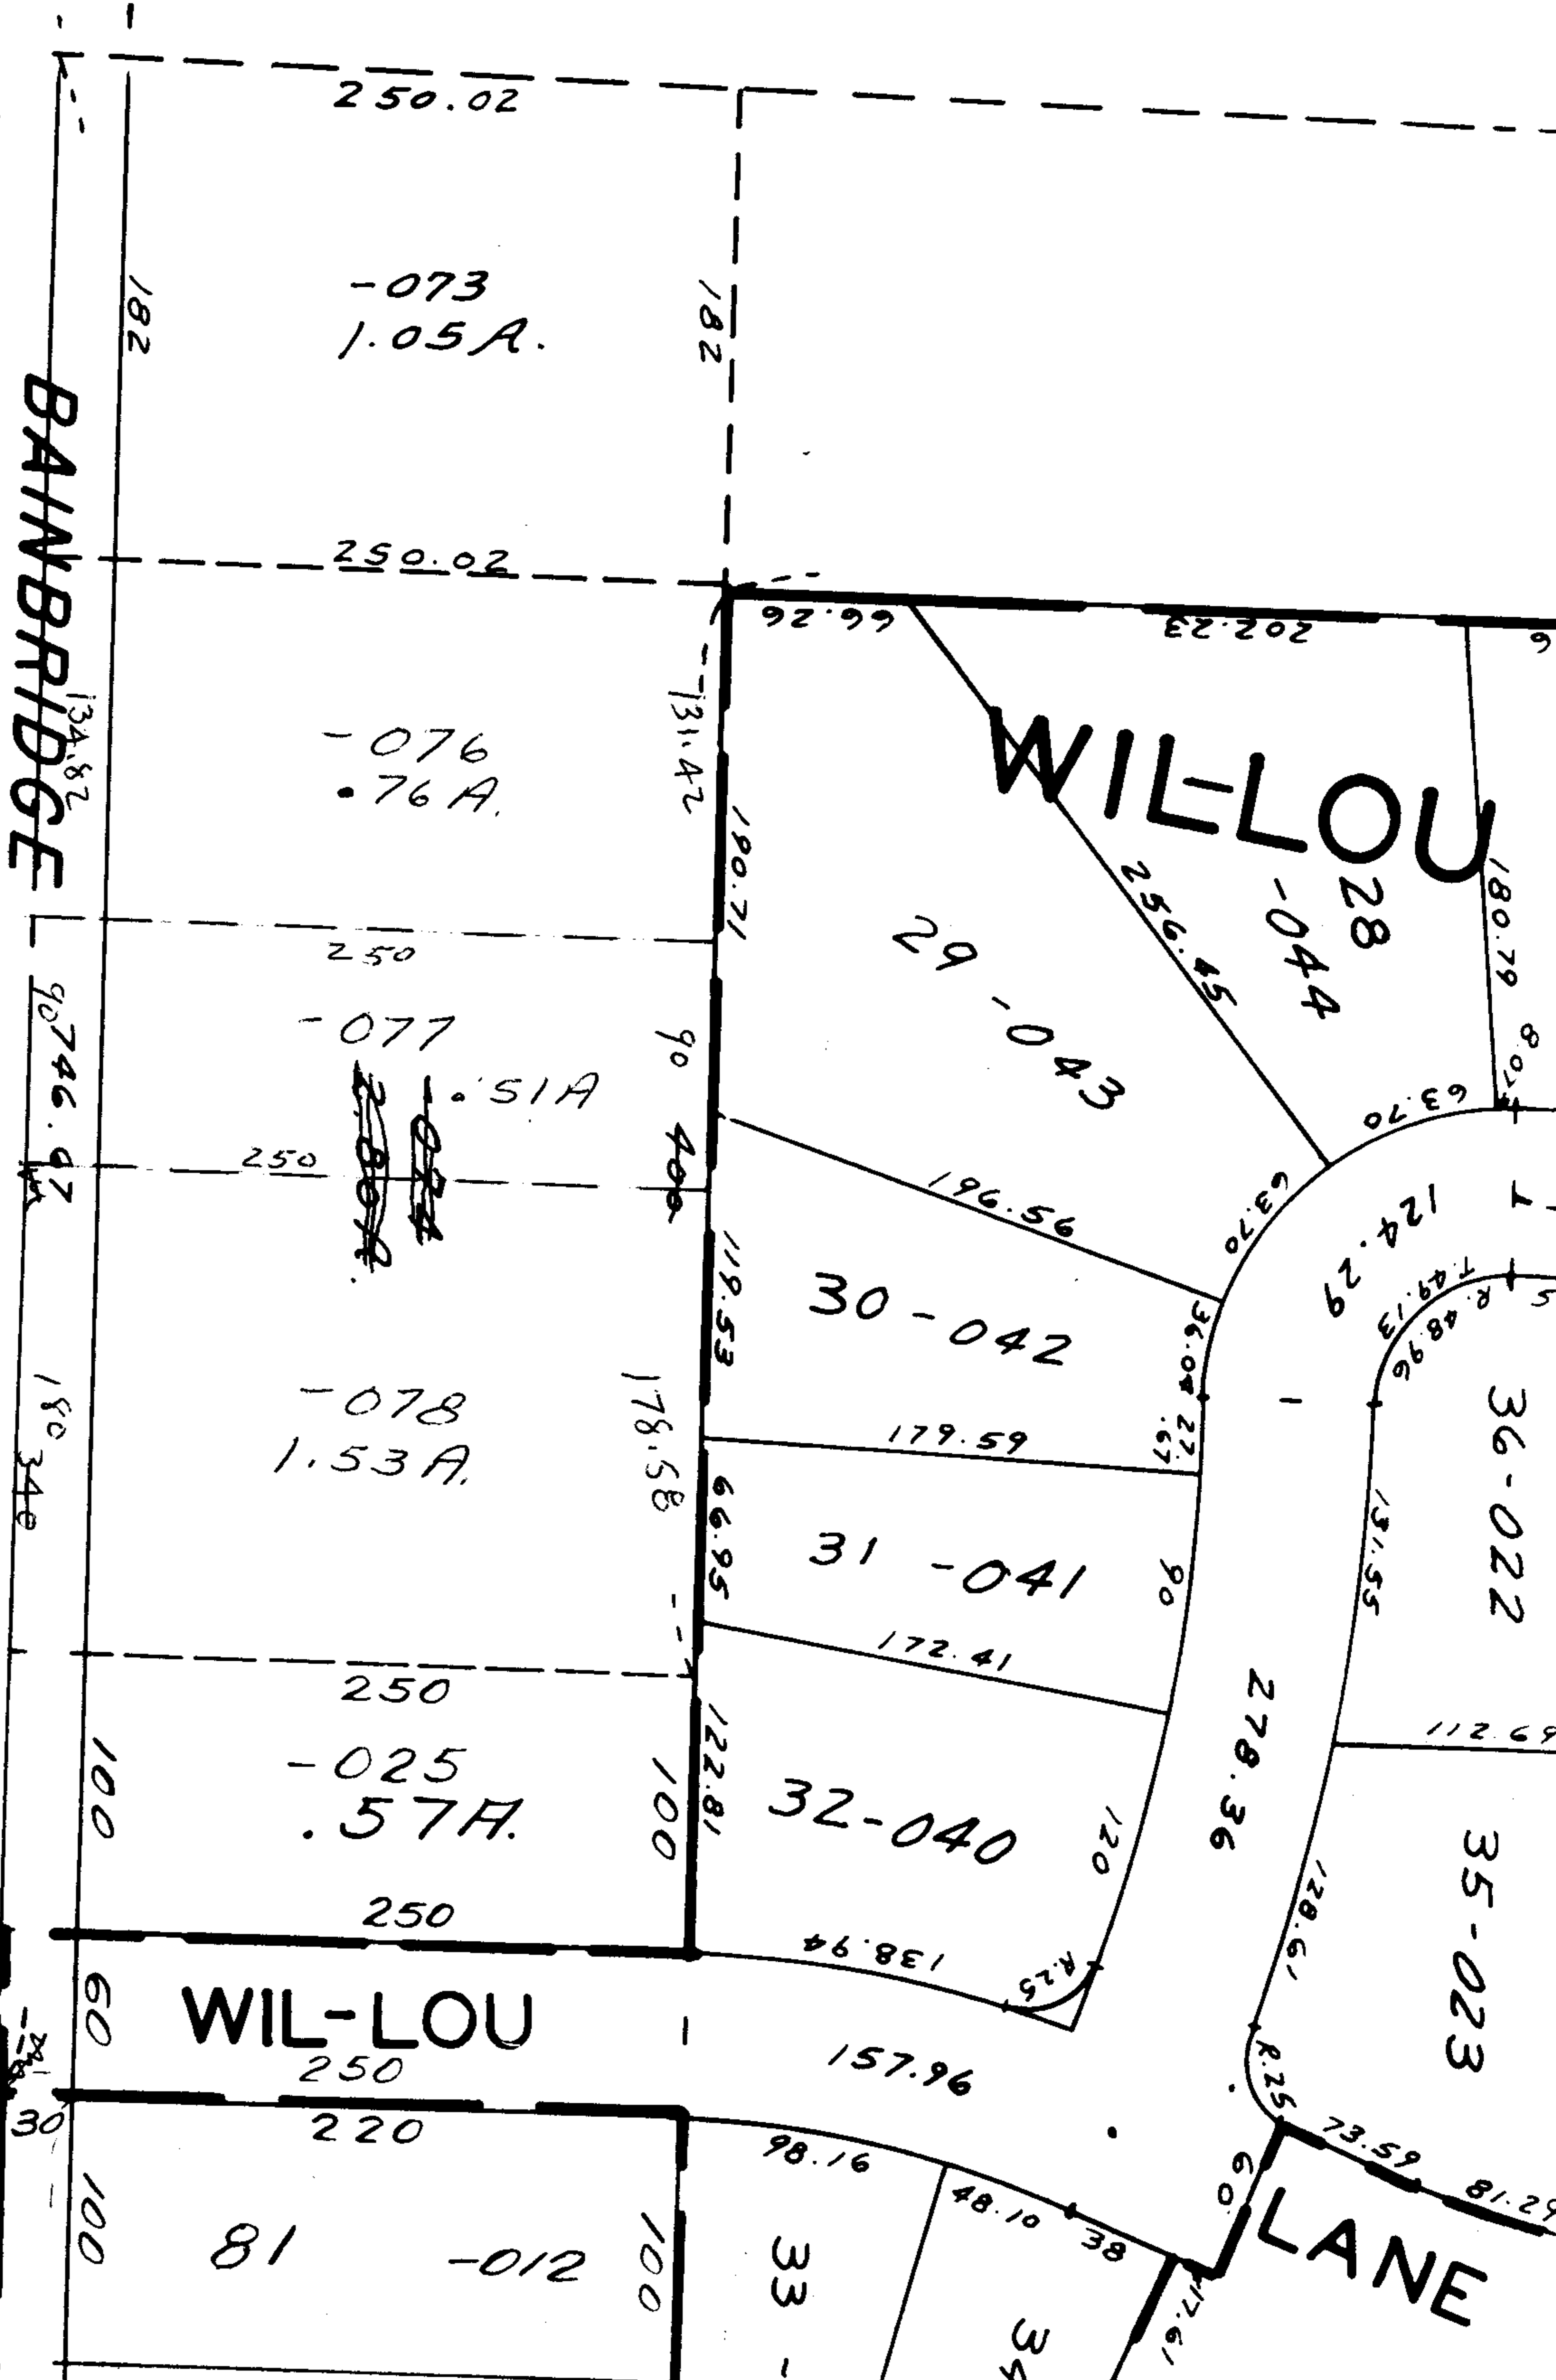

SEE 7-00-

$$\begin{array}{r} 2000.00 \\ 202.47 \\ \hline 1797.53 \end{array}$$

$$\begin{array}{r} 289.40 \\ 274.13 \\ \hline 563.53 \end{array}$$

$$\begin{array}{r} 340 \\ 150.97 \\ \hline 189 \end{array}$$