

THIS IS A SPLIT


DESCRIPTION DOES NOT GO TO CENTER LINE

PARCEL 1 COVERS PT. OF -059
PARCEL 2) " " " " -059
EXCEPTION IS A SPLIT

PROBLEM:

- ① DESCRIPTION DOES NOT GO TO CENTERLINE.
- ② SHOULD DESCRIPTION TAKE IN MILLS RD TO SOUTH LINE?
- ③ AC. WILL

CHANGE AF PER CORR.

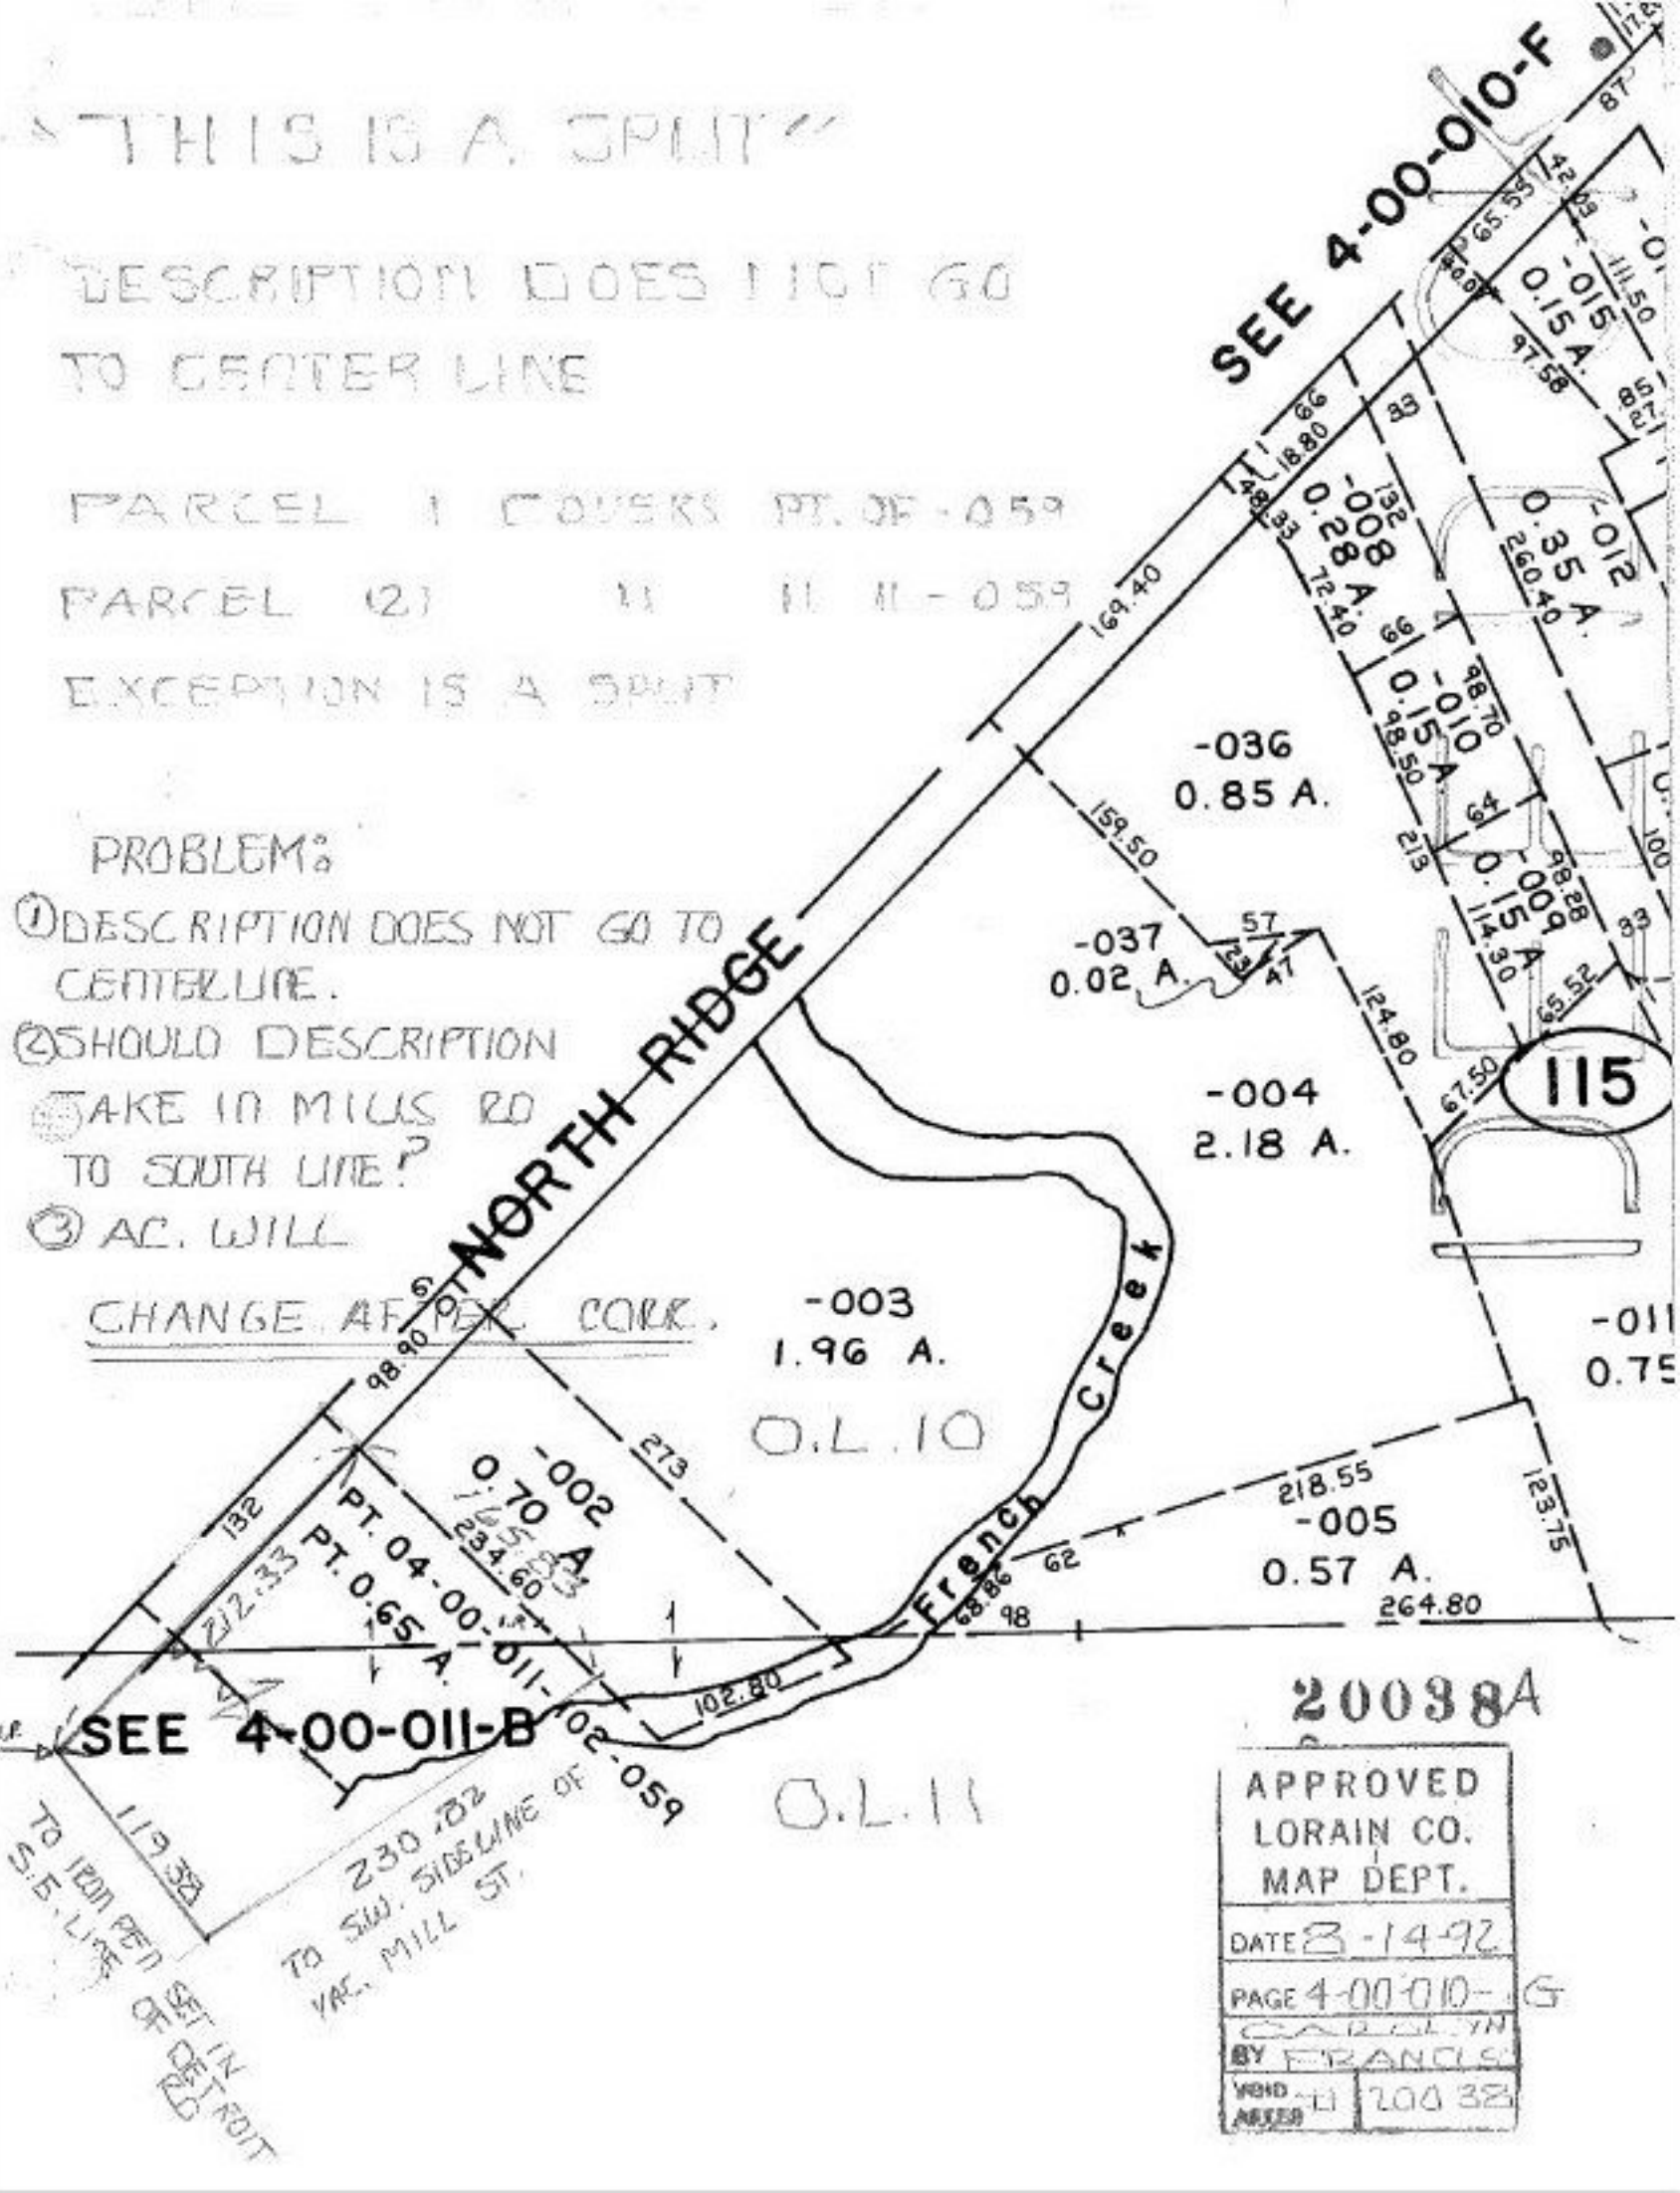

200384

APPROVED	
LORAIN CO.	
MAP DEPT.	
DATE 8-14-92	
PAGE 4-00-010-G	
BY FRANCIS	
VOID	20038
ARISE	

TO 1201 PTD
S.E. CORNER
DET. RD

TO SW. SIDELINE OF
VAC. MILL ST.

SEE 4-00-011-B

O.L. 11

O.L. 10