


MEDINA - NORWALK

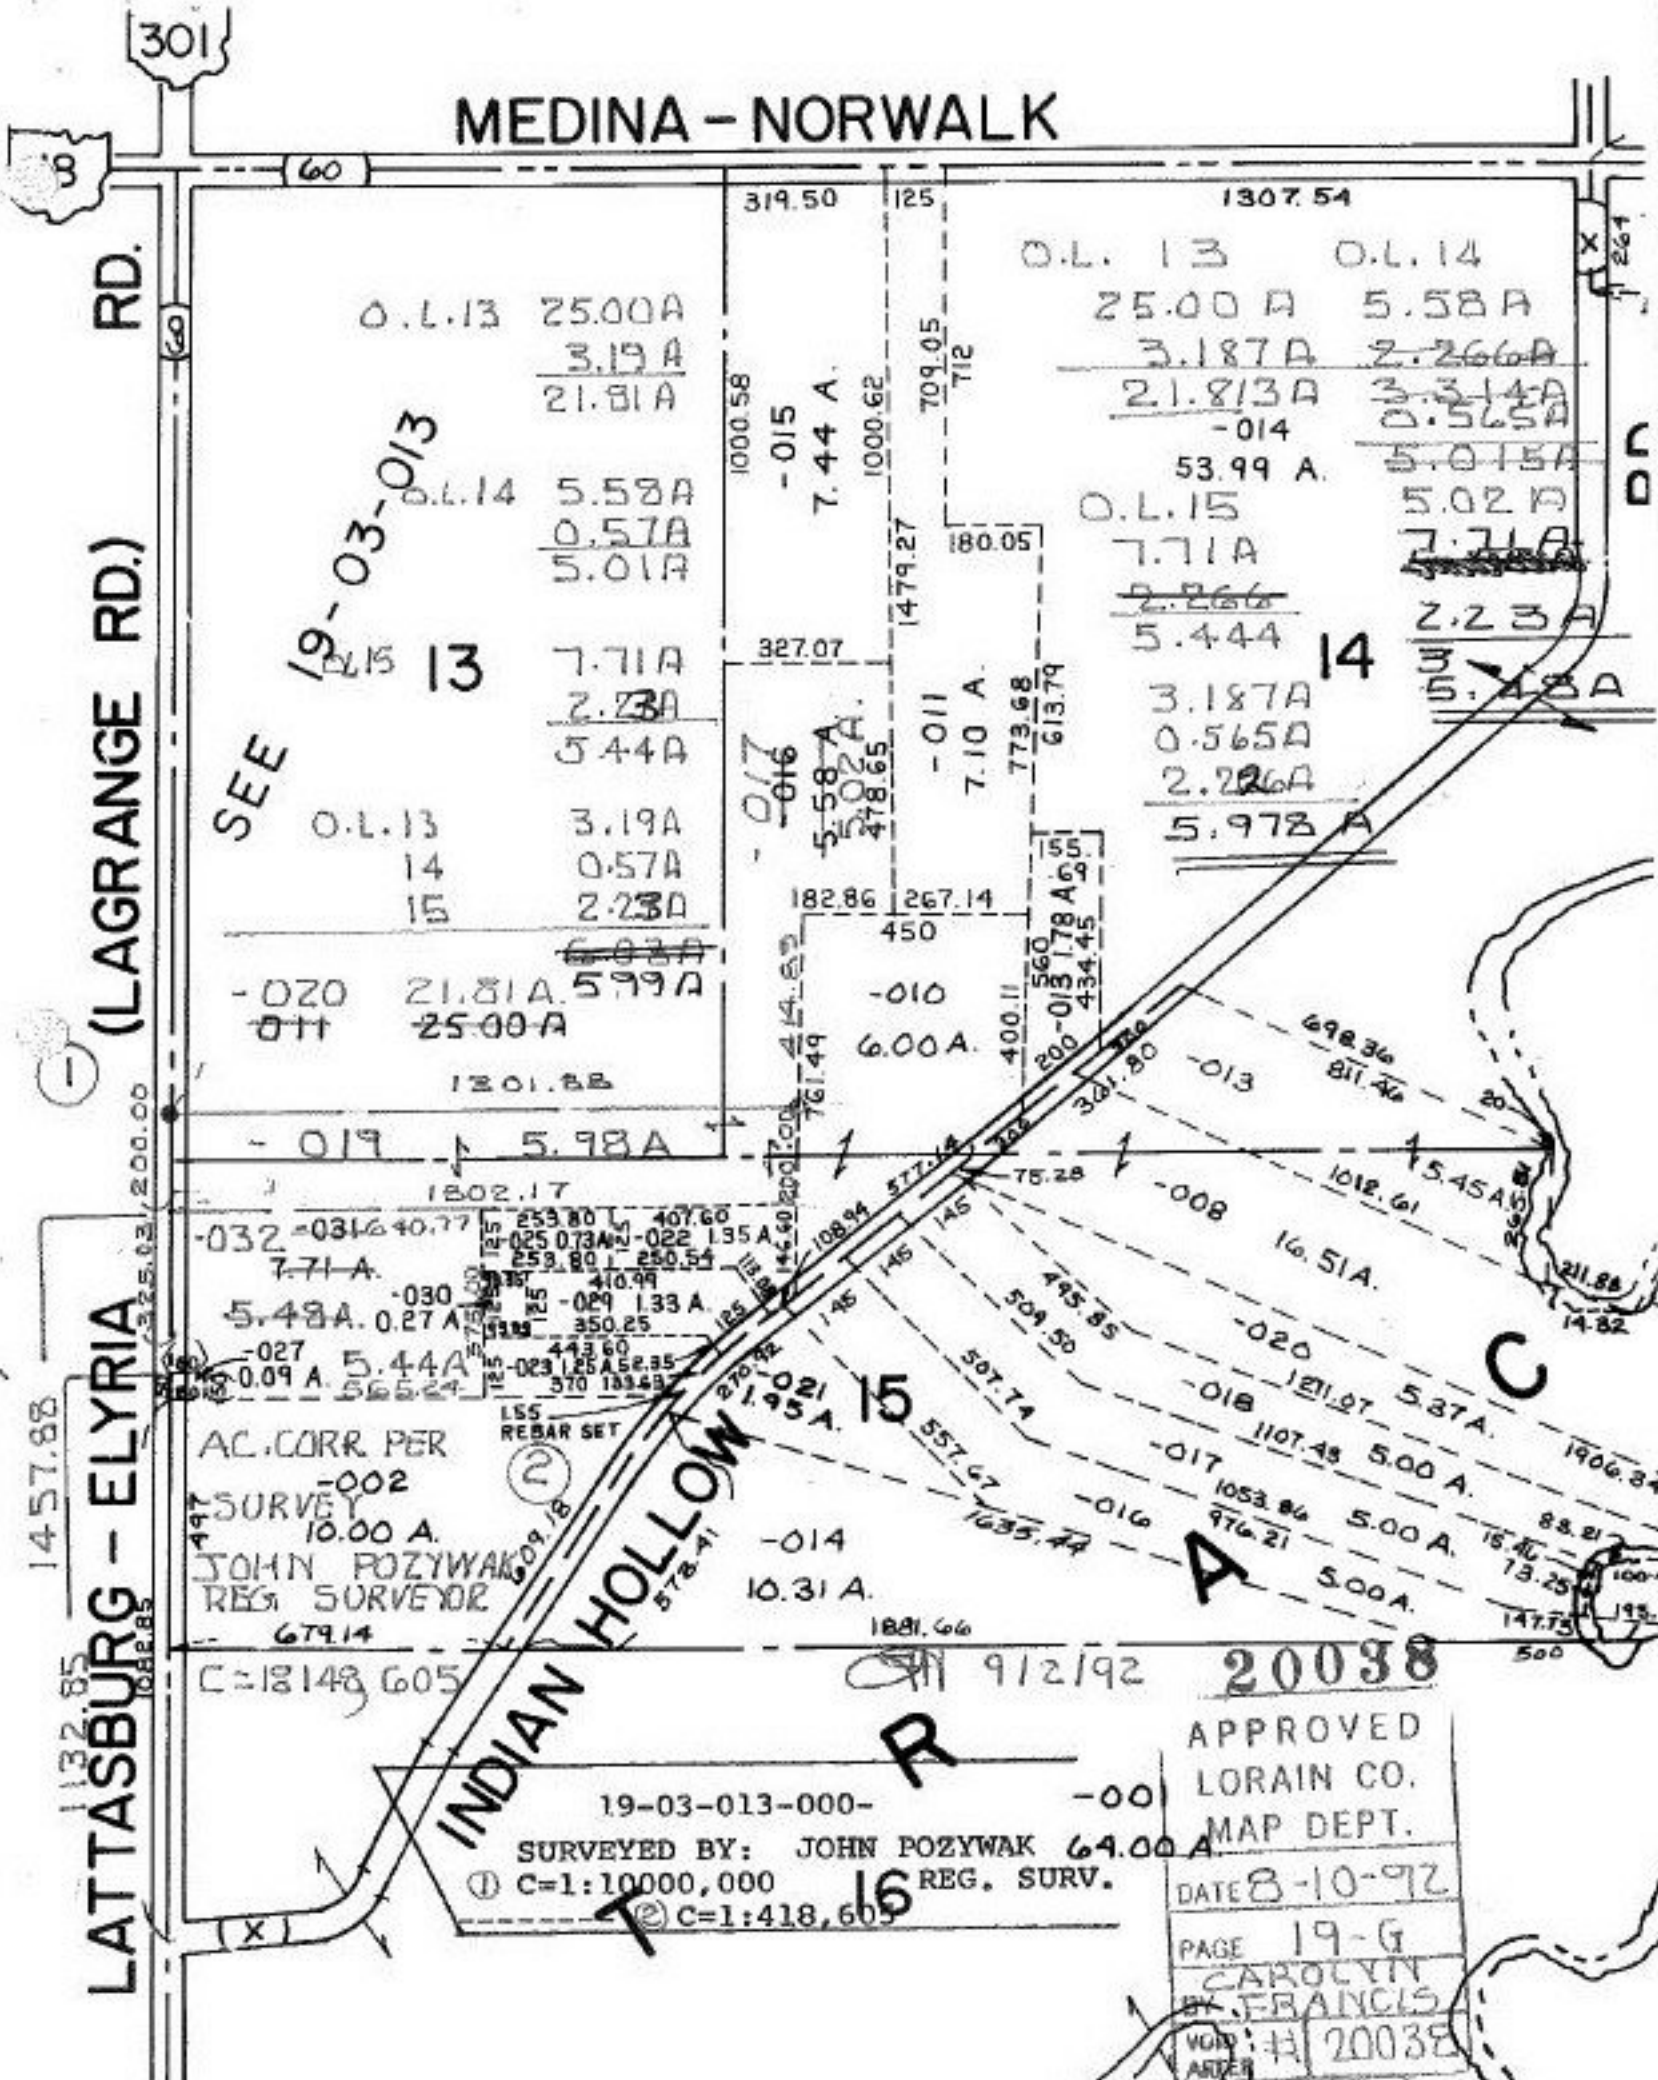

SEE 19-03-013

AC. CORR PER SURVEY 10.00 A. JOHN POZYWAK REG. SURVEYOR

INDIAN HOLLOW

19-03-013-000- SURVEYED BY: JOHN POZYWAK REG. SURV. C=1:10000,000 C=1:418,605

20038 APPROVED LORAIN CO. MAP DEPT. DATE 8-10-92 PAGE 19-G CAROLYN FRANCIS