

L a k


REF -
SEE #18308-A
3/31/89

103

02-01-001-103-

006
043
5.15 A.

104

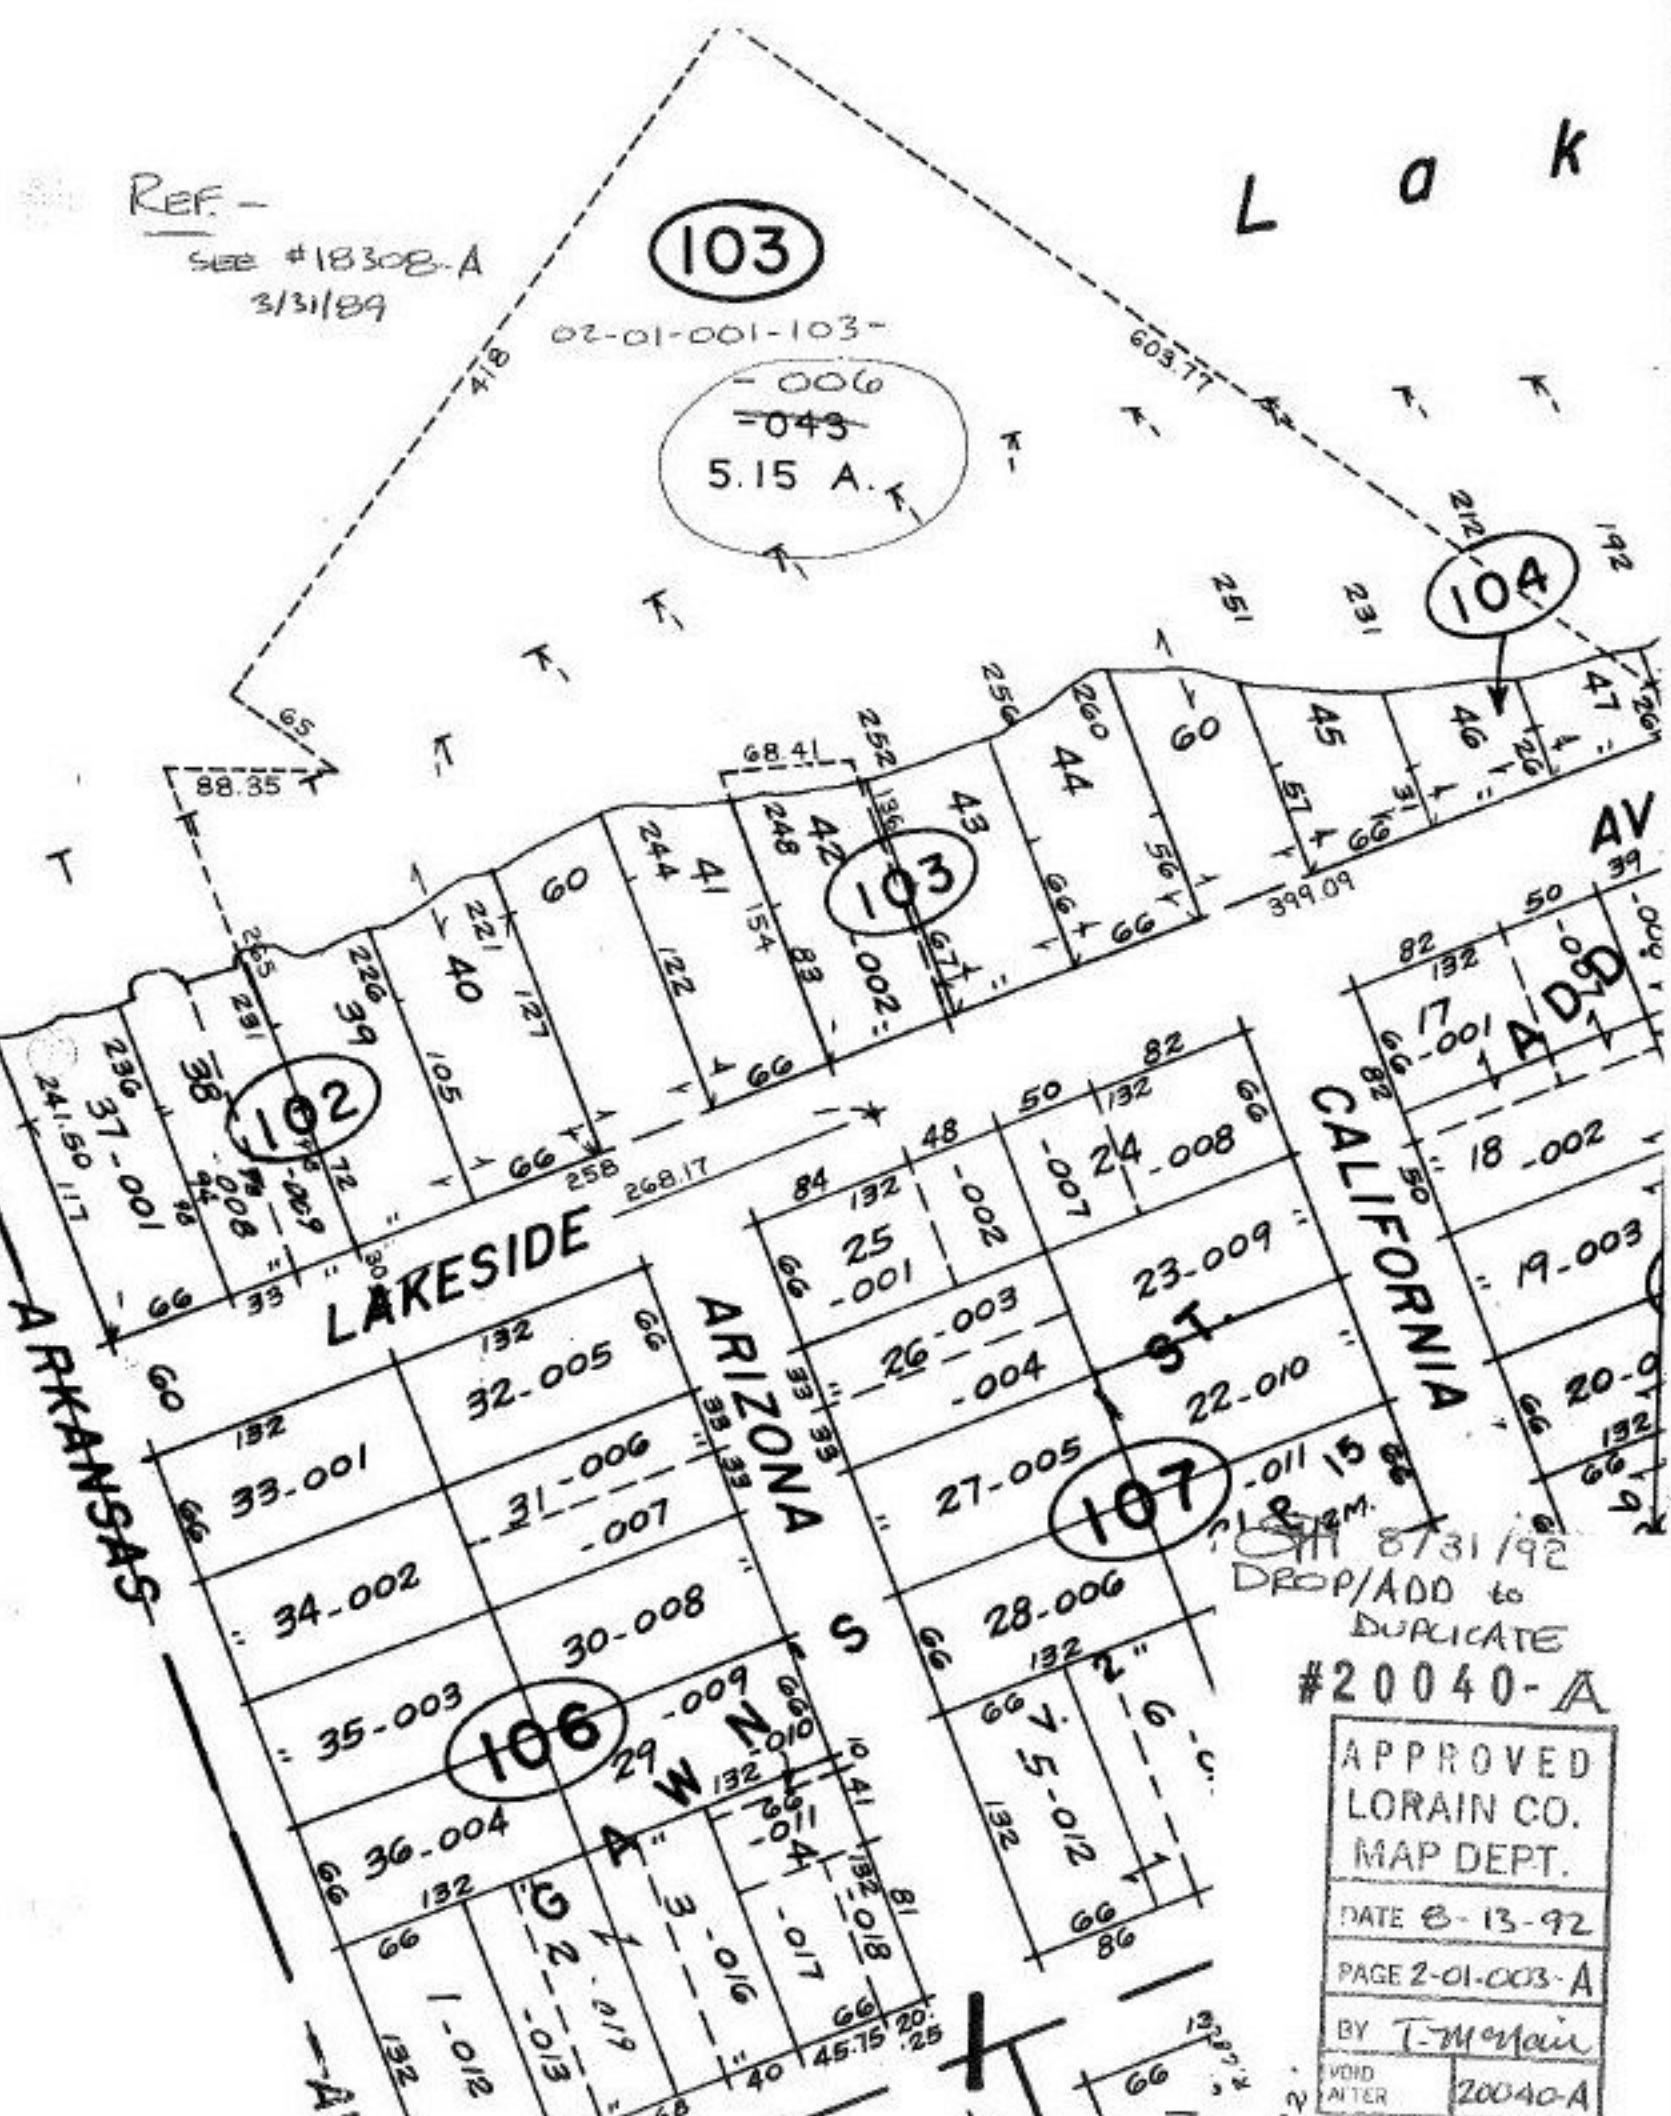

ARKANSAS

LAKESIDE

ARIZONA

CALIFORNIA

AV

ADD

8/31/92
DROP/ADD to
DUPLICATE
#20040-A

APPROVED
LORAIN CO.
MAP DEPT.
DATE 8-13-92
PAGE 2-01-003-A
BY T-McNair
VOID
AFTER 20040-A