

SEE 3-00-102-B

FULTON

PIKE

37th

INDUSTRIAL


CENTRAL PINE

ADD TO DUPLICATE PER DEED VOL 91 PG. 169

3-00-101-A



18-009	104	9-015
17-010		10-016
16-011		11-017
15-012		12-018
14-013		13-019
100		100

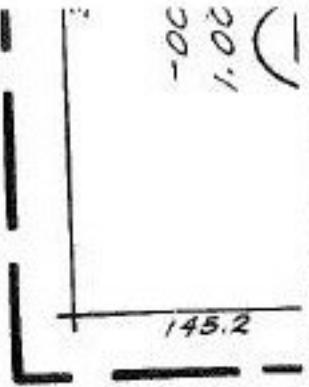

12-001	100
13-002	100
14-004	100
15-005	100
16-006	100
17-007	100
18-008	100
19-009	100
20-010	100
21-011	100
22-012	107
23-013	100
24-014	100
25-015	100
26-016	100
27-017	100
28-018	100
29-019	100
30-020	100

22-001	100
21-002	100
20-003	100
19-004	100
18-005	109
17-006	100
16-007	100
15-008	100
14-009	100
13-010	100
12-011	100
11-012	100
10-013	100
9-014	100
8-015	100
7-016	100
6-017	100
5-018	100
4-019	100
3-020	100

56-001	137.7
55-002	
54-003	
53-004	
52-005	
51-006	
50-007	
49-008	
48-009	
47-010	
46-011	
45-012	
44-013	
43-014	
42-015	
41-016	
40-017	
39-018	
38-019	
37-020	

37th CT.  
 Pt. 3.92 A.  
 ADD TO DUPLICATE PER DEED VOL 91 PG. 169  
 THE  
 APPROVED  
 BORAIN CO.  
 MAP DEPT.  
 DATED 03/17/92  
 PAGE 3100-101-A  
 BY T. B. CLS  
 VOID AFTER 12/01/92

#200  
 APPROVED  
 BORAIN CO.  
 MAP DEPT.  
 DATED 03/17/92  
 PAGE 3100-101-A  
 BY T. B. CLS  
 VOID AFTER 12/01/92