


3-00 143

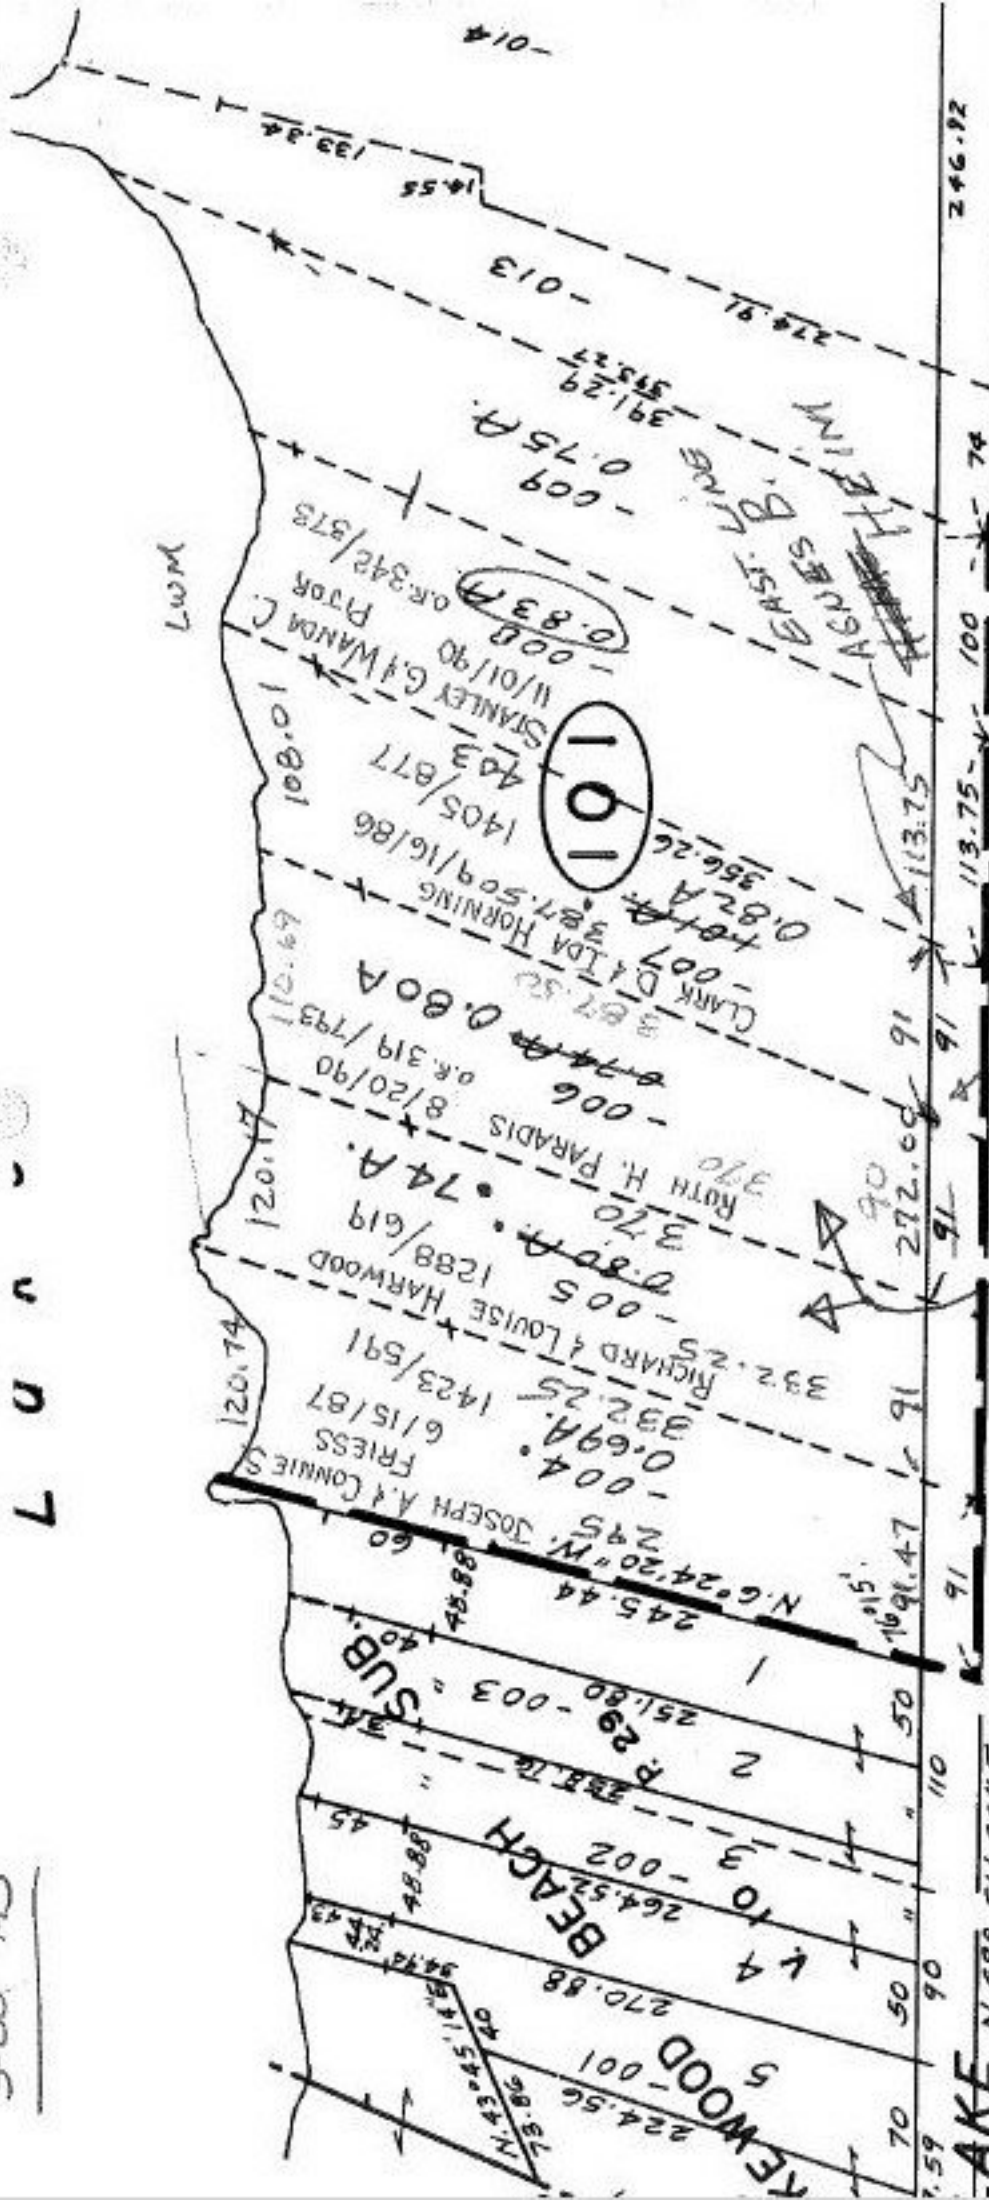

SAI 8/31/92
#20051A

INSERT

MAP CORRECTION

CHANGE ACREAGE

ON -005 Y-006

APPROVED
LORAIN CO.

DATE 8/19/92
BY L. HOLLIS
APPROVED 8/20/92

60	36-001	112.05	37.50	30.50	29.00	135
60	24-002					
60	25-003					
60	26-004					
60	27-005					
60	28-006					
60	29-007					
60	30-008					
60	31-009	115				
60	32-010					
60	33-011					
60	34-012					
60	35-013					
60	36-014	135	56.54	56.54	111.95	
60	39-003					