


1044.50
WALKER

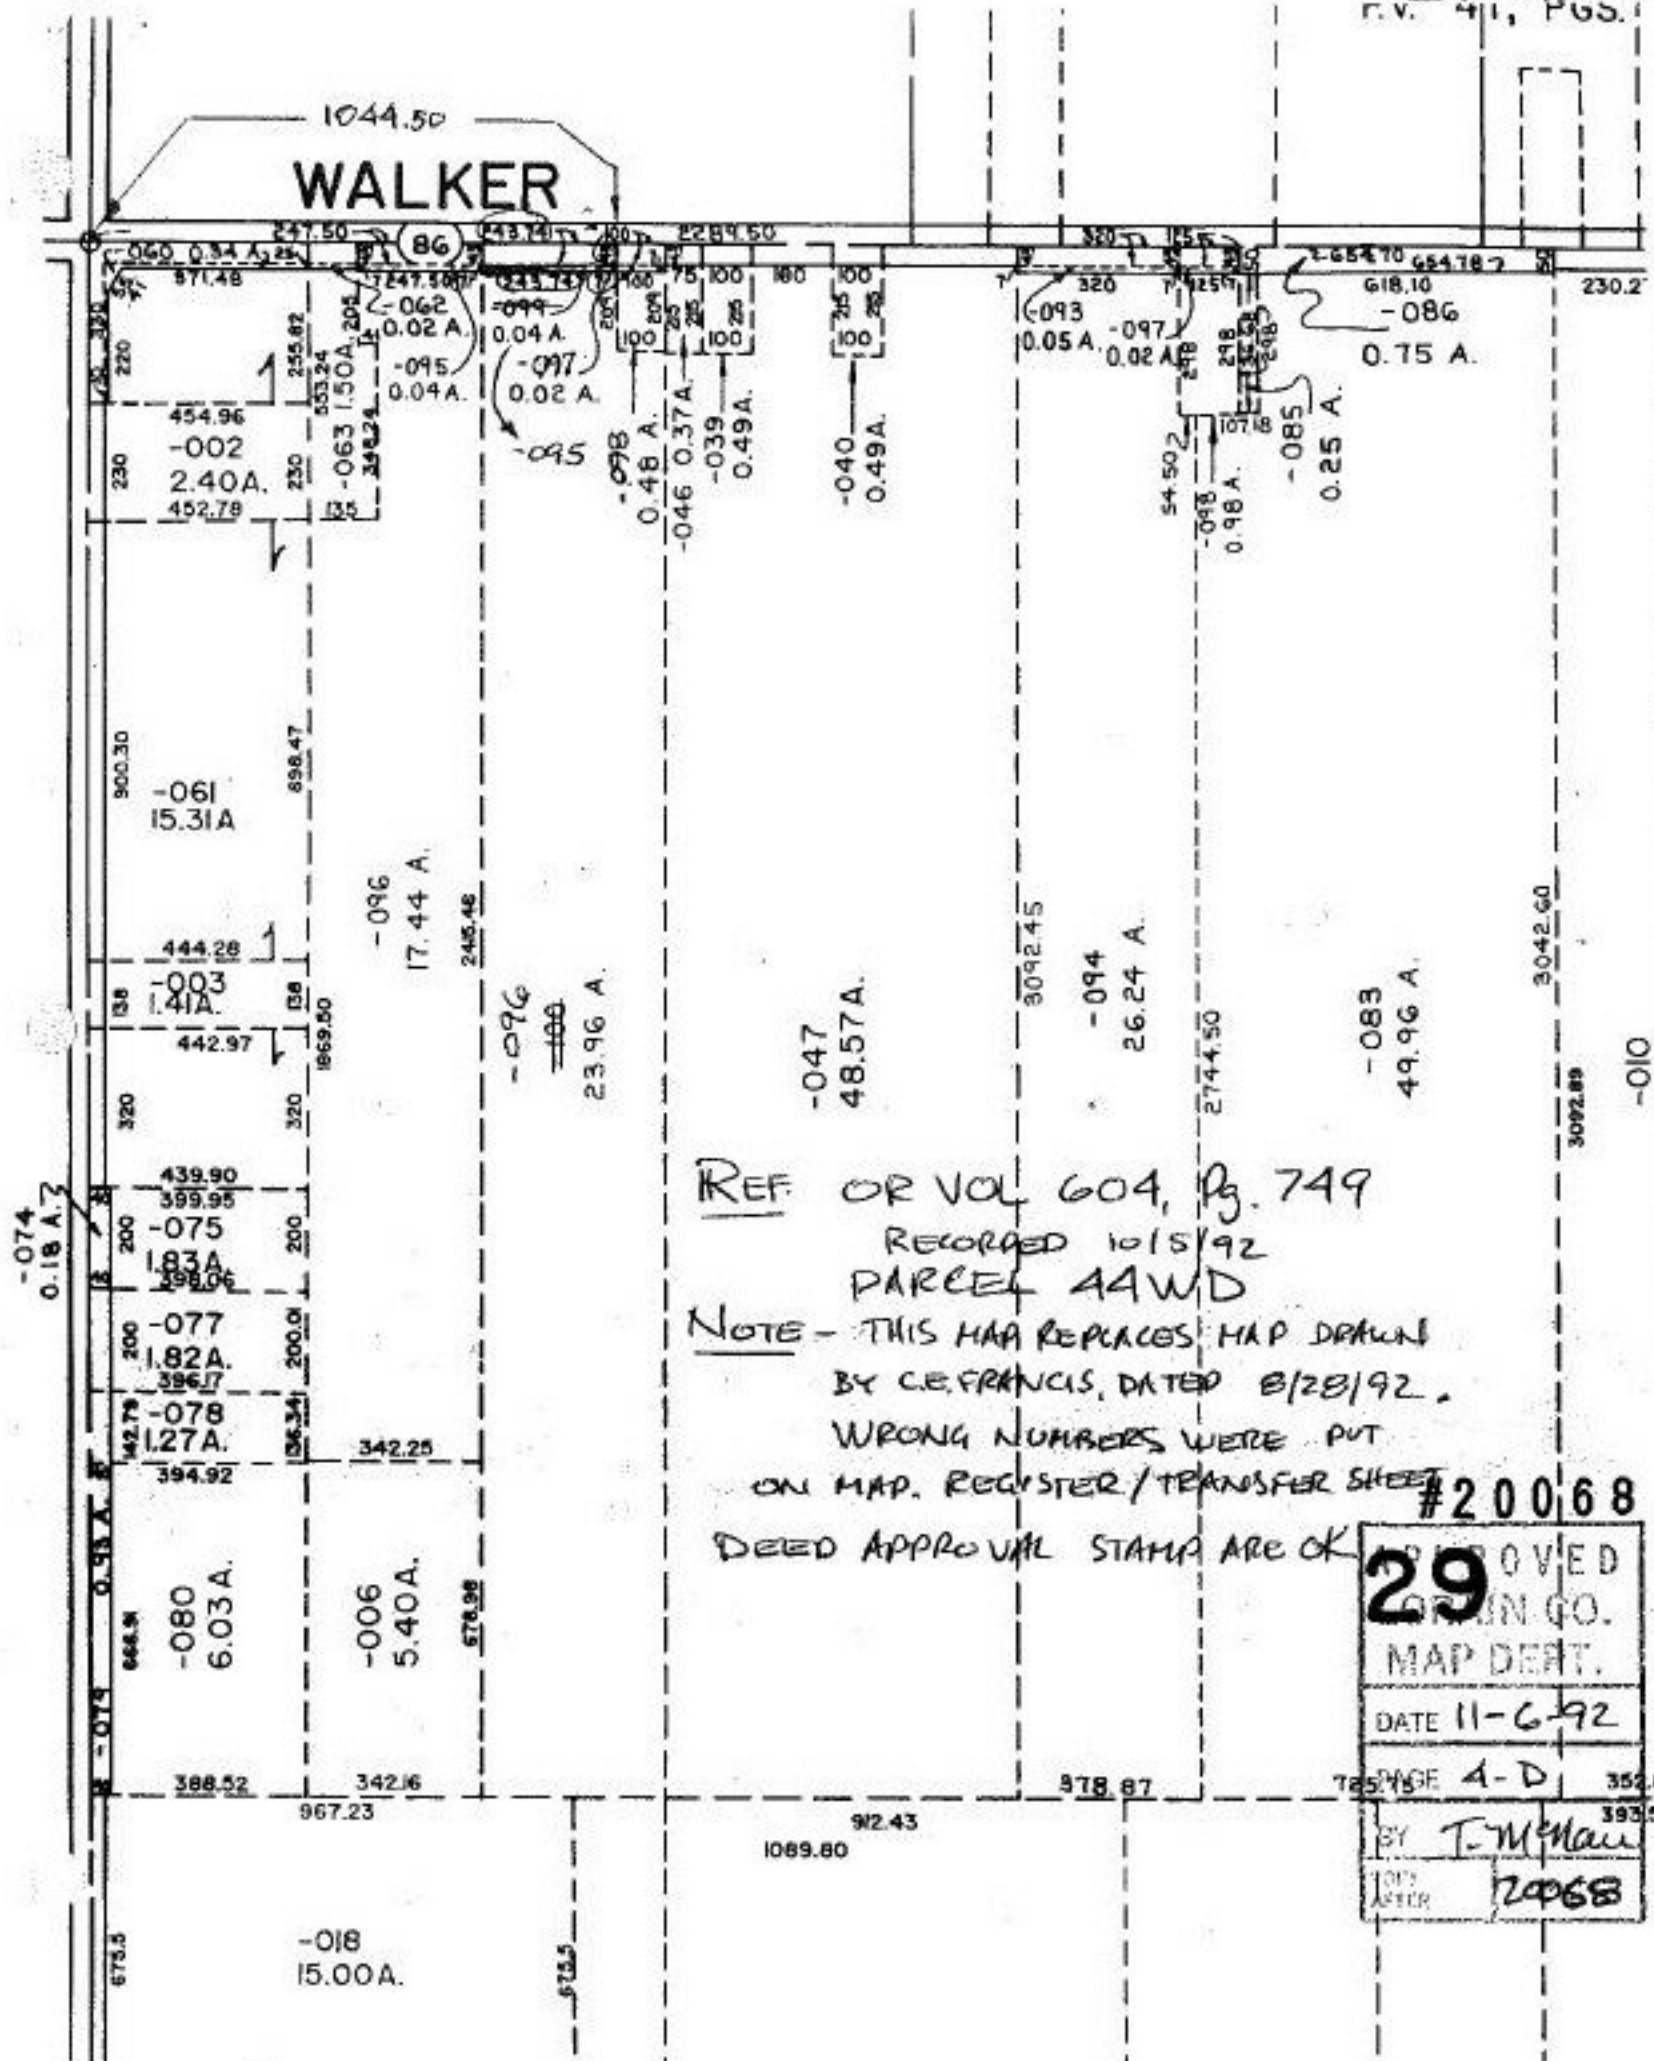

REF OR VOL 604, Pg. 749
 RECORDED 10/5/92
 PARCEL AAWD

NOTE - THIS MAP REPLACES MAP DRAWN
 BY C.E. FRANCIS, DATED 8/28/92.
 WRONG NUMBERS WERE PUT
 ON MAP. REGISTER / TRANSFER SHEET
 DEED APPROVAL STAMP ARE OK

#20068

APPROVED IN GO. MAP DEPT.	
DATE 11-6-92	
PAGE 4-D	
BY T. McMan	1935
10/5/92	20068