


MAP  
VOID

WALKER

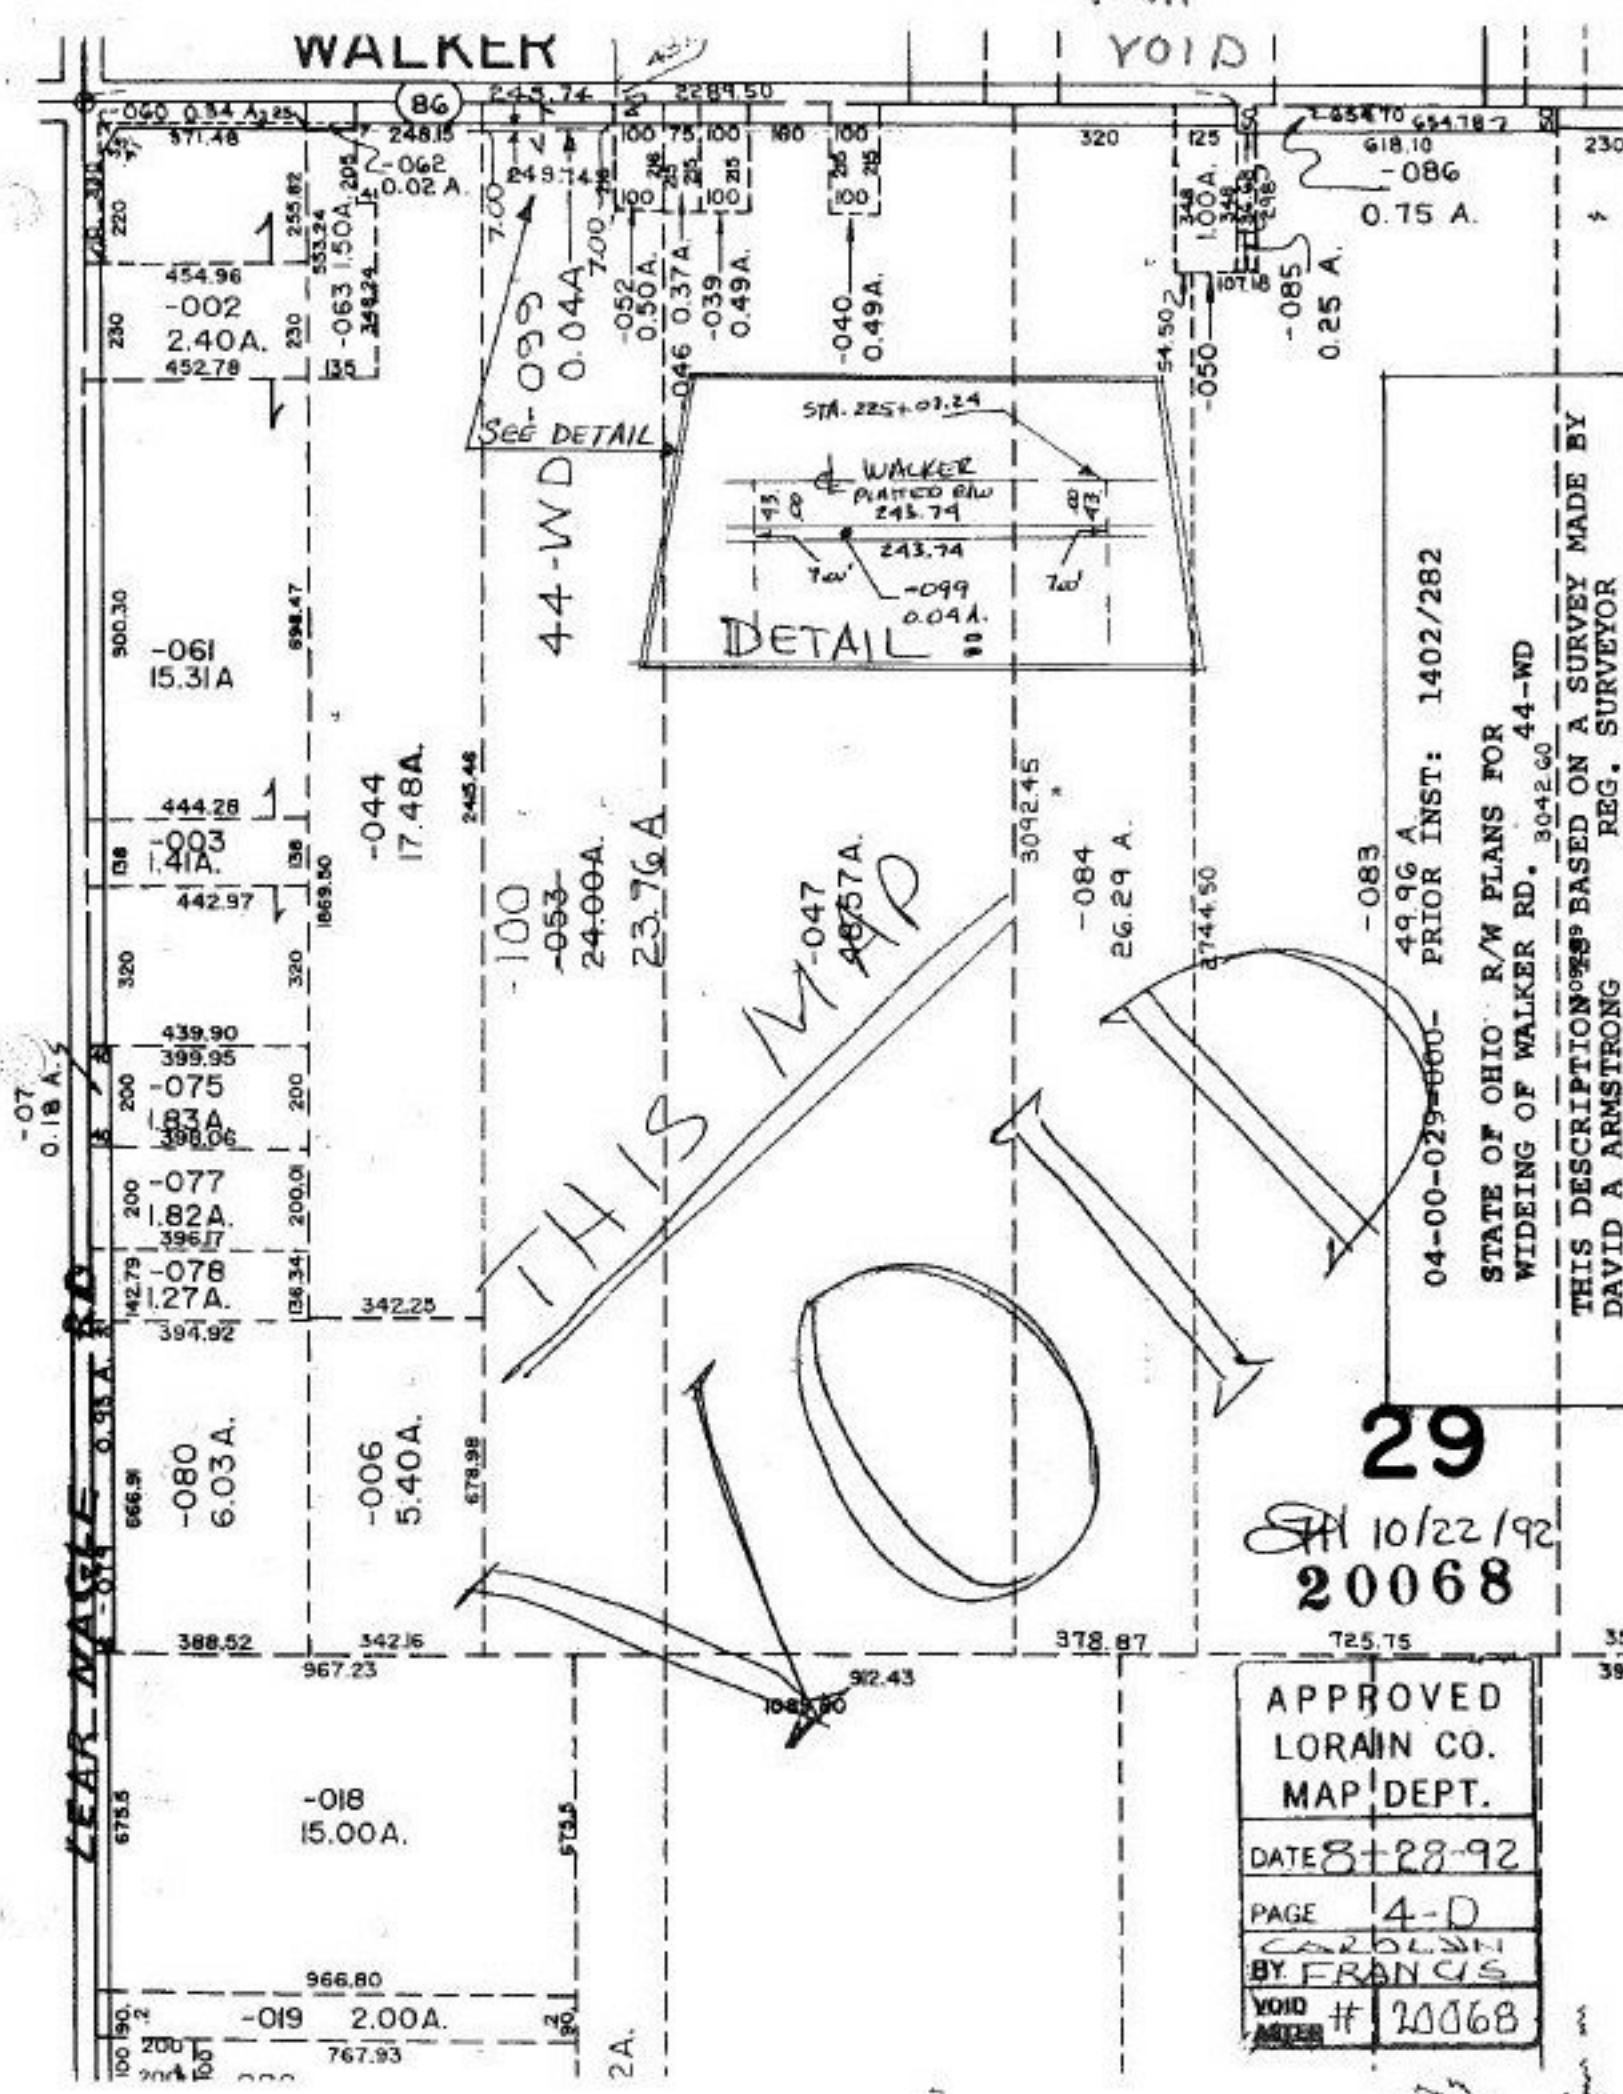

04-00-029-660- PRIOR INST: 1402/282

STATE OF OHIO R/W PLANS FOR  
WIDENING OF WALKER RD. 3042.60 44-WD  
THIS DESCRIPTION IS BASED ON A SURVEY MADE BY  
DAVID A ARMSTRONG REG. SURVEYOR

29

SH 10/22/92  
20068

APPROVED	LORAIN CO.
MAP DEPT.	
DATE	8-28-92
PAGE	4-D
BY	FRANCIS
VOID #	20068

-07  
0.18 A.

LEAR-WALKER RD  
0.95 A.

2A.

35;  
393