


-017  
6.28 A.

-029  
1.29 A.

3.85 A  
0.87 A  
2.98 A  
0.98 A  
2.00 A.

VOID PER TITLE CO.

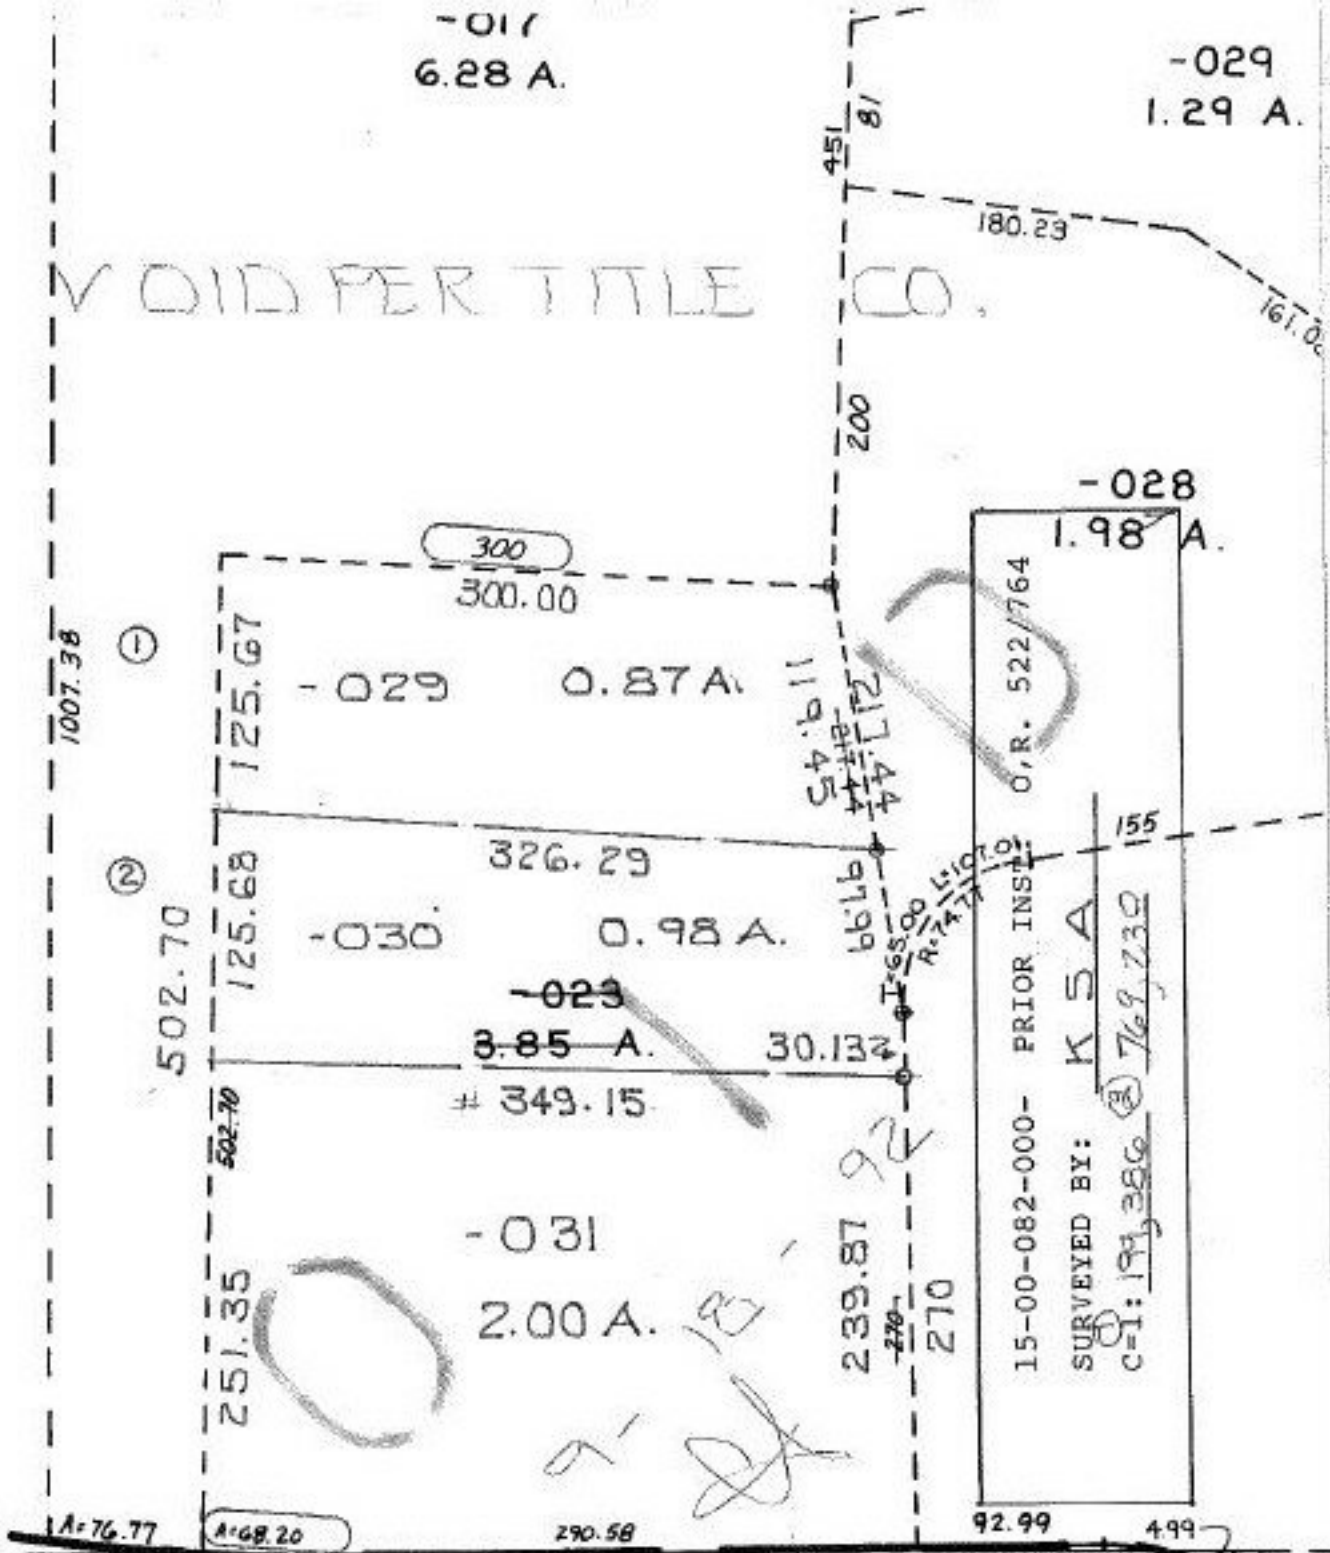

PHEASANT RUN DR.  
SEE 15-00-099-B

SUBLOT 14

20076

APPROVED  
LORAIN CO.  
MAP DEPT.

DATE 9-4-92

PAGE 15 00 082-13

BY 200 FRANCES

VOID 20076



DANCE TWD