


Leave line in

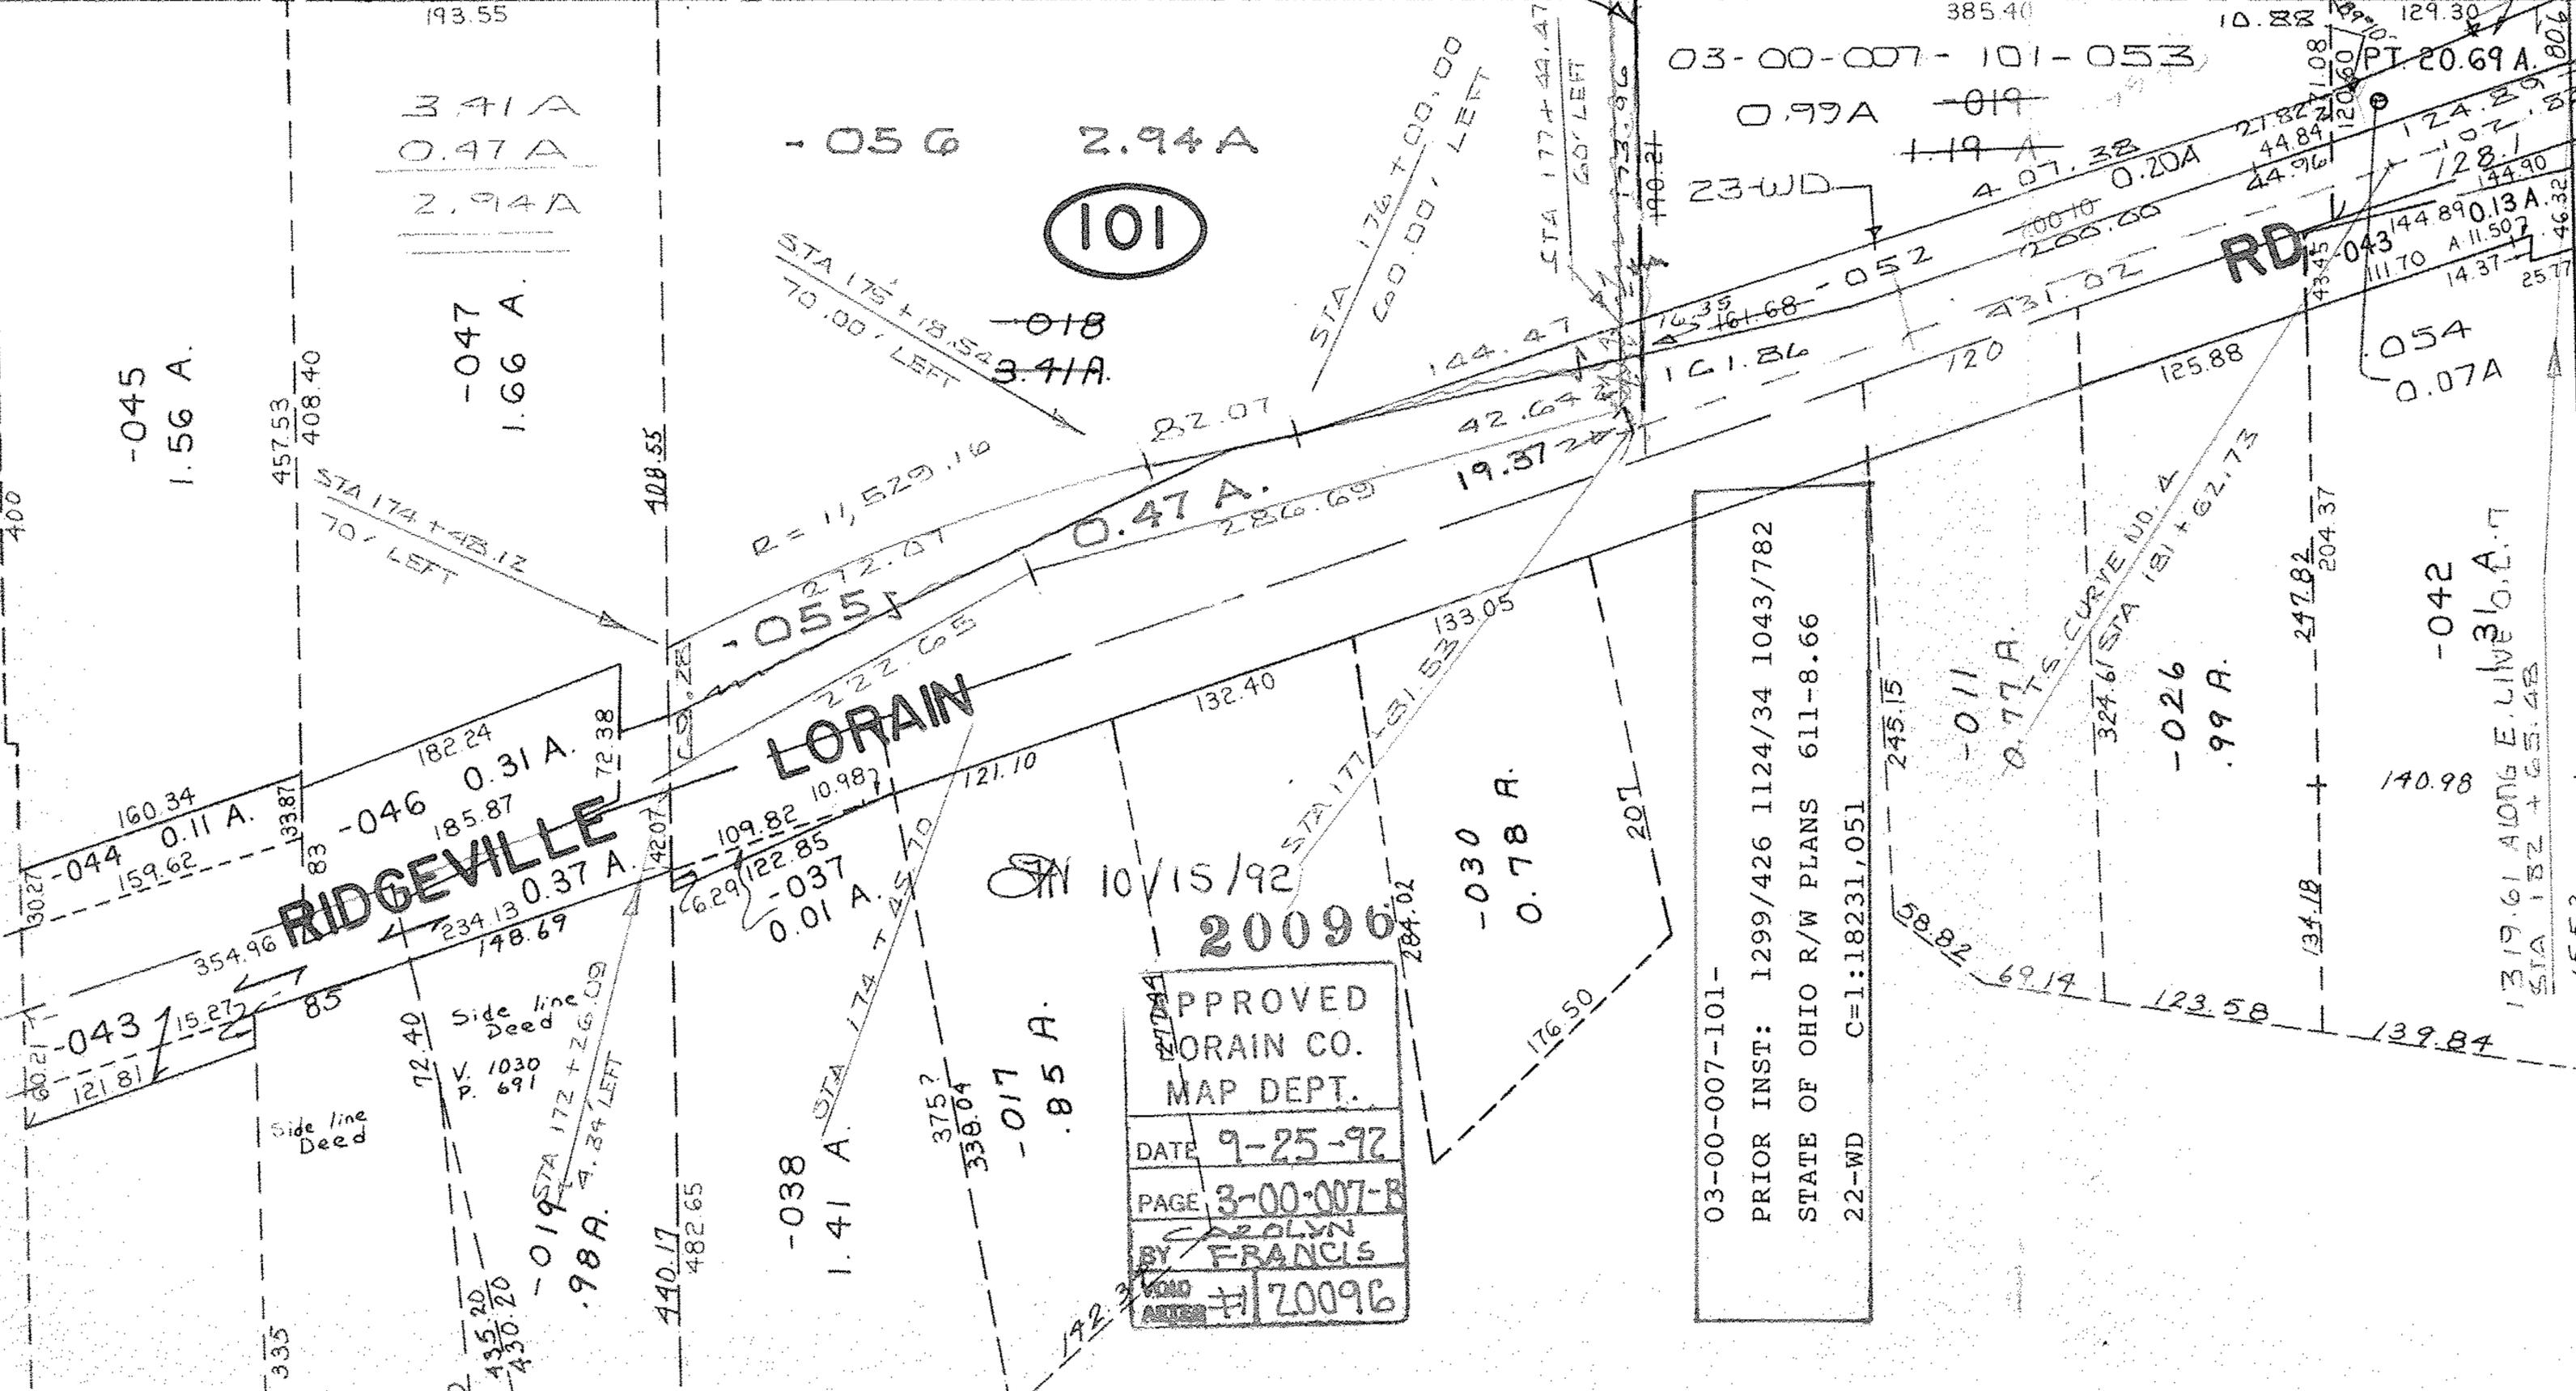

101

RIDGEVILLE

LORAIN

RD

APPROVED
 LORAIN CO.
 MAP DEPT.
 DATE 9-25-92
 PAGE 3-00-007-B
 BY FRANCIS
 # 20096

03-00-007-101-
 PRIOR INST: 1299/426 1124/34 1043/782
 STATE OF OHIO R/W PLANS 611-8.66
 22-WD C=1:18231,051

1319.61 ALONG E. LINE 36.4.7
 STA 182 + 65.48
 155.3

-045
1.56 A.

341A
0.47A
2.94A

-047
1.66 A.

-056 2.94A

018
3.41A

0.47A

03-00-007-101-053

0.99A -019

1.19A
4.07.38
0.20A

10.88
129.30
PT. 20.69A
128.1
144.90
144.89
11.70
14.37
25.77

054
0.07A

043
15.27
121.81
354.96
133.87
83
160.34
0.11 A.
182.24
185.87
0.31 A.
72.38
234.13
148.69
0.37 A.

Side line Deed

Side line Deed

019
98A
4.34 LEFT
430.20
435.20

-038
1.41 A.

375?
339.04

-017
85 A.

10/15/92
20096

-030
0.78 A.

03-00-007-101-

PRIOR INST: 1299/426 1124/34 1043/782

STATE OF OHIO R/W PLANS 611-8.66

22-WD C=1:18231,051

245.15

-011
0.77A.

-026
.99 A.

140.98

-042

400

335

440.17
482.65

192.3

284.02

176.50

207

58.82

69.19

123.58

134.18

139.84

457.53
408.40

STA 174 + 42.12
70' LEFT

408.55

R = 11,529.16
272.07

82.07

42.64

19.37

STA 176 + 00.00
60' LEFT

STA 177 + 44.47
60' LEFT

173.86
190.21

23-WD

200.00
200.00

431.02

125.88

247.82
204.37

128.1

144.90

11.70
14.37

25.77

193.55

385.40

10.88

129.30

120.60

120.60

