


GRAFTON - EASTERN

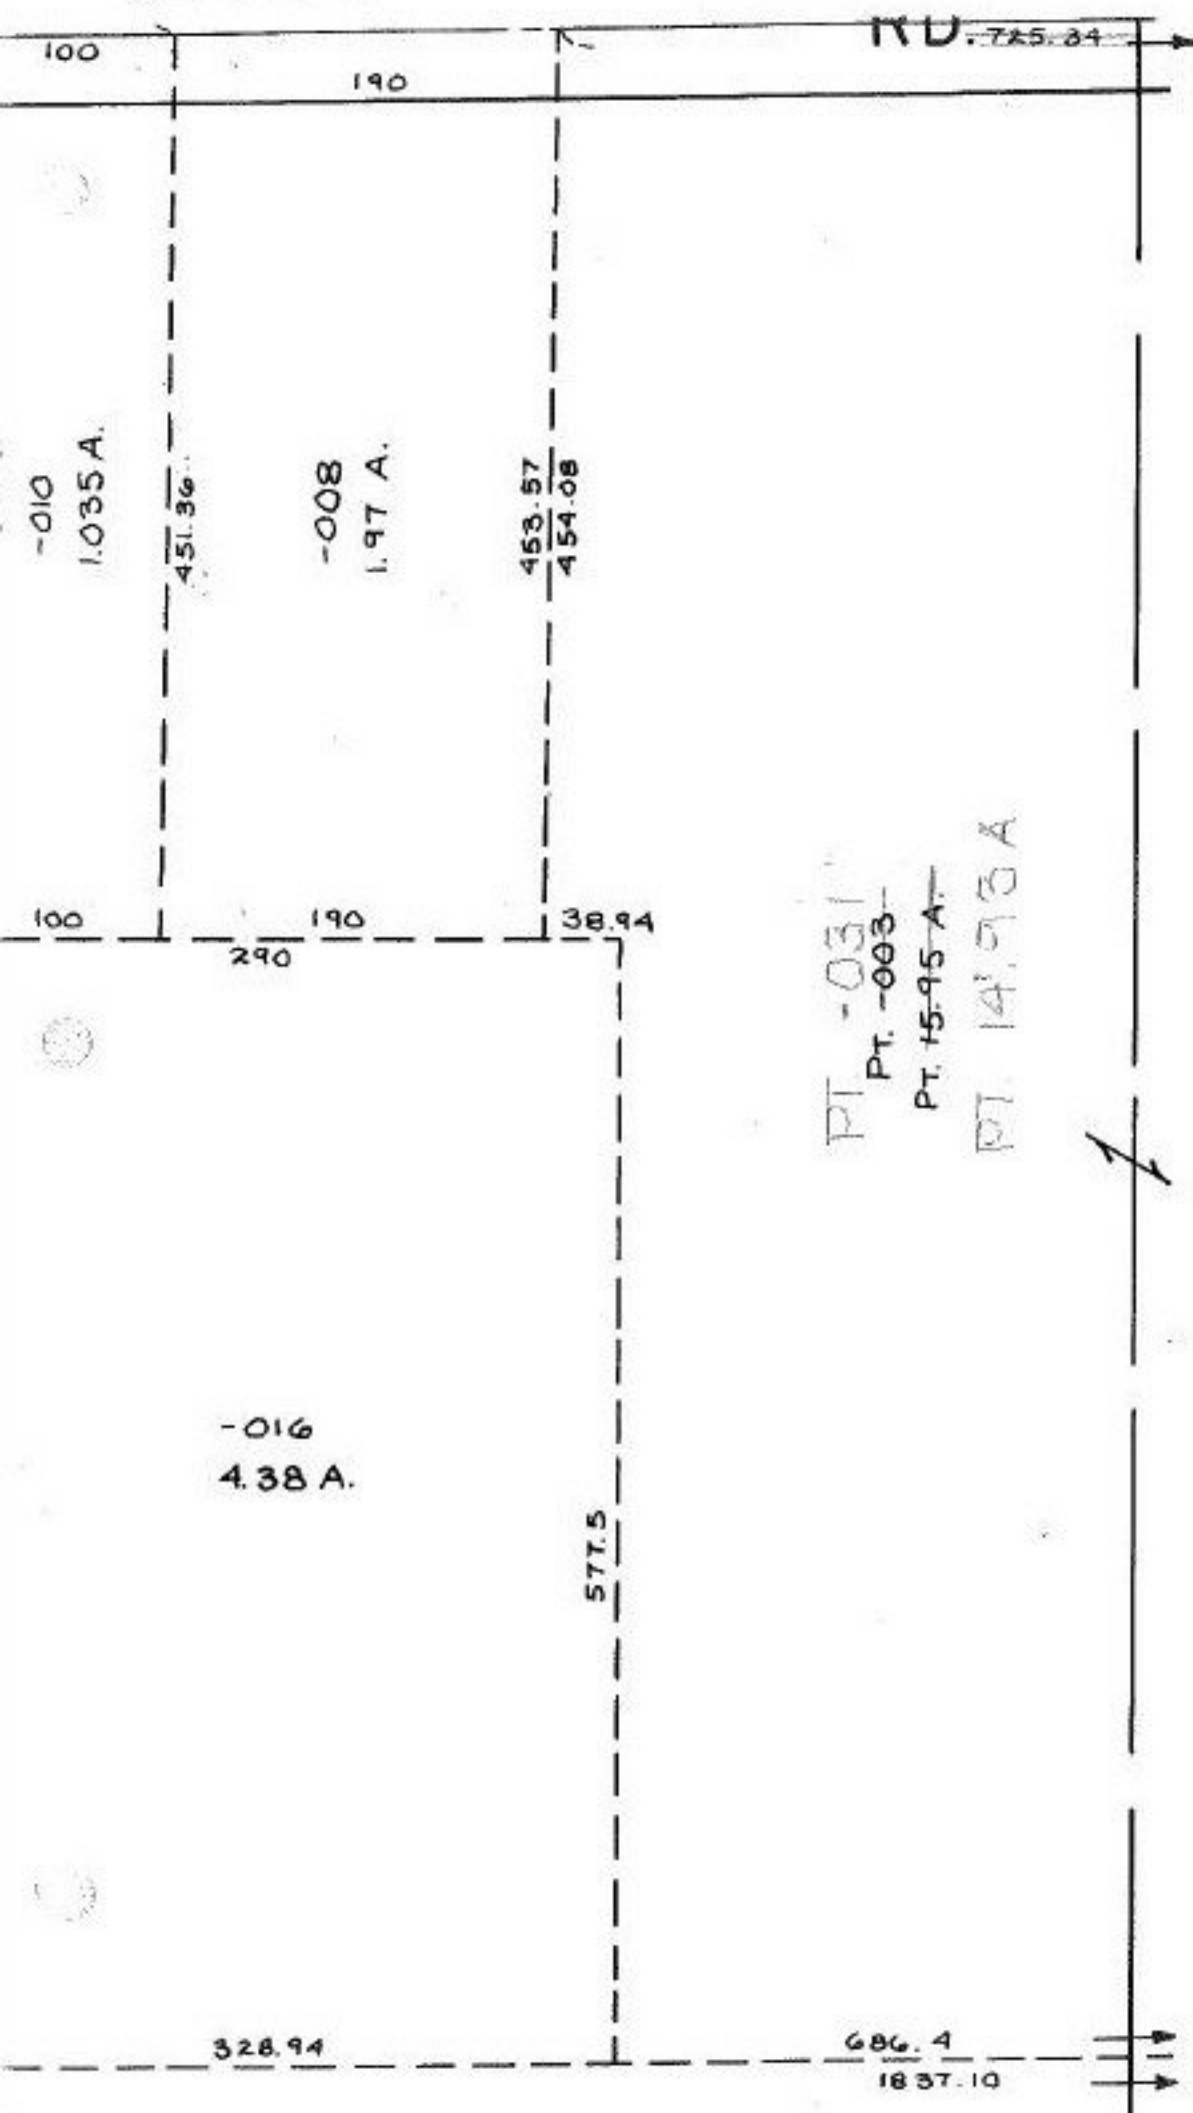

16-00-026-000- PRIOR INST: O.R. 178/775

10/29/92
20101

APPROVED	
LORAIN CO.	
MAP DEPT.	
DATE 10-6-92	
PAGE 16-00-026-000 A	
BY FRANCIS	
VOID AFTER	20101

1