

C/E 14-E

ASHLAND COBERLIN RD

-002  
68.10 A.

45

-004  
29.68 A.

9.00 A  
4.55A  
4.55A  
4.56A. AC. CORR.  
PER SURVEY BY  
DANE A HAPONEK  
REG SURVEYOR  
C=1:1000,000 REMANDED  
-cl. 1:333,333


Met.

HUGHES

(60)

275.81  
278.89  
854-016  
21.59 A  
240.73

-001  
41.66 A.

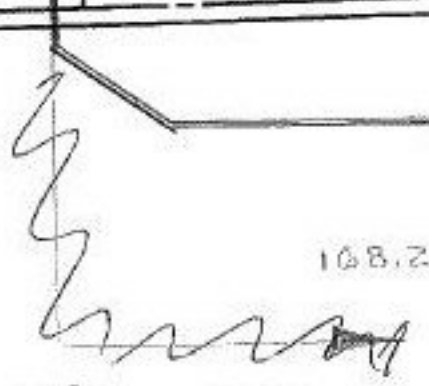

56

790.10

1308.42

264.07

518.24  
-003  
4.55A  
349.20  
-004  
1.00A  
349  
125.00  
108.21  
517.21  
-005  
4.56A  
9.00A  
518.30  
516.23

ACREAGE  
CORRECTION  
PER  
SURVEY

1263.30

-008  
35.90 A.

1308.41  
-006  
6.00 A.  
1308.41  
-007  
6.00 A.  
1308.41

2565

14-00-056-000- PRIOR INST: 1258/201  
SURVEYED BY: DANE A. HAPONEK REG. SURVEYOR  
C=1:333,333. REM:C=1:1000,000.

-005 2.00A

10/29/92

20106

65

-001  
148.57A.

APPROVED  
LORAIN CO.  
MAP DEPT.  
DATE 10-7-92  
PAGE 14 C  
BY CAROLYN FRANCIS  
VOID AFTER 12/10/92