


CUYAHOGA

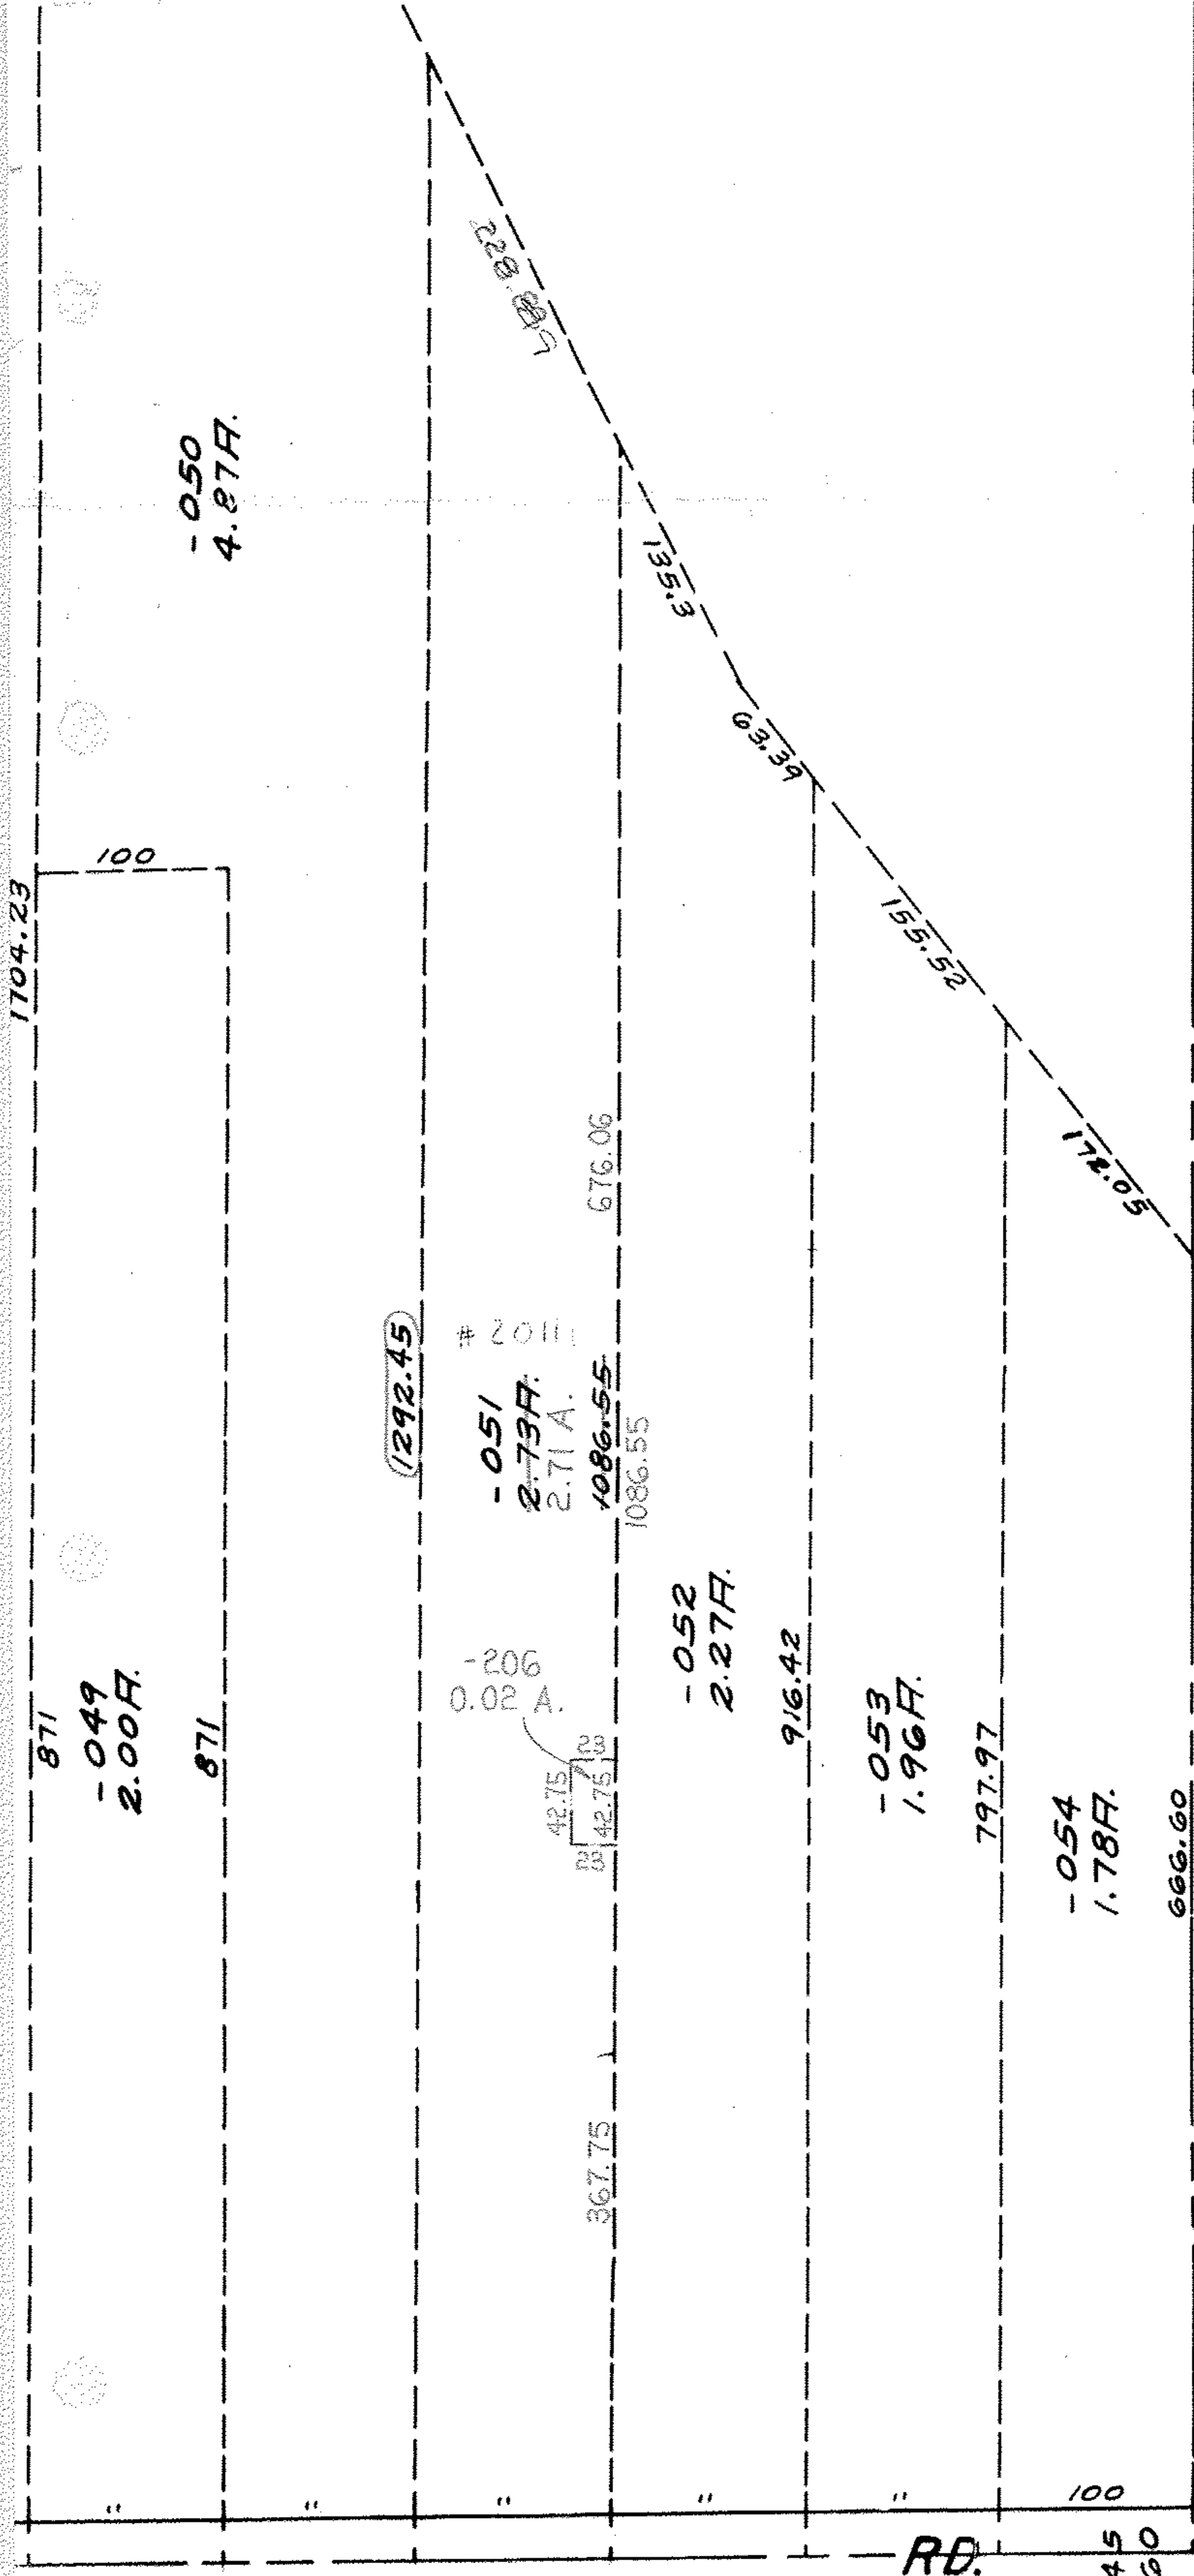

ACREAGE
CORRECTION \$
ADD TO DUPLICATE
12/11/92
#20111

APPROVED LORAIN CO. MAP DEPT.	
DATE 11-18-92	
PAGE 4-00-025-H	
BY T. HOLLIS	
VOID AFTER	20111

RD. 450