


SEE 5-00-059-A

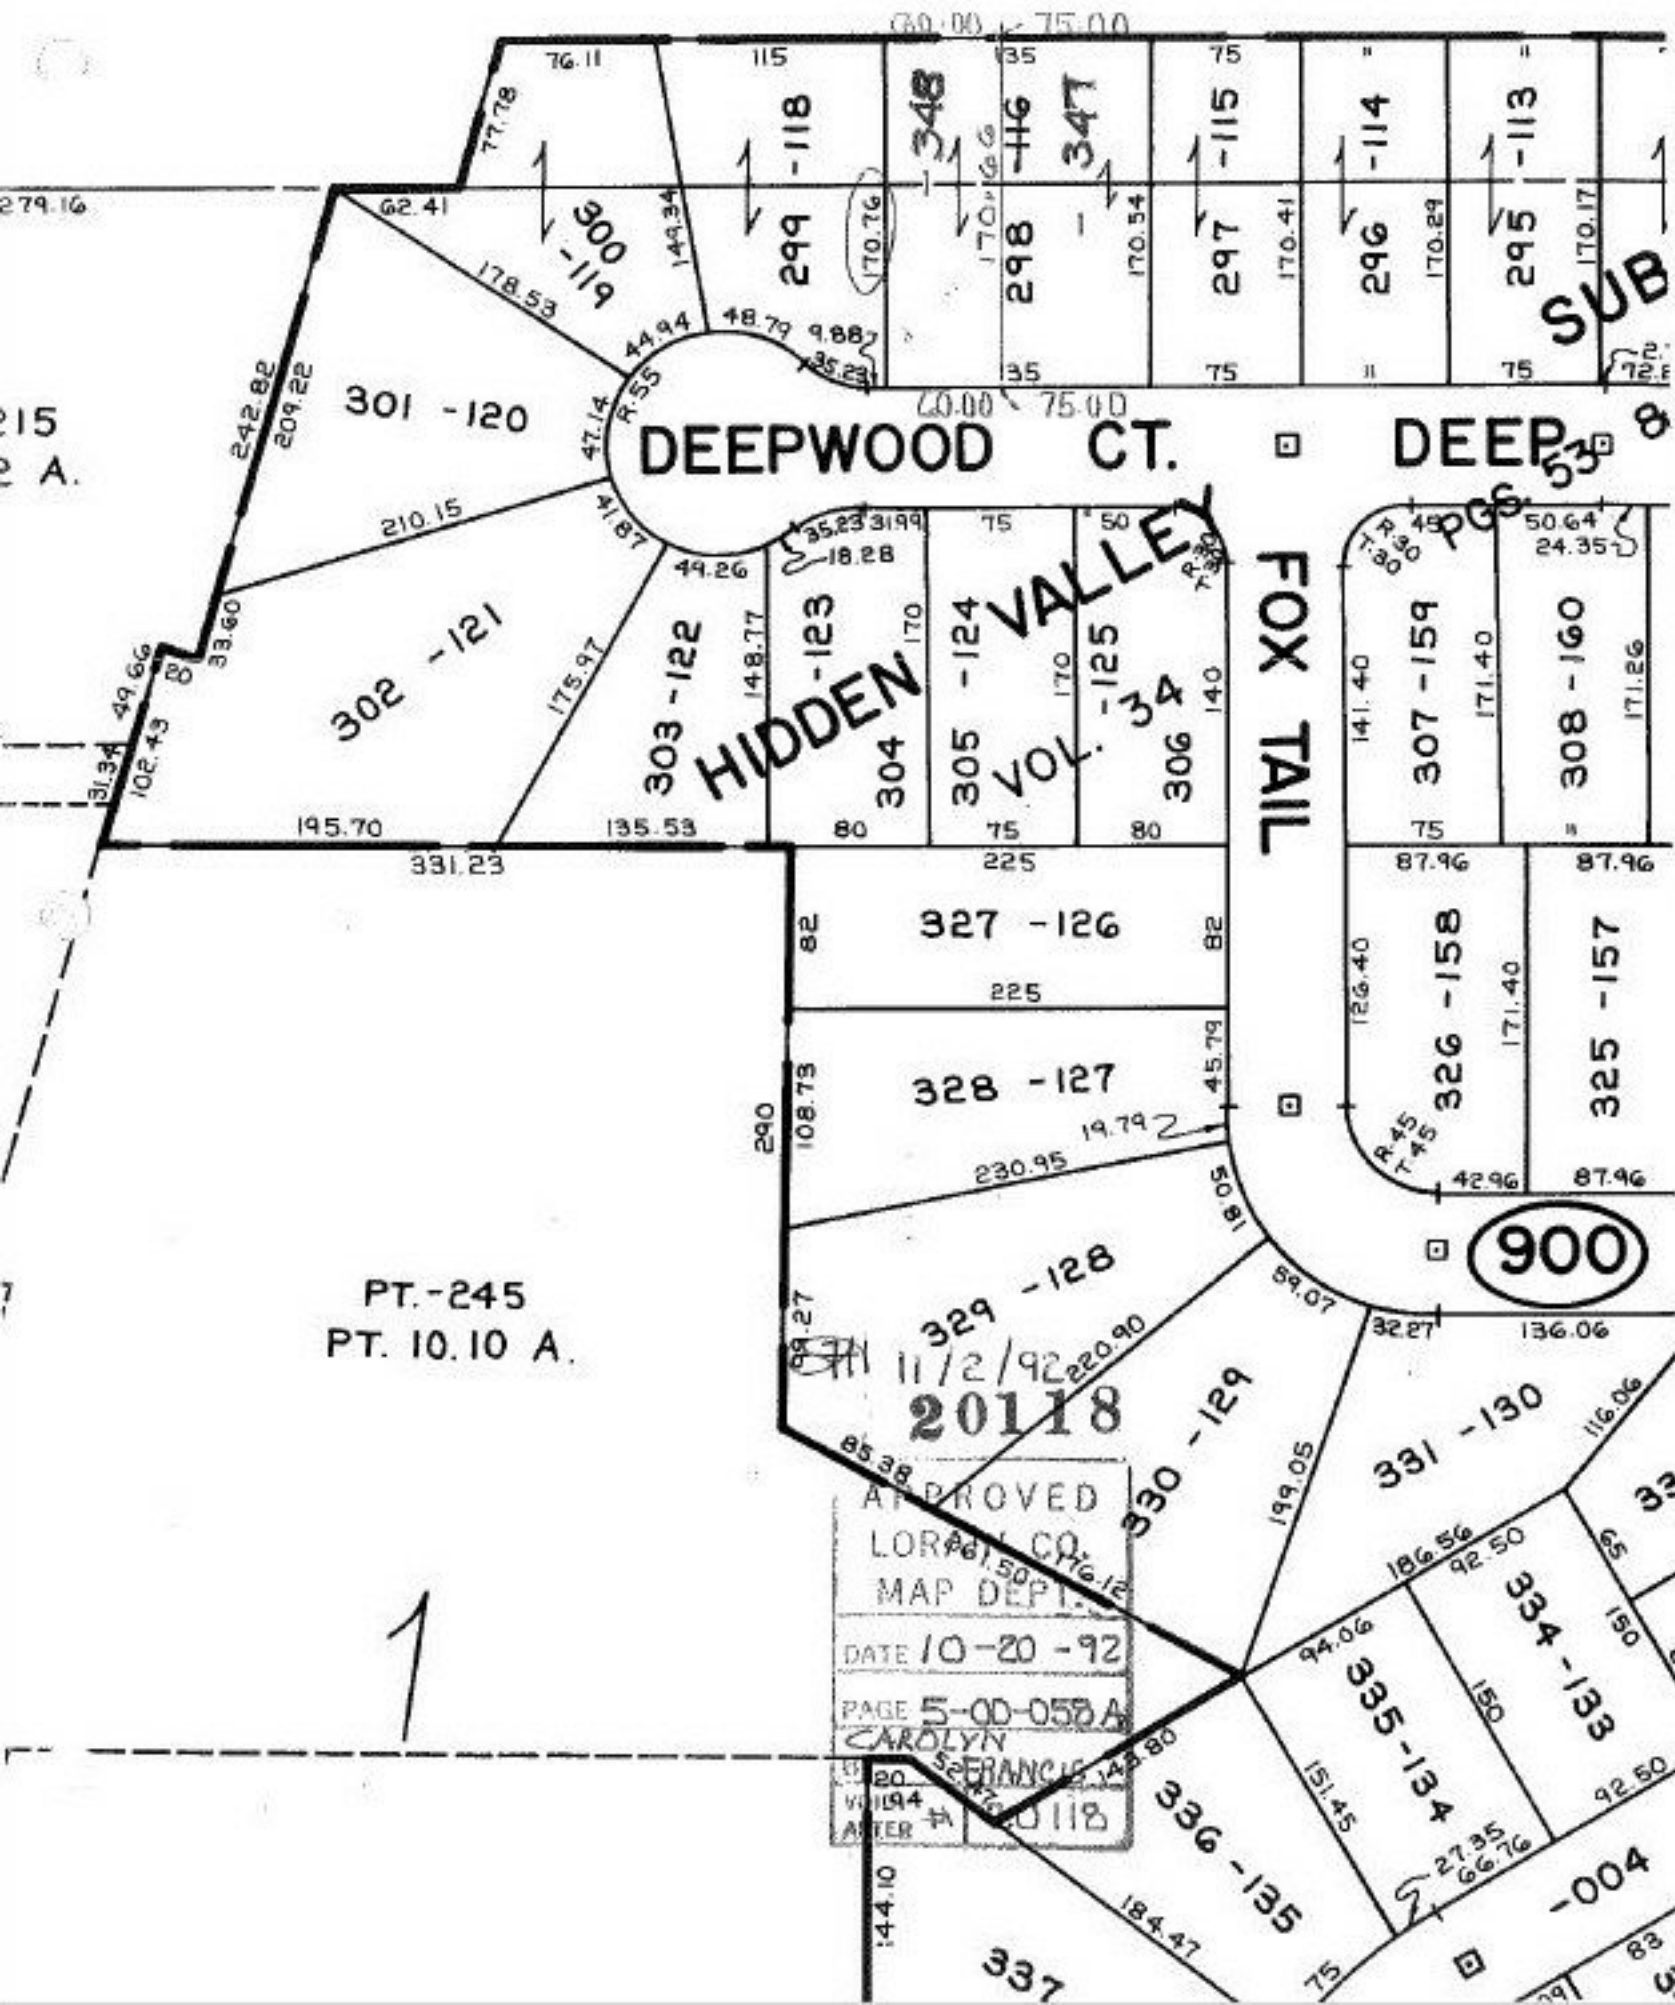

PT.-245  
PT. 10.10 A.

APPROVED  
LORAIN CO.  
MAP DEPT.  
DATE 10-20-92  
PAGE 5-00-059-A  
CAROLYN  
FRANCIS  
11/2/92  
20118

SUB

900

HIDDEN VALLEY  
VOL. 34

FOX TAIL

DEEPWOOD CT.

DEEPWOOD CT.

1