


2013

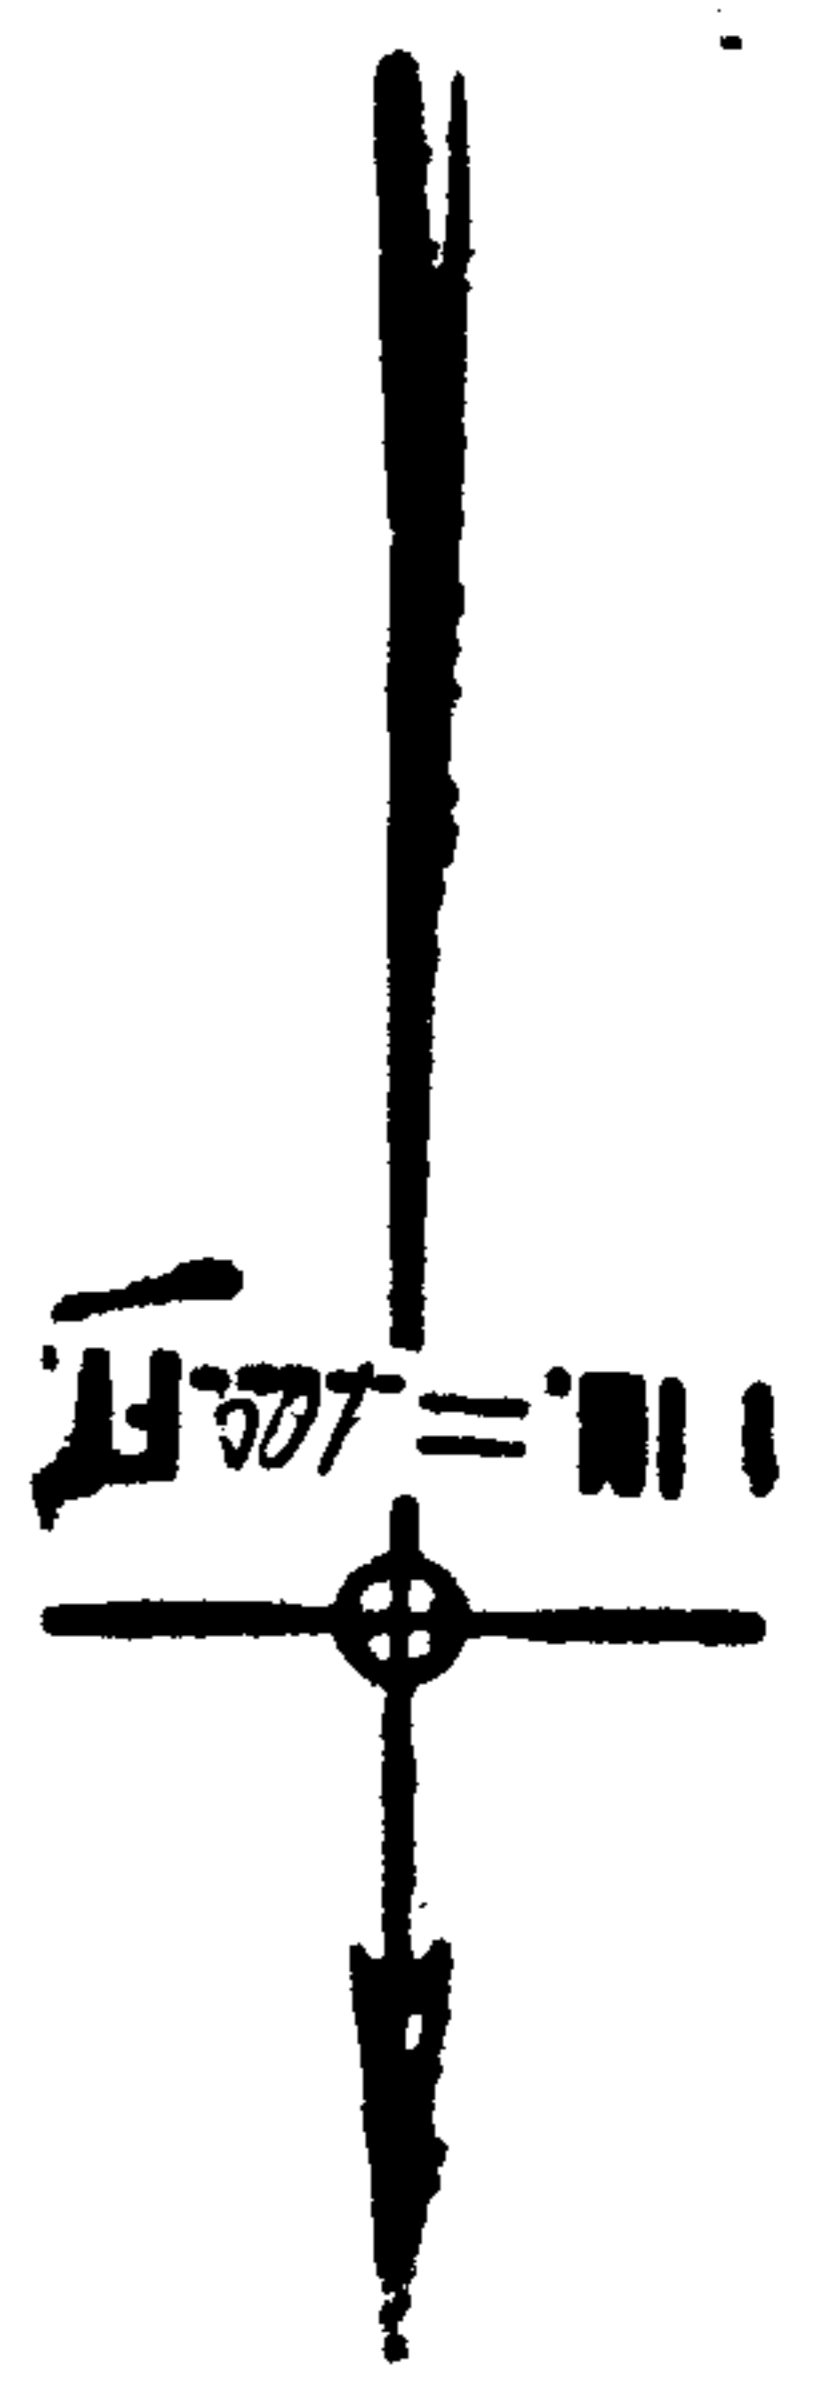

APPROVED
LORAIN CO.
MAP DEPT.
DATE 8-8-68
6-125
BY *[Signature]*

1375.44

[Signature]
9/15/68
R.K.

-035-

~~032~~
~~8.95A~~
8.93A

947.90

Pt. - 016
Pt. 13.32H.

410.70

160 - 017
160 .23H.

[Handwritten notes and numbers]
114.76
108.35
392.69
403.20
628.66

SUGAR RIDGE

2
-0
.5
2
-00
62