


VALKER RD.
2943.29 TO CL. LEAR MACH.
INT. (FROM)

RD.

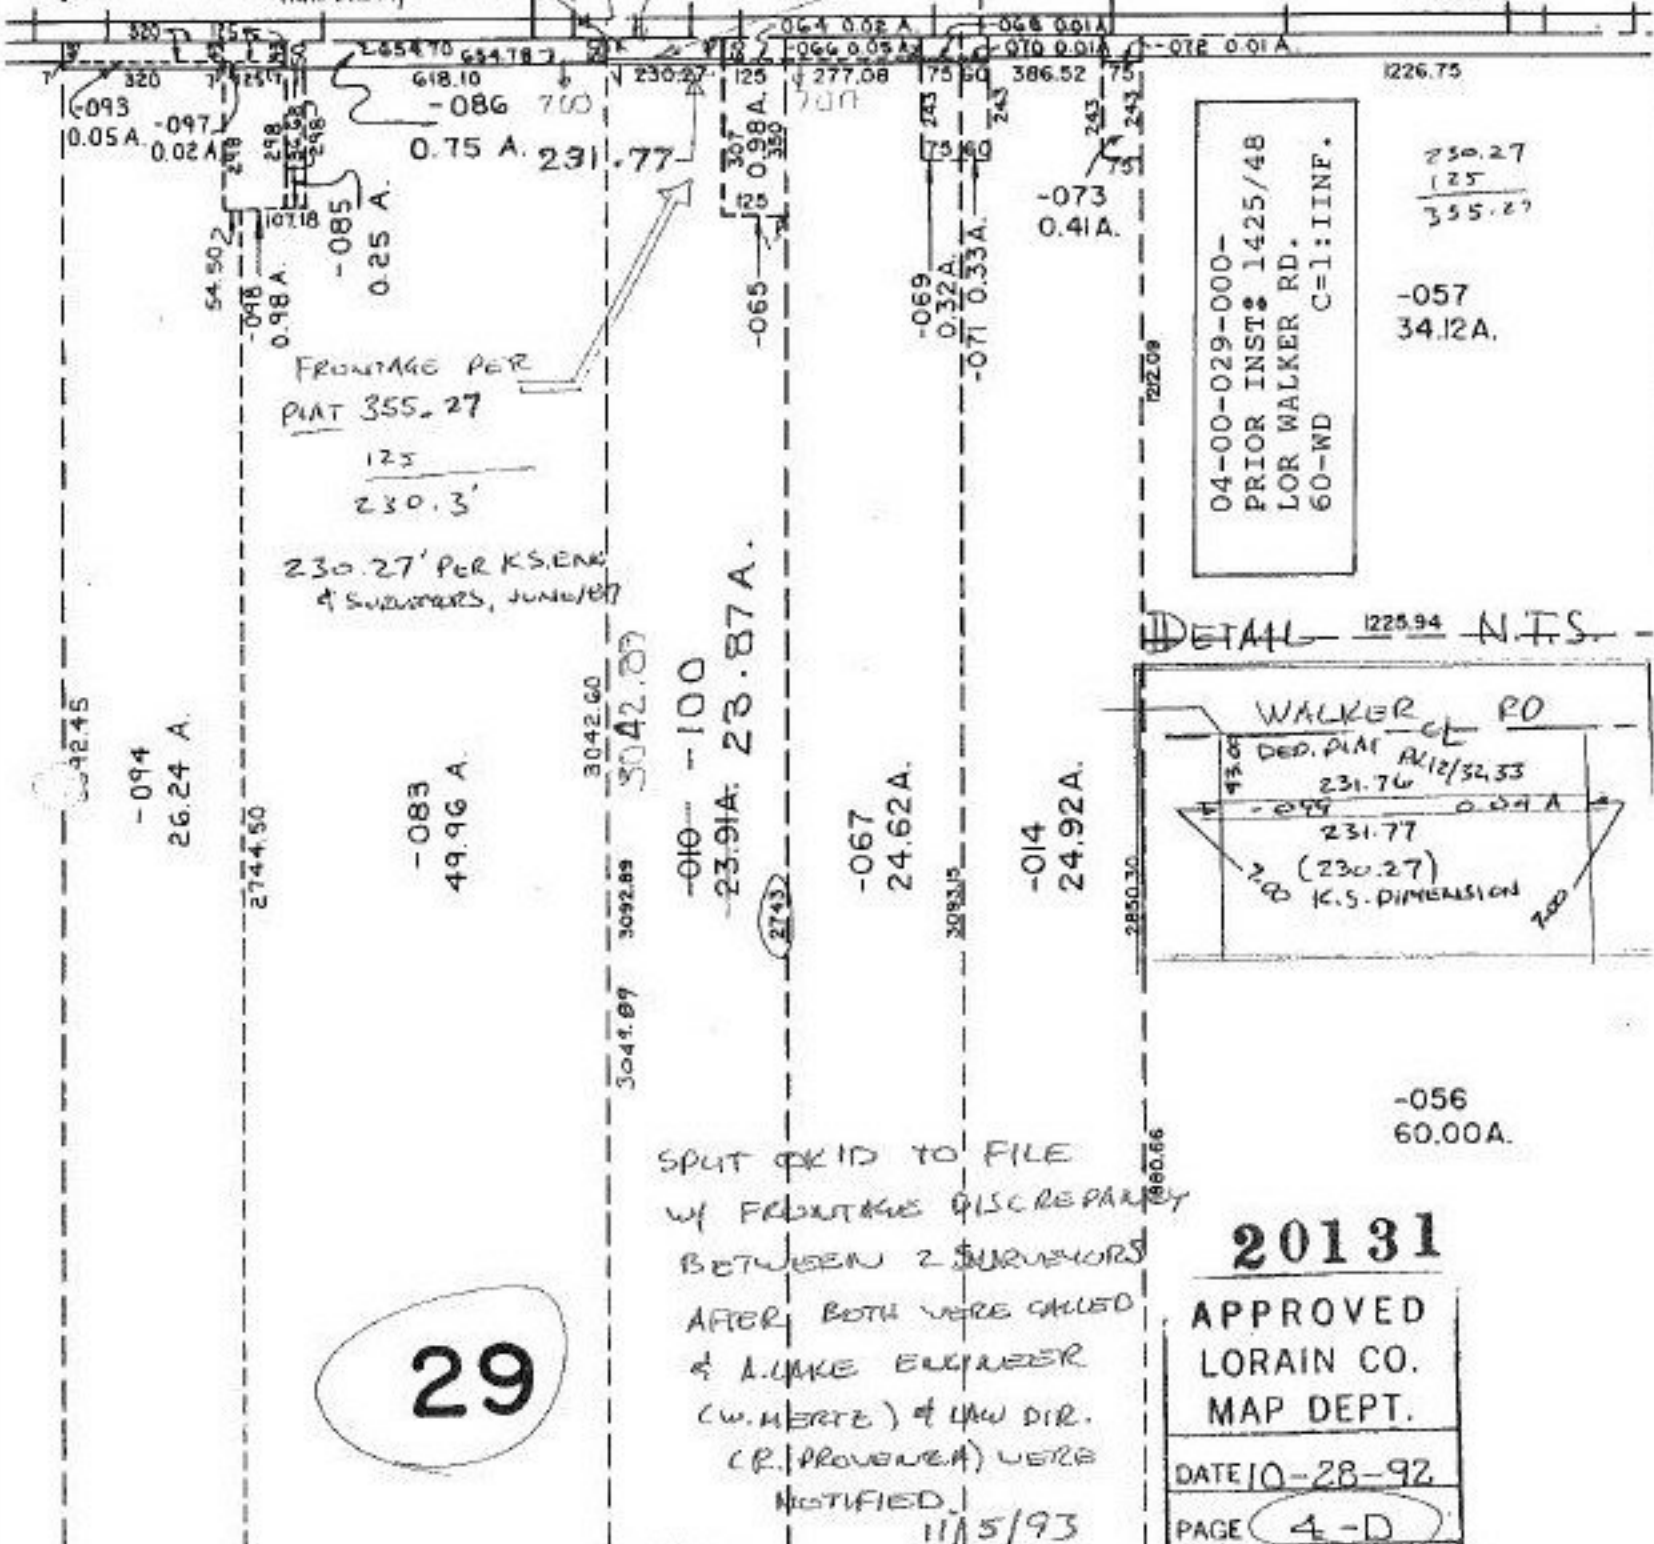

FRONTAGE PER
PLAT 355.27

125
230.27


230.27' PER K.S. DIM.
& SURVEYORS, JUNE 1987

04-00-029-000-
PRIOR INST# 1425/48
LOR WALKER RD.
60-WD C=1:1 INF.

230.27
125
355.27

-057
34.12A.

DETAIL 1225.94 N.T.S.

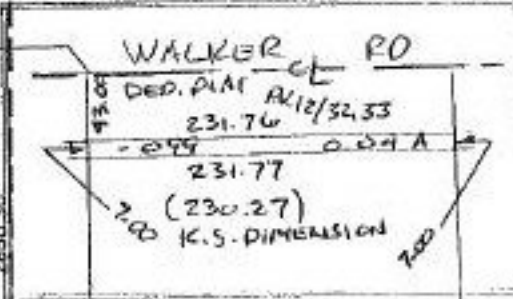

-056
60.00A.

SPUT PK ID TO FILE
W/ FRONTAGE DISCREPANCY
BETWEEN 2 SURVEYORS
AFTER BOTH WERE CALLED
& A. LAKE ENGINEER
(W. WERTZ) & LAW DIR.
(R. PROVONA) WERE
NOTIFIED.
11/5/93

29

20131
APPROVED
LORAIN CO.
MAP DEPT.

DATE 10-28-92

PAGE 4-D

BY CAROLYN FRANKS

VOID
AFTER # 20131

KEEP THIS IN SURVEY
BANK FILE.

230.27
125
355.27
PLAT
355.27