


**ELECTRIC**

**BEACHDALE**

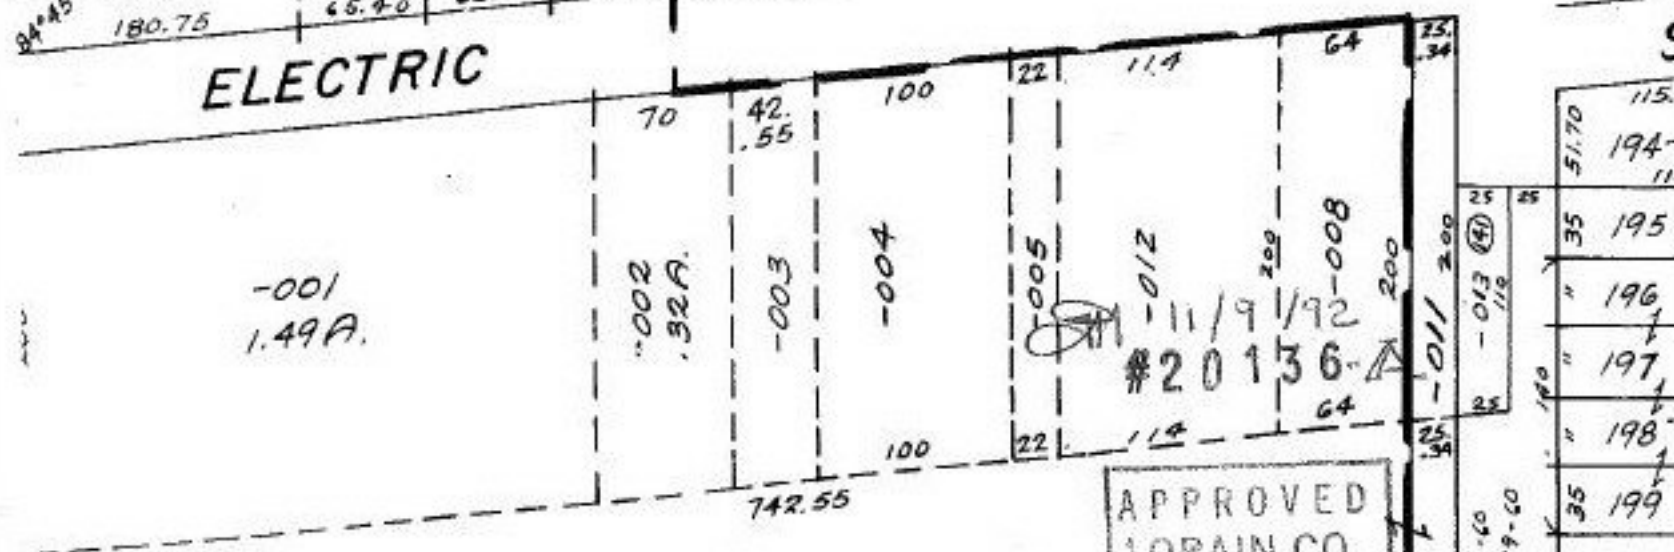

REF. PU 13/24-25

No. 4088 Pg 228

TRANSFER SHEET 11/17/69

Pg. 124 # 5367

Pg. 116 # 3482

UNCOMBINATION  
REVIEWED/DENIED

**141**

APPROVED  
LORAIN CO.  
MAP DEPT.  
DATE 11-2-92  
PAGE 40008-c  
BY T. Monahan  
VOID AFTER 20136A

758.05  
737.75  
559.68  
3-14-60  
/ACATED ORD. NO. 19-60  
118  
25  
190  
35  
40  
44  
115  
194  
195  
196  
197  
198  
199  
200  
201  
202  
203