


80 -017
81 -018
82 -019
83 -020
84 -021
85 -022
86 -023

MEADOWS STREET
-003 2.62 A. LANE VOL.44 PGS.19-25 60

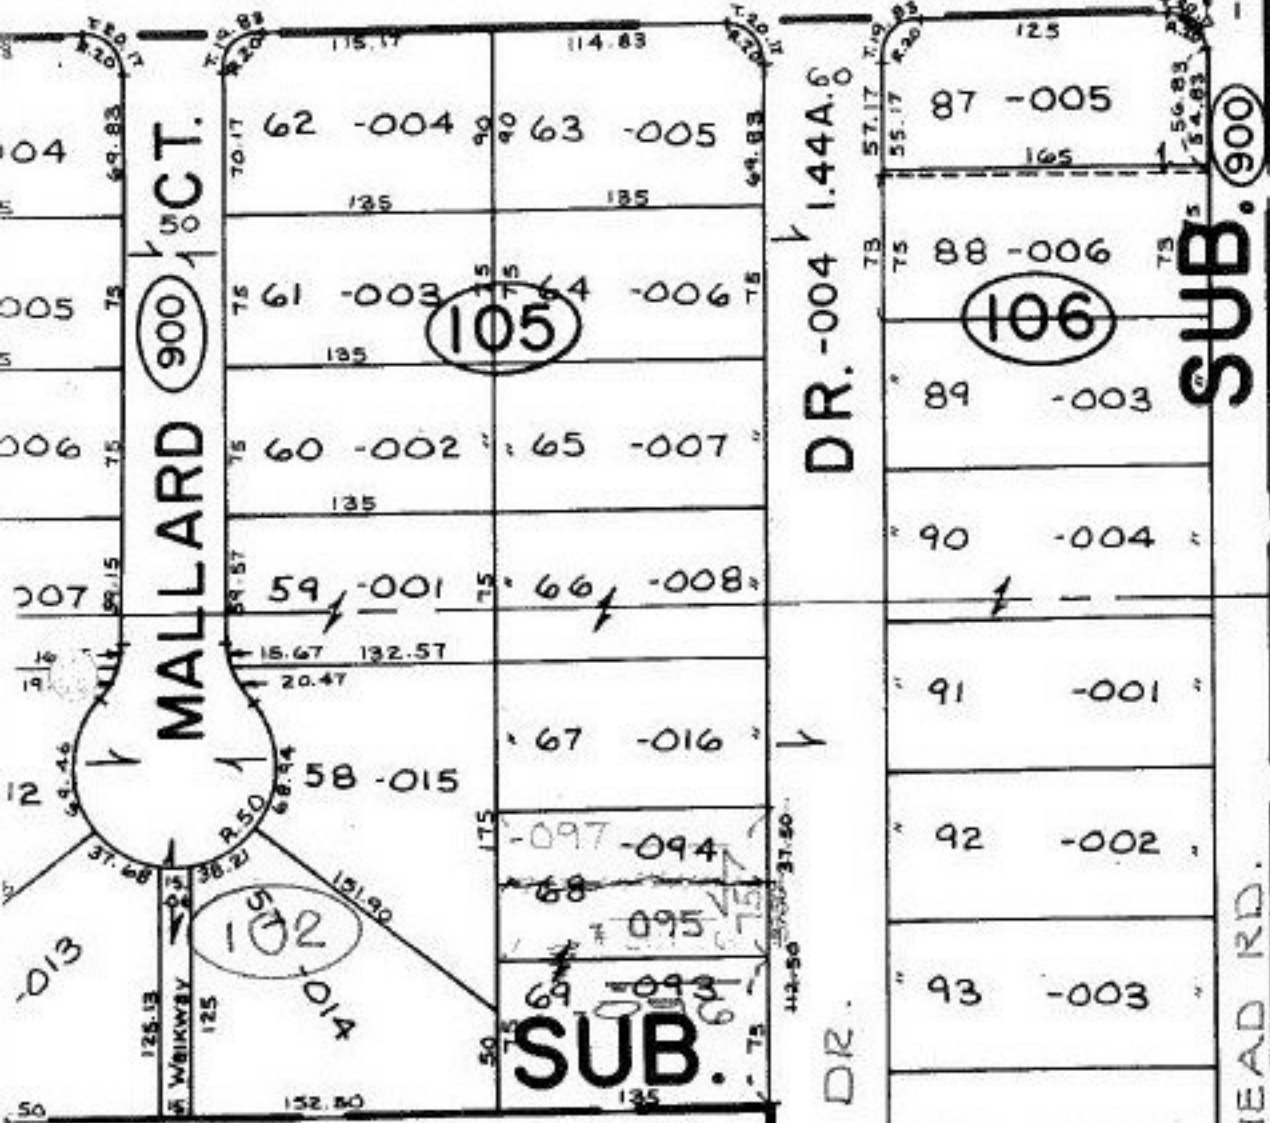

RD.

PRIOR INST: O.R.568/275

15-00-098-102-

COMB.

SPLIT

10/30/92
20136

APPROVED
LORAIN CO.
MAP DEPT.
DATE 10-28-92
PAGE 15-00-098-B
BY CAROLYN FRANCIS
VEND AFTER \$ 20136

SPLIT OUT OF -093
COMBINATION OF: -094
095

FAIRWAY DR.

WHITEHEAD RD.

DR.-004 1.44A.6

SUB. 900

SUB.

103