
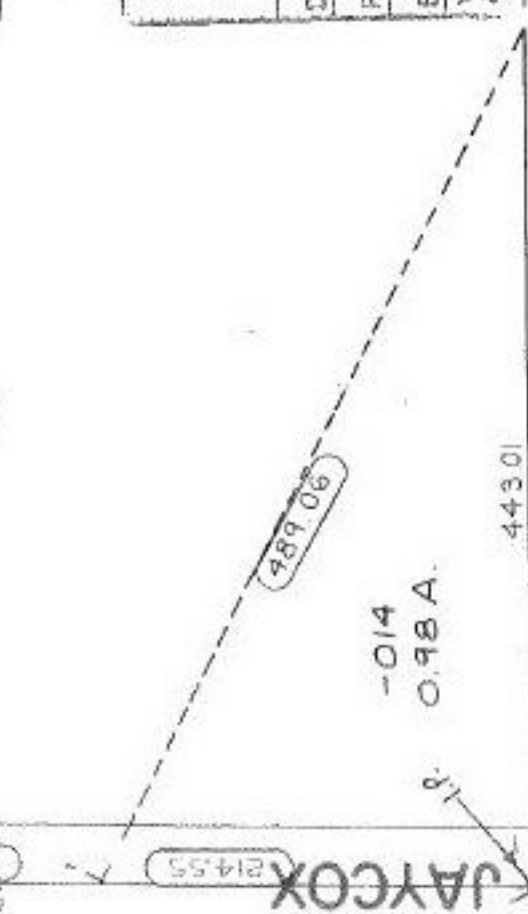


1752

SUBT. 1504.31 1745.70
DEED - 1503.71

28.02 A
1.00 A
27.02 A

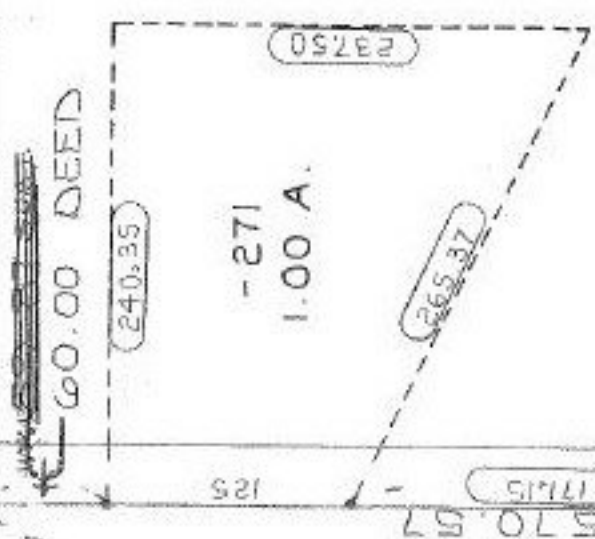

- 274
27.02 A 28.02 A

~~272~~

749.10 EAST LINE

SA 11/19/92
20139

07-00-018-101-
PRIOR INST: O.R. 538/55
surveyed by: John Hancock
reg. surveyor C=1:52,508

APPROVED
LORAIN CO.
MAP. DEPT.
DATE 11-2-92
PAGE 7-00-018.C
BY CAROLYN B. BRANGLER
VOID AFTER # 20139

1302.69

1745.70

SEE 7-00-017-A

JAYCOX