


SPRAGUE RD

RD.

RD.

COUNTY MARKS RD.

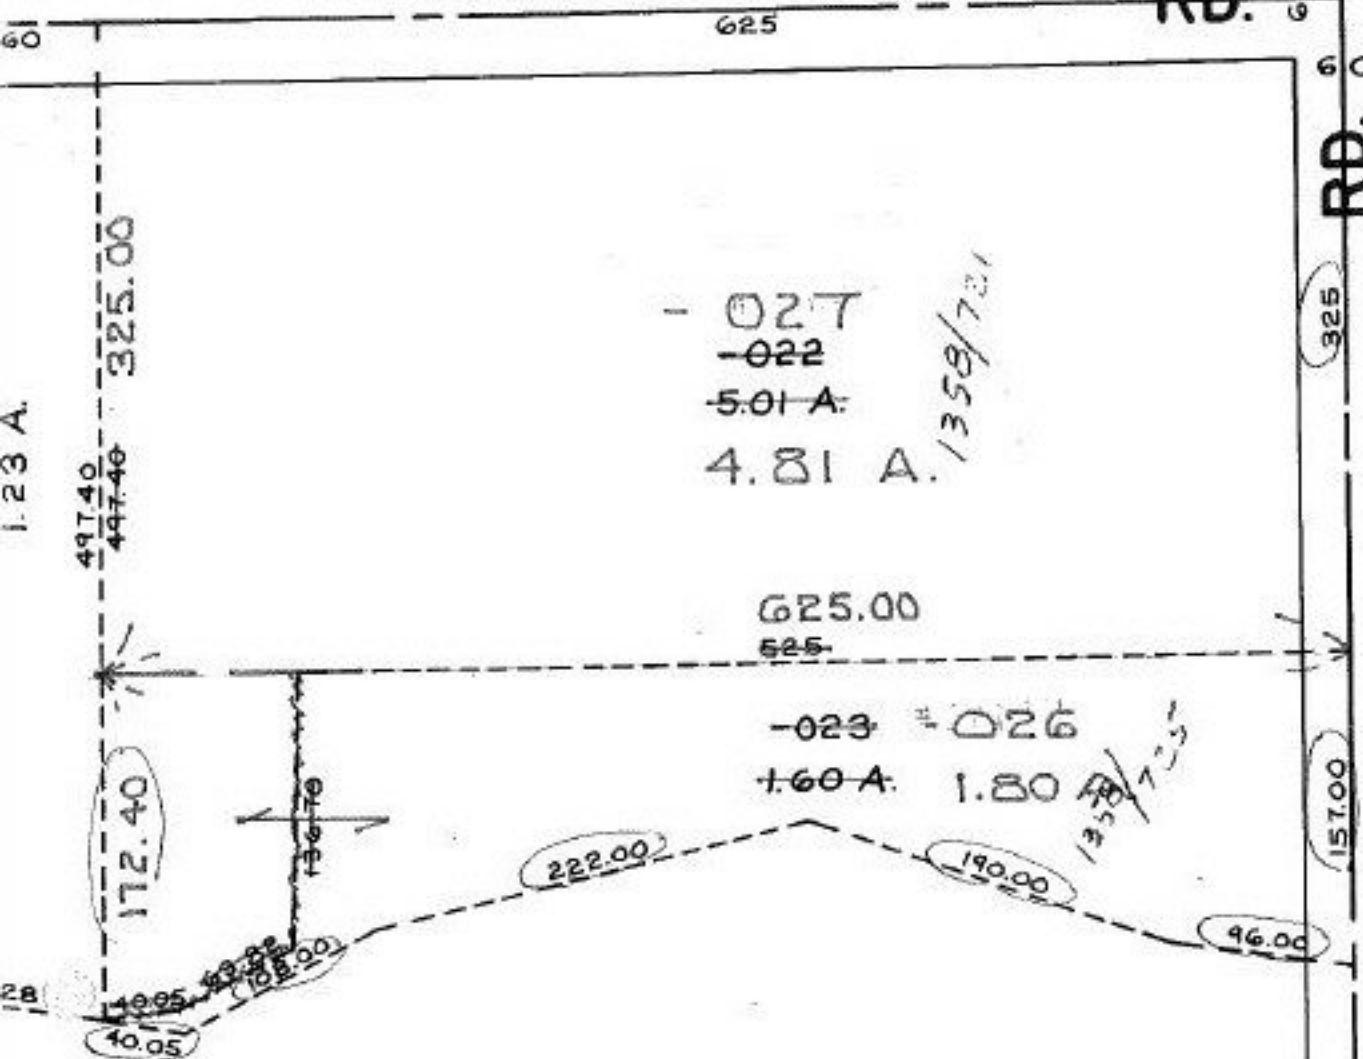

- 027  
 - 022  
 5.01 A  
 4.81 A

625.00  
 625

- 023 = 026  
 1.60 A 1.80

172.40

190.00

222.00

46.00

10.05  
 10.95  
 10.22  
 10.00

1.23 A

497.40  
 447.40  
 325.00

5.01A	6.61A
1.60A	1.80A
6.61A	4.81A

12-00-001-000- PRIOR INST: 1358/721  
 SURVEYED BY: JOHN POZYWAK REG. SURVEYOR  
 C-1: INF.

1991 2/5/93  
 20149

APPROVED  
 LORAIN CO.  
 MAP DEPT.  
 DATE 11-17-92  
 PAGE 12-00-001-B  
 CAROLYN  
 BY FRANCIS  
 VOID AFTER # 20149