


SEE 3-00-017-B

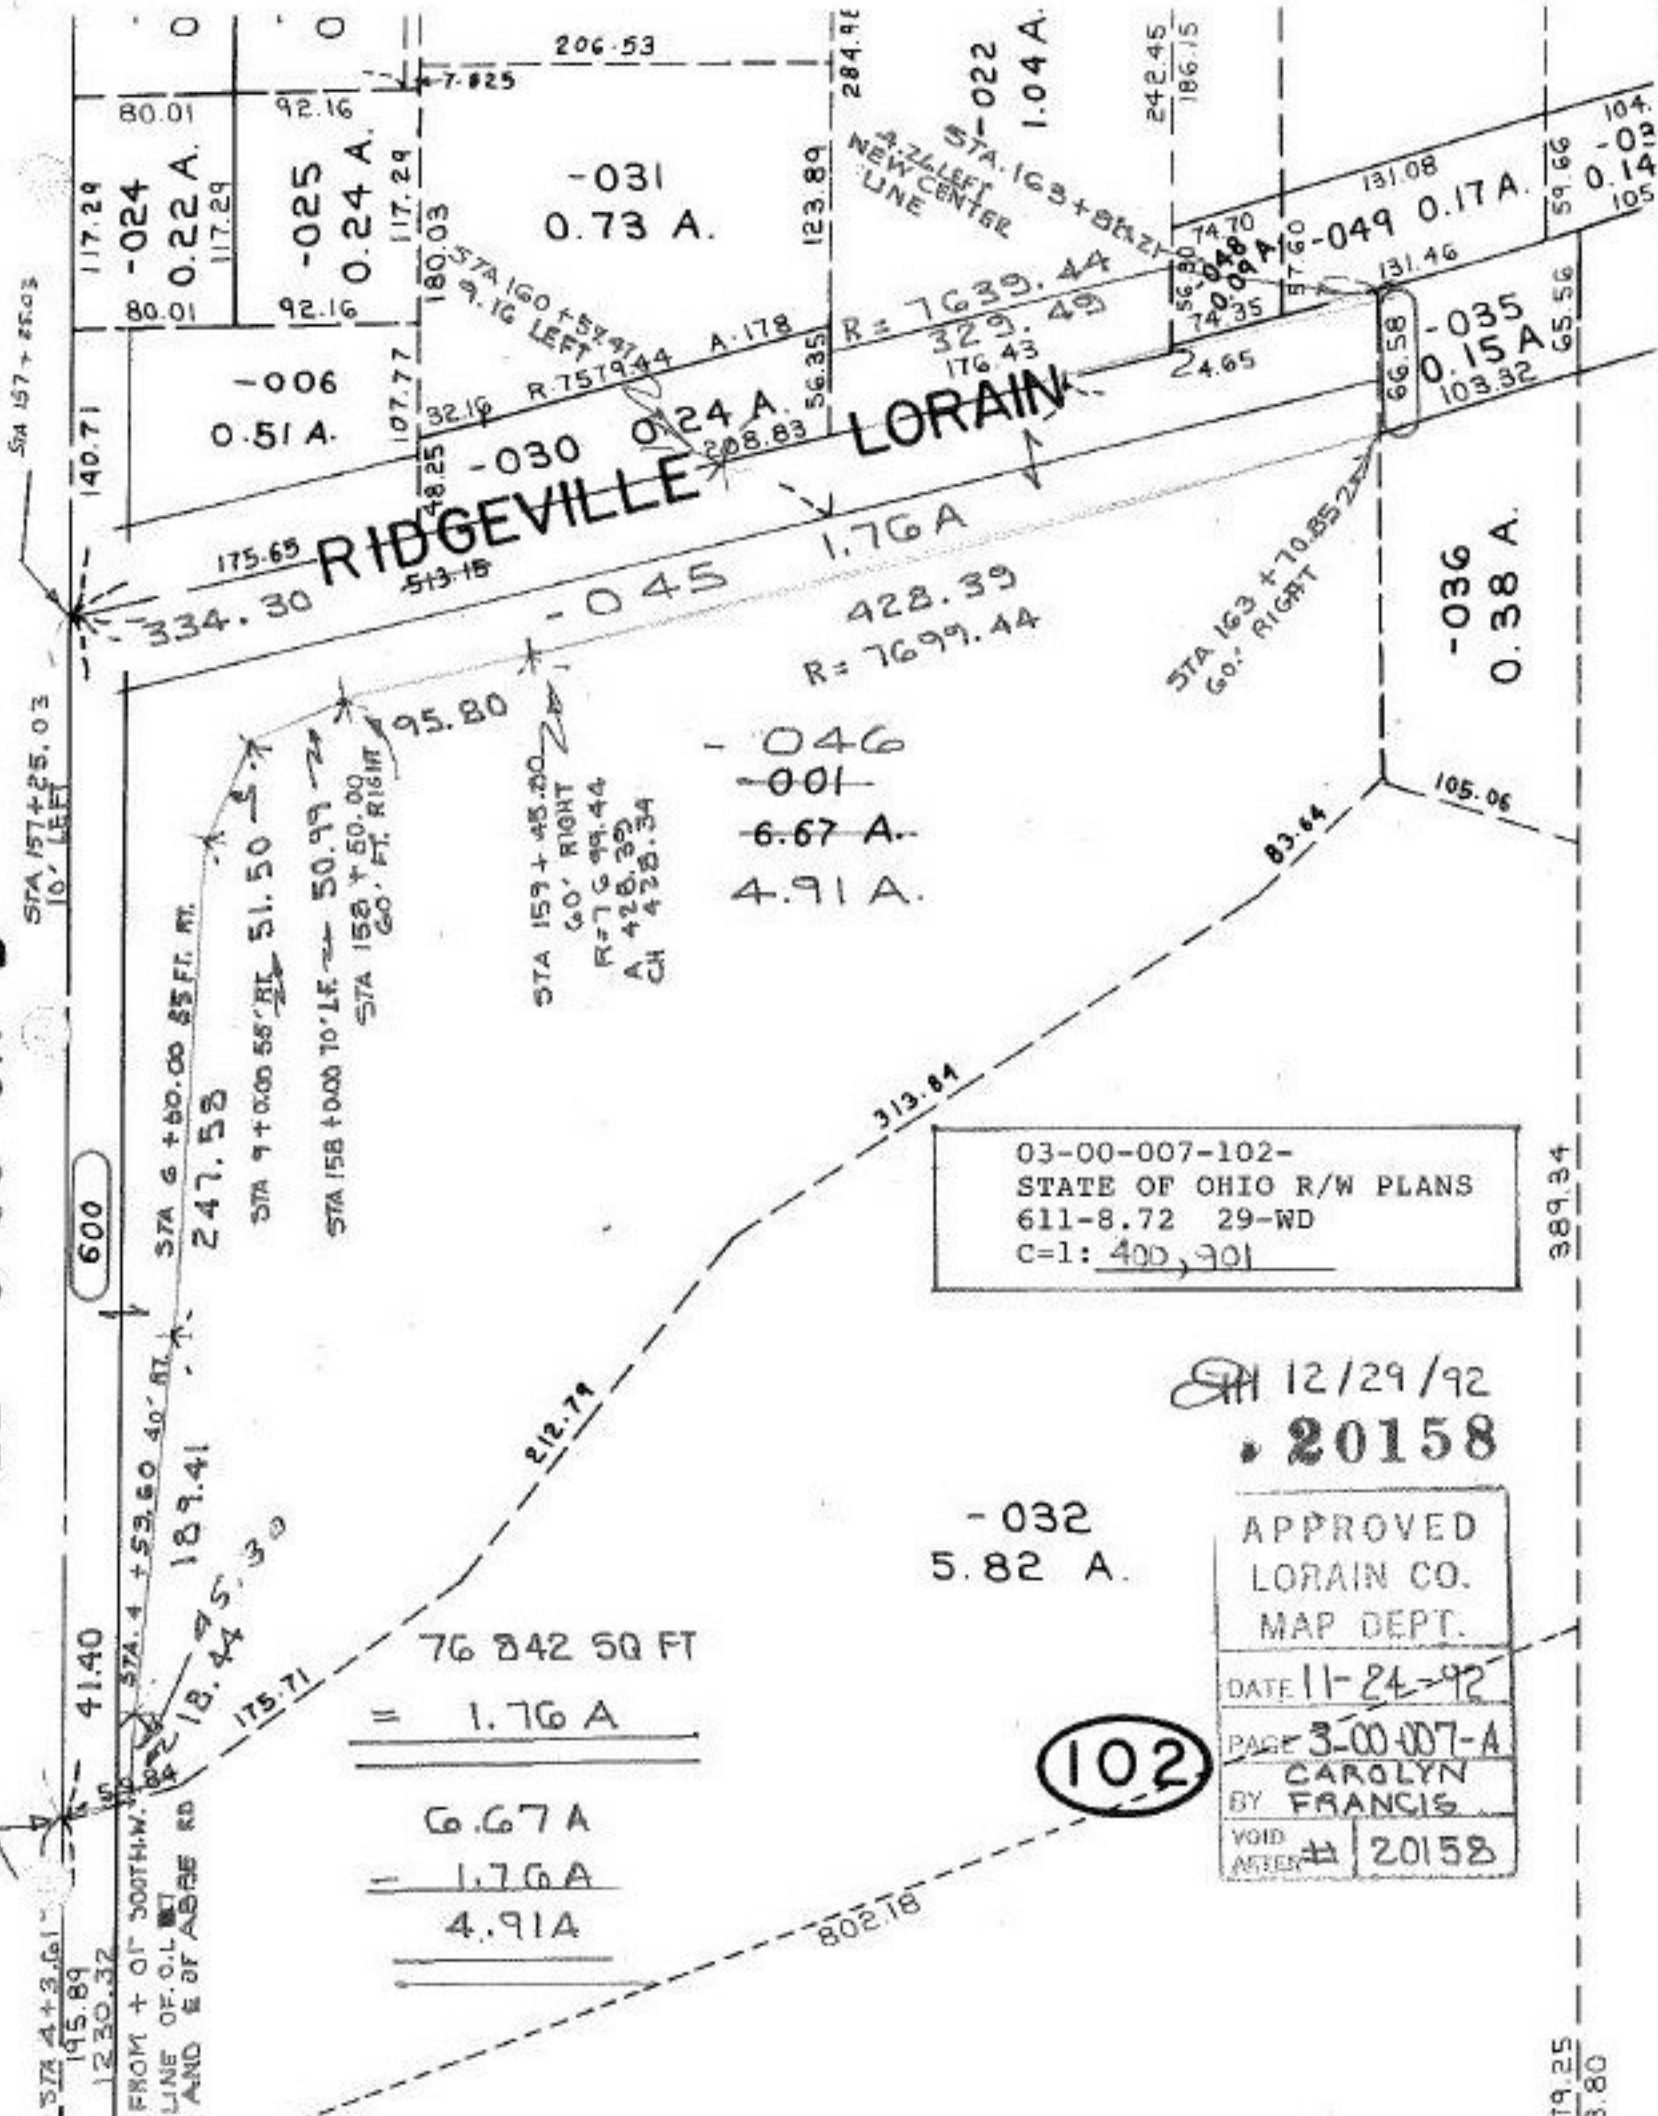

03-00-007-102-
 STATE OF OHIO R/W PLANS
 611-8.72 29-WD
 C=1: 400, 901

12/29/92
 20158

APPROVED
 LORAIN CO.
 MAP DEPT.
 DATE 11-24-92
 PAGE 3-00-007-A
 BY CAROLYN FRANCIS
 VOID AFTER 20158

102

76 842 SQ FT
 = 1.76 A
 6.67 A
 = 1.76 A
 4.91 A

79.25
 3.80