


2-02-015-B

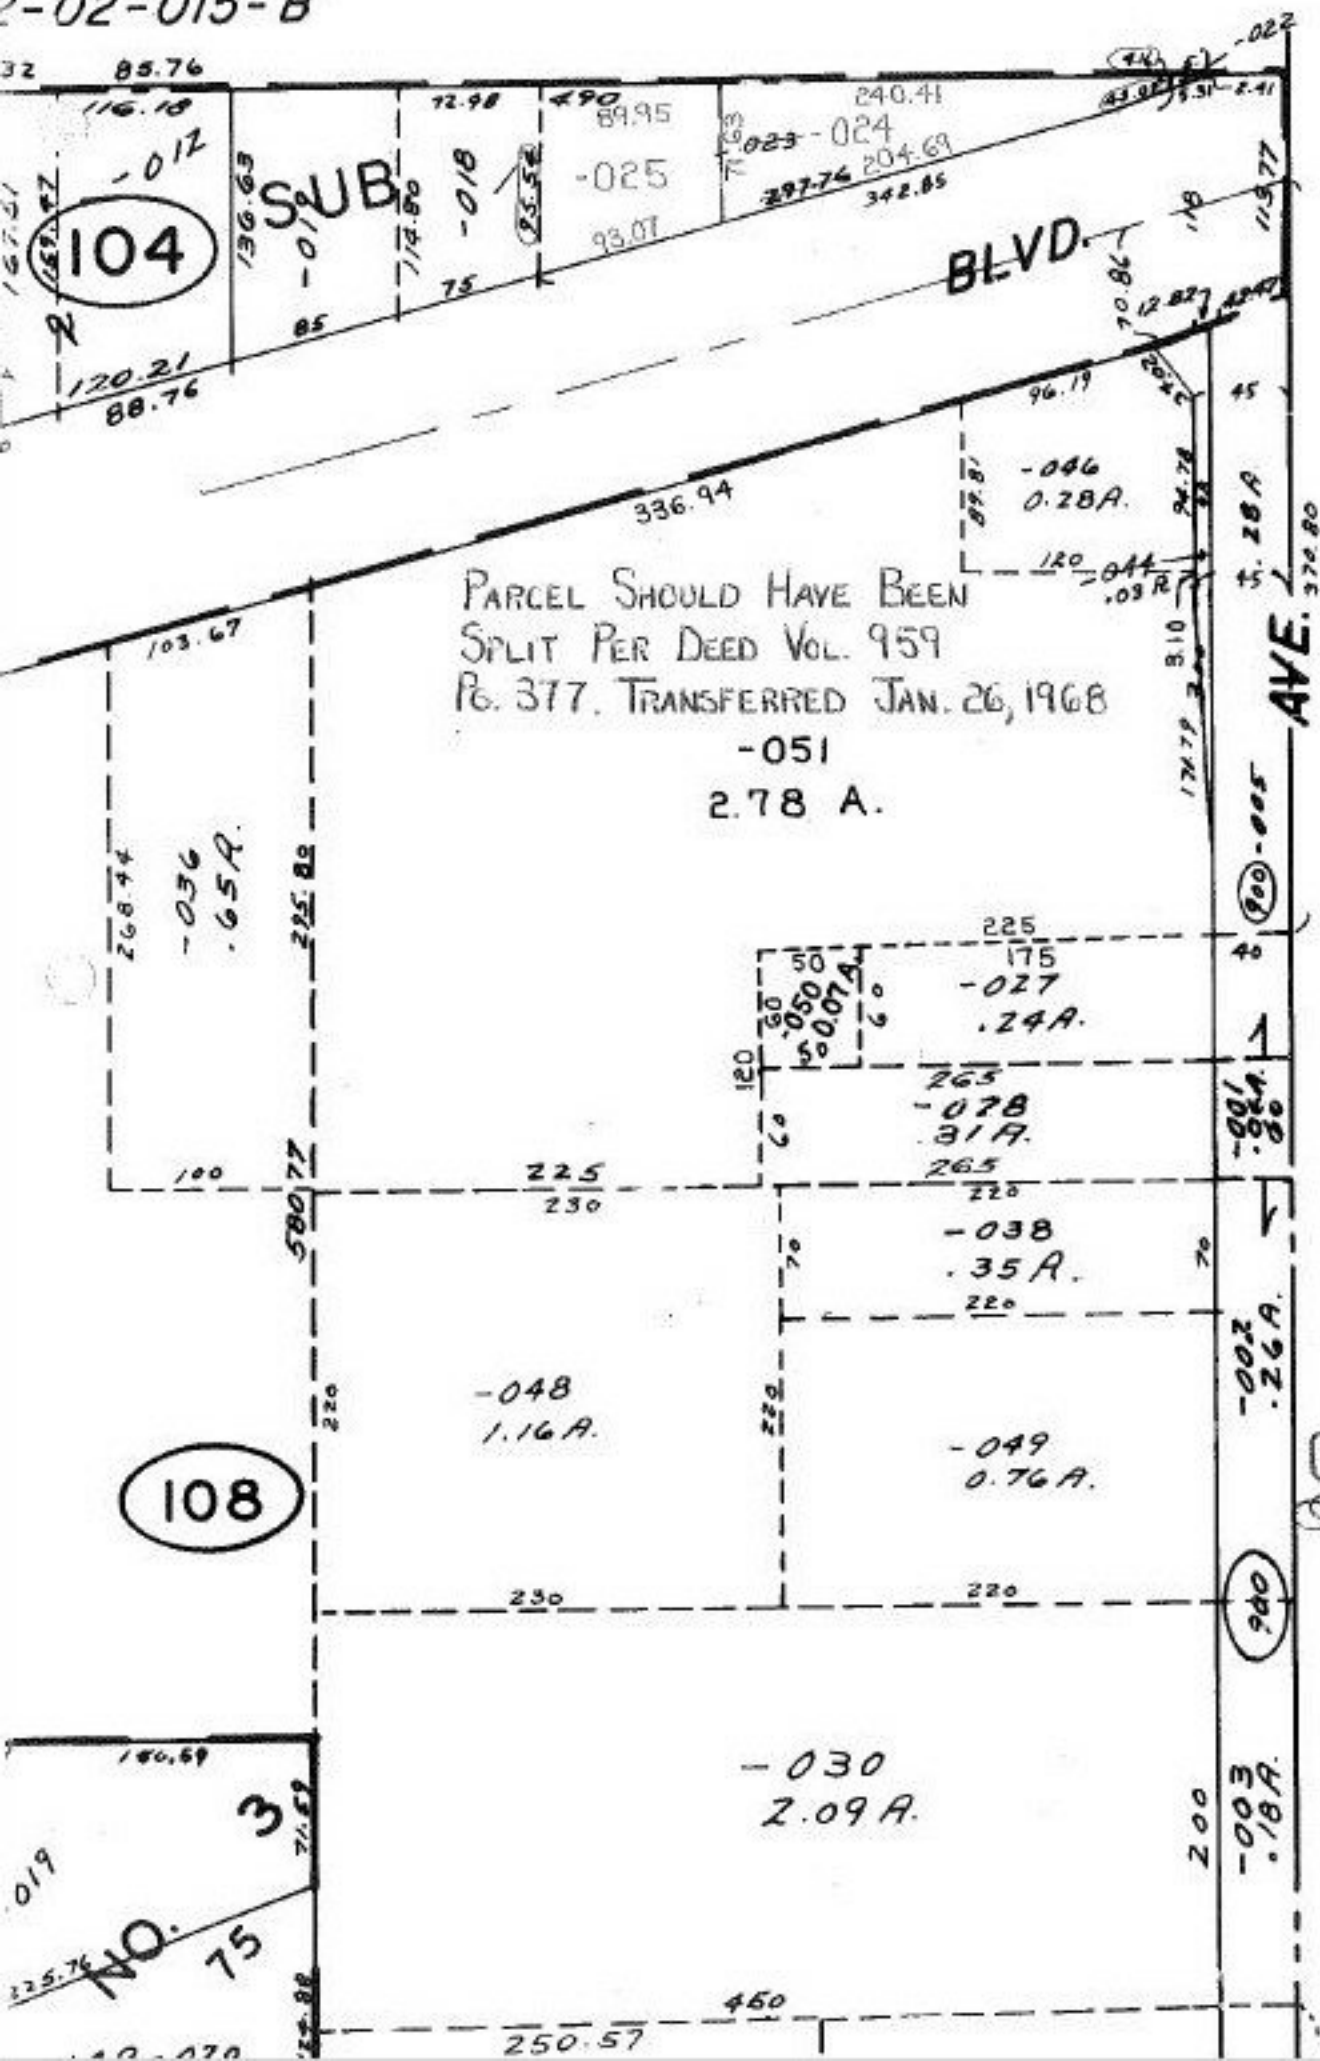

PARCEL SHOULD HAVE BEEN
 SPLIT PER DEED VOL. 959
 PG. 377. TRANSFERRED JAN. 26, 1968
 -051
 2.78 A.

MAP
 CORRECTION
 12/19/92
 #20160-A

APPROVED LORAIN CO. MAP DEPT.	
DATE 11-18-92	
PAGE 2-02-006-B	
BY T. HOLLIS	
VOID AFTER	20160-A