


MAP CORR.

SEE SURVEY

MAP CORR. A LINE
TAKE OUT HOOKS

FRENCH

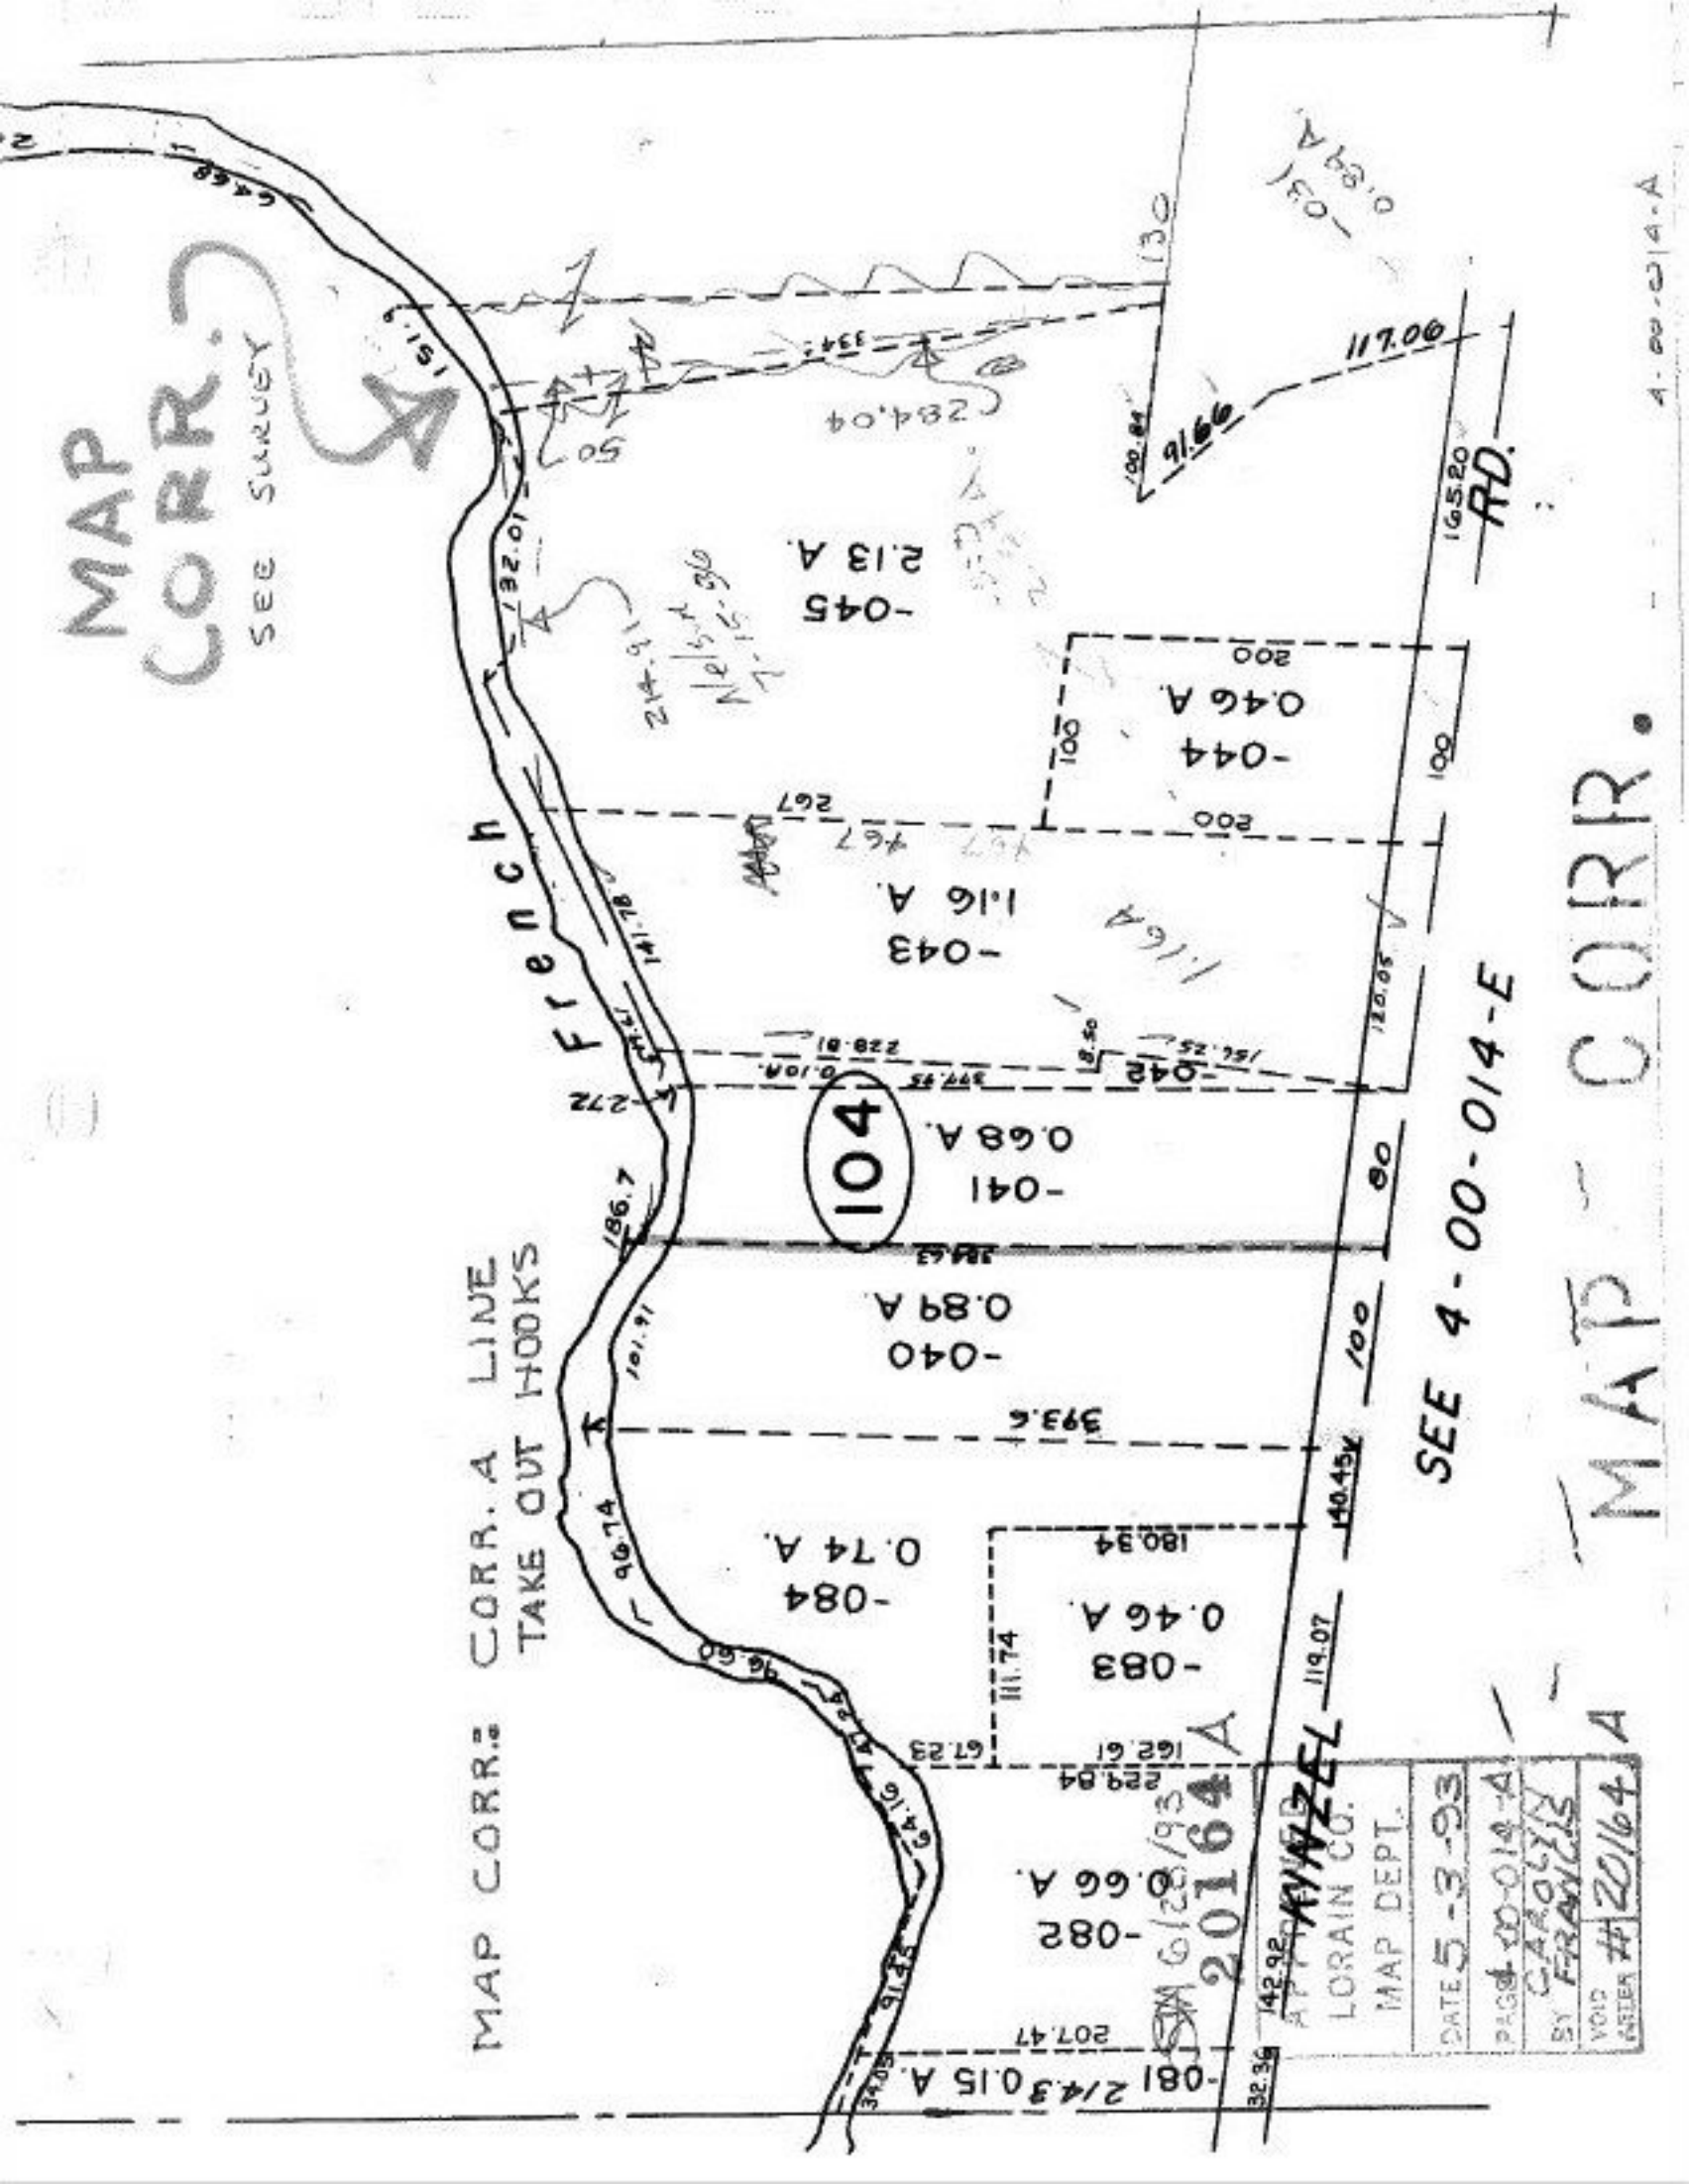

SEE 4-00-014-E

MAP - CORR.

APPROVED 742.92 LORAIN CO. MAP DEPT.	DATE 5-3-93
BY CAROLYN FRANKS	PAGE 00-014-A
VOID ASTER #20164 A	

SM 6/28/93
20164 A

A-00-014-A