


SEE 4-00-019-L

985.65 FROM + 1/4 OF WALKER RD AND LEAR RD

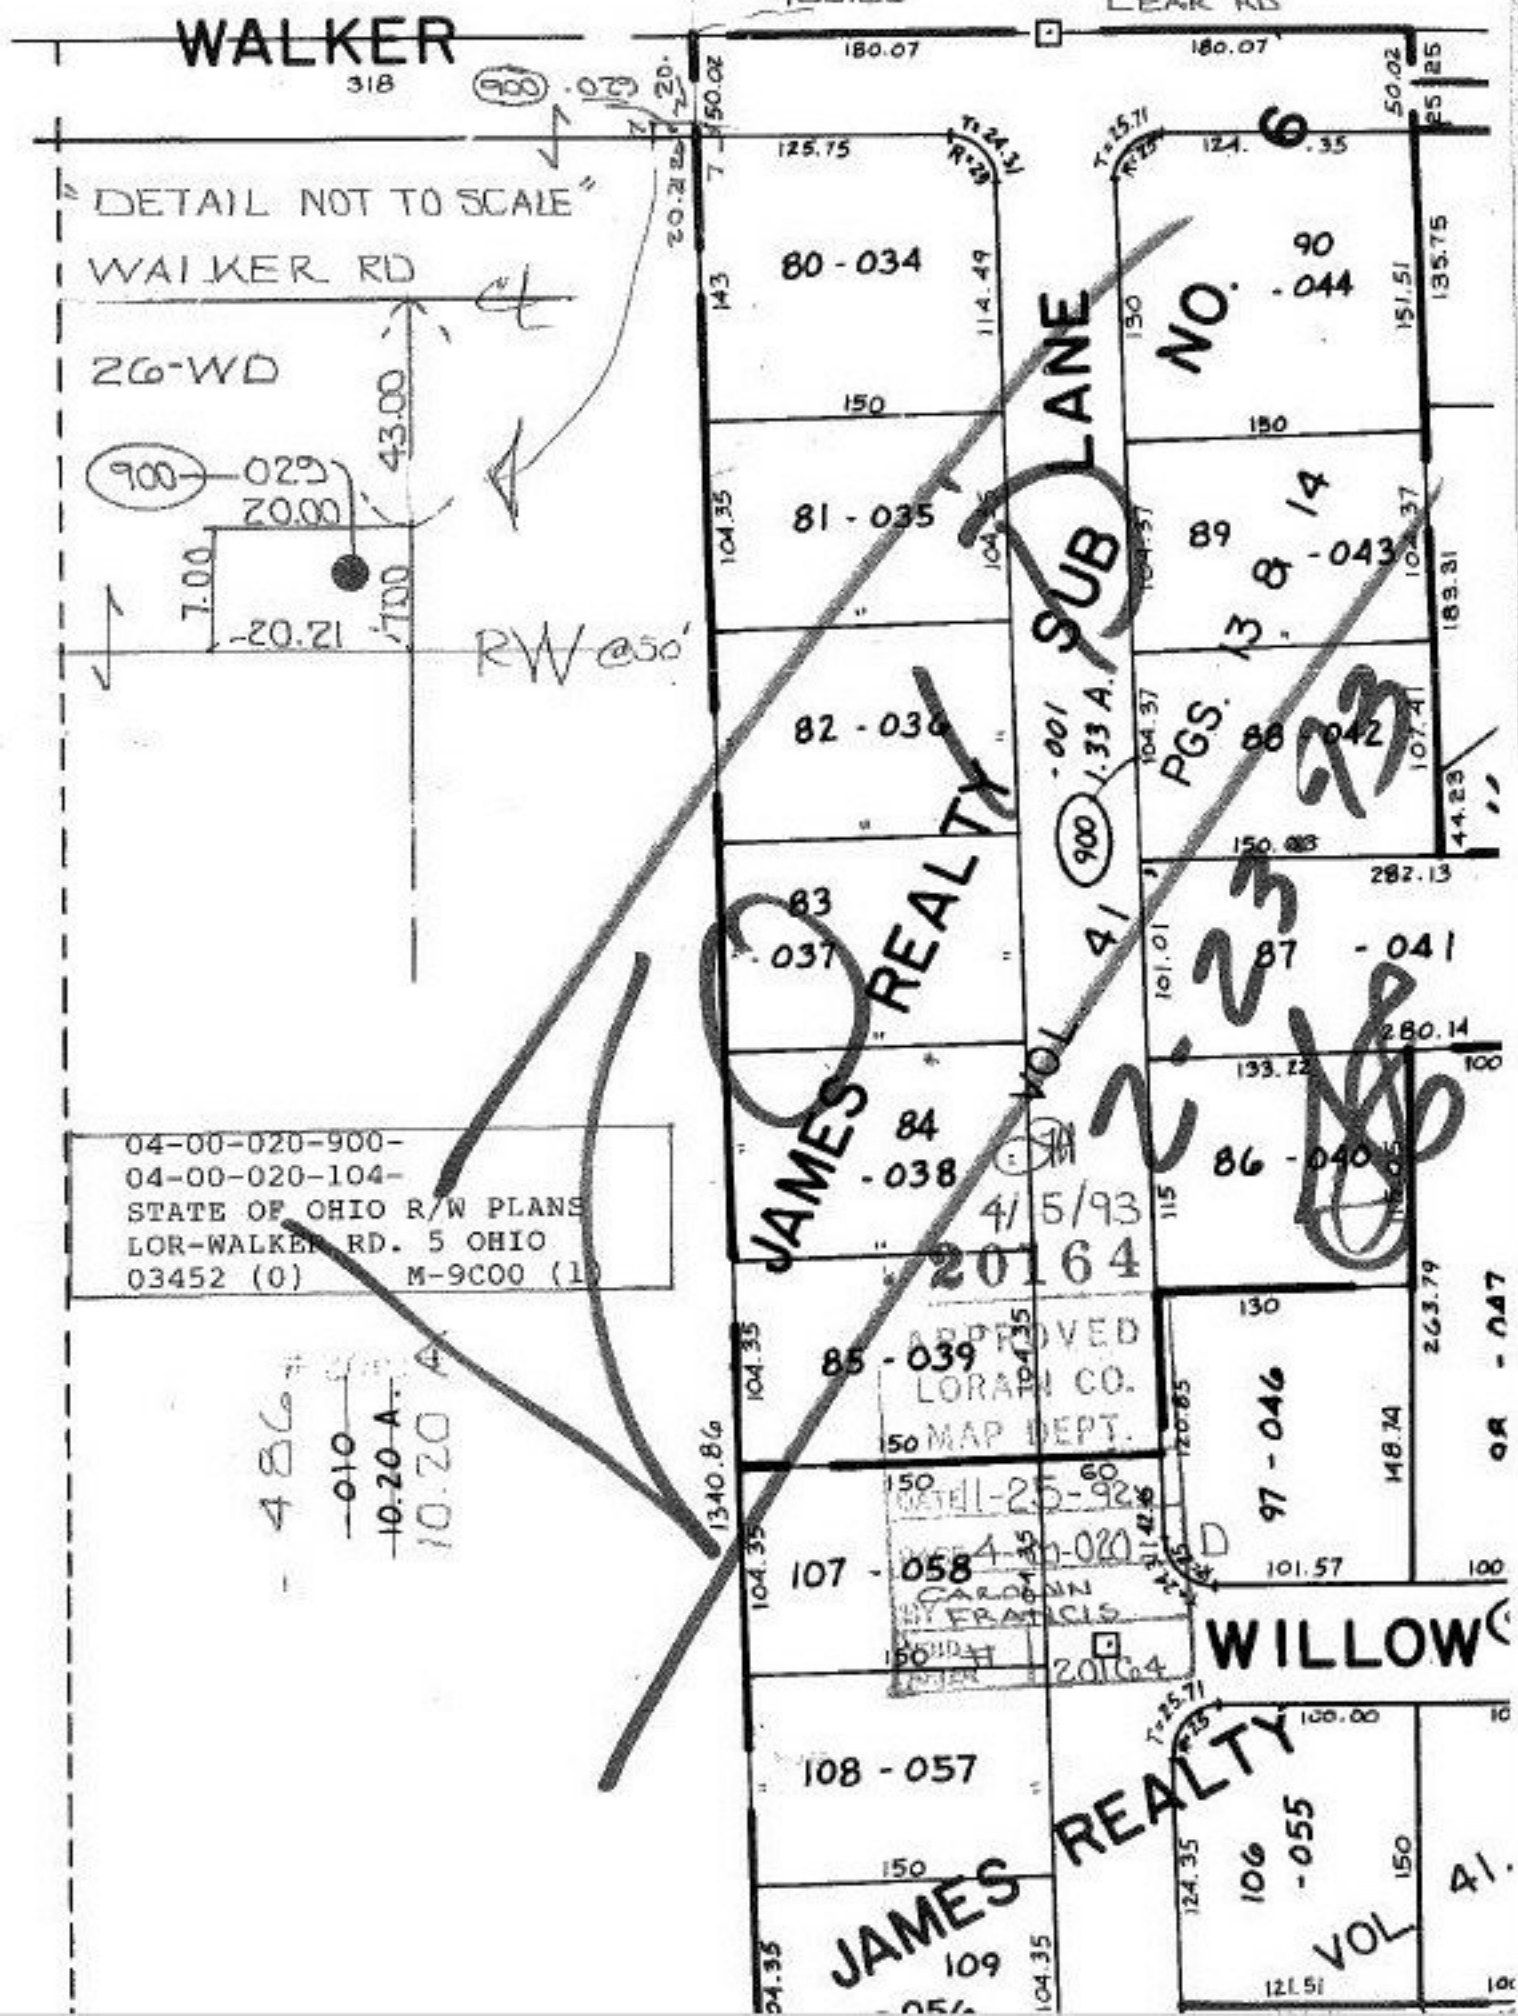

04-00-020-900-  
04-00-020-104-  
STATE OF OHIO R/W PLANS  
LOR-WALKER RD. 5 OHIO  
03452 (0) M-9C00 (1)

APPROVED  
LORAIN CO.  
MAP DEPT.  
MAY 11 2016