

839.5

725.5

8-17-80

~~-032~~

~~013~~

~~17.44A.~~

15.03A

$$AV 840.17 \times 725.50 = 60,954,333.$$

$$60 \times 670.60 = \frac{40,236.00}{60,994,569.5}$$

$$\frac{40,236.00}{60,994,569.5}$$


43560

780.84 + -
636.72

130

156.82 216.82

2017

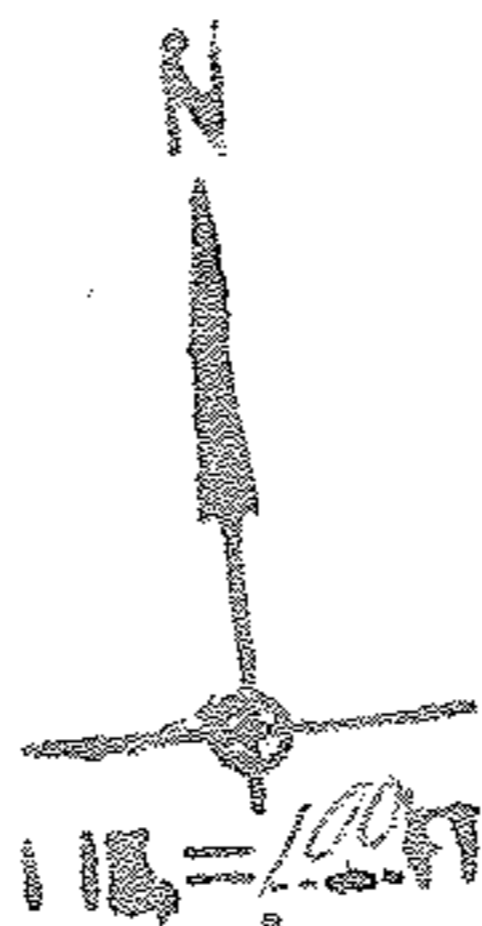

-014
7.10A.

J.D.
2-24-88

APPROVED
LORAIN CO.
MAP DEPT.
DATE 2-9-68
12-00-037A
BY [Signature]
6/30/68 R.K.

-015
2.00A.

670.6

156.82 x 670.60 = 105,163,419.50

2.411
14
16.411

670.6

60 x 670.60

494.02

130

216.82

SQUIRE

156.82

60