

30


ZONES

2

RD.

RRS.

052
164A

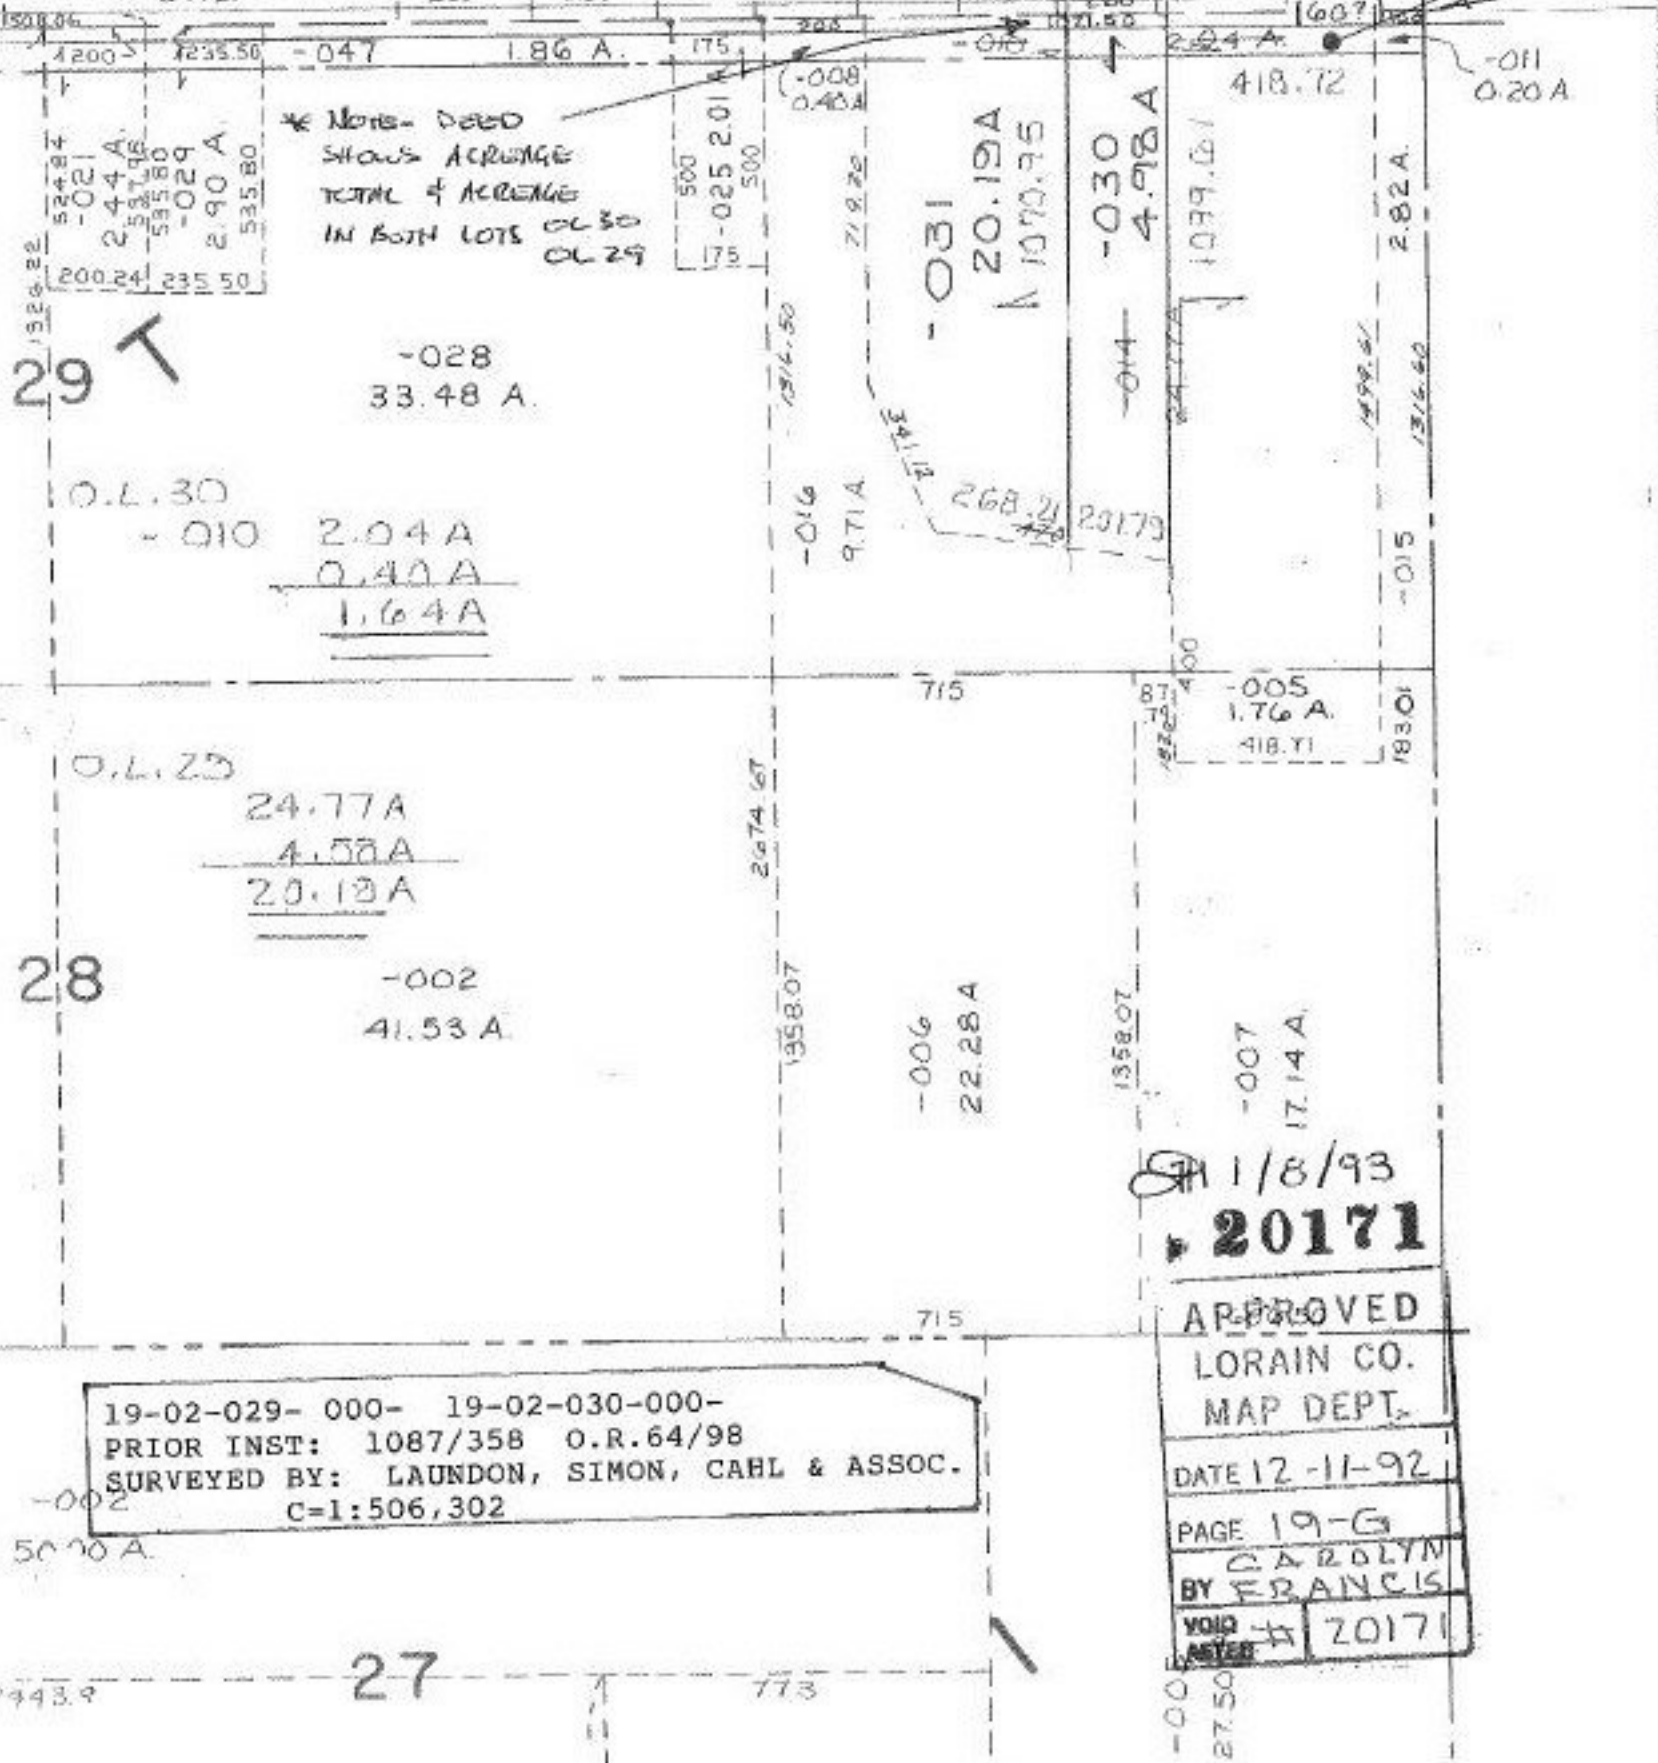

* Note - Dead Shows Acreage Total of Acreage in Both Lots OL 30 OL 29

19-02-029-000- 19-02-030-000-
 PRIOR INST: 1087/358 O.R.64/98
 SURVEYED BY: LAUNDON, SIMON, CAHL & ASSOC.
 C=1:506,302

11/8/93
20171
 APPROVED
 LORAIN CO.
 MAP DEPT.
 DATE 12-11-92
 PAGE 19-G
 BY CAROLYN FRANCIS
 VOID AFTER # 20171