


~~2020~~  
2020

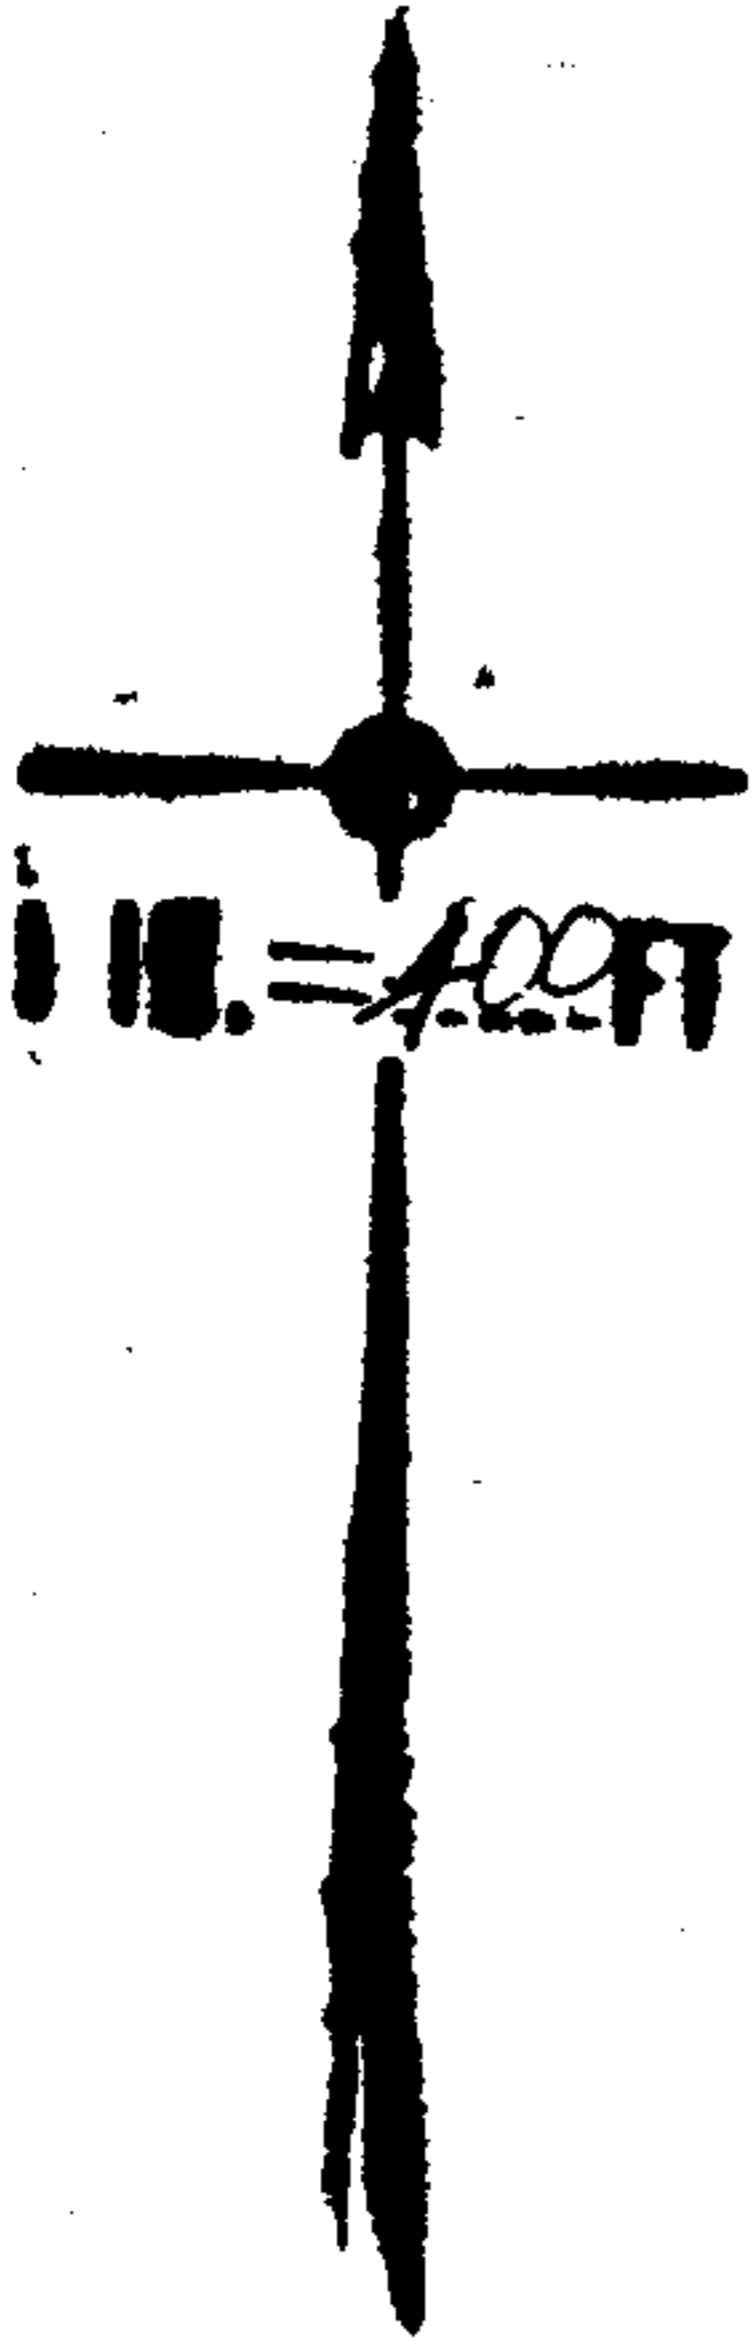

- 002  
30.00 A.

- 003  
30.00 A.

556.60 ~~846.12~~ 289.60

605.22

- 010  
8.52 A

846.20

- 003  
31.83 A.

12.21

- 011

~~40.00 A.~~

~~31.48 A.~~

- 002  
31.66 A.

177.79

1356.96

790.25

851

- 007  
37.50 A.

- 006  
6.50 A.

580.35

257.68

846.17

- 008

10.00 A.

519.00

846.17

(60) 519.00

(60)

BOONE

31-26

BOSTON

COLUMBIA TWP.

SCALE: 1" = 400'

APPROVED  
LORAIN CO.  
MAP DEPT.  
DATE 8-12-68  
12-11  
BY *[Signature]*

9/24/68 R.K.

