


SA 4/5/93
 20242
 APPROVED
 LORAIN CO.
 MAP DEPT.
 DATE 2-9-93
 PAGE 2-01-003-F
 BY CAROLYN
 FRANCIS
 VOID # 20242

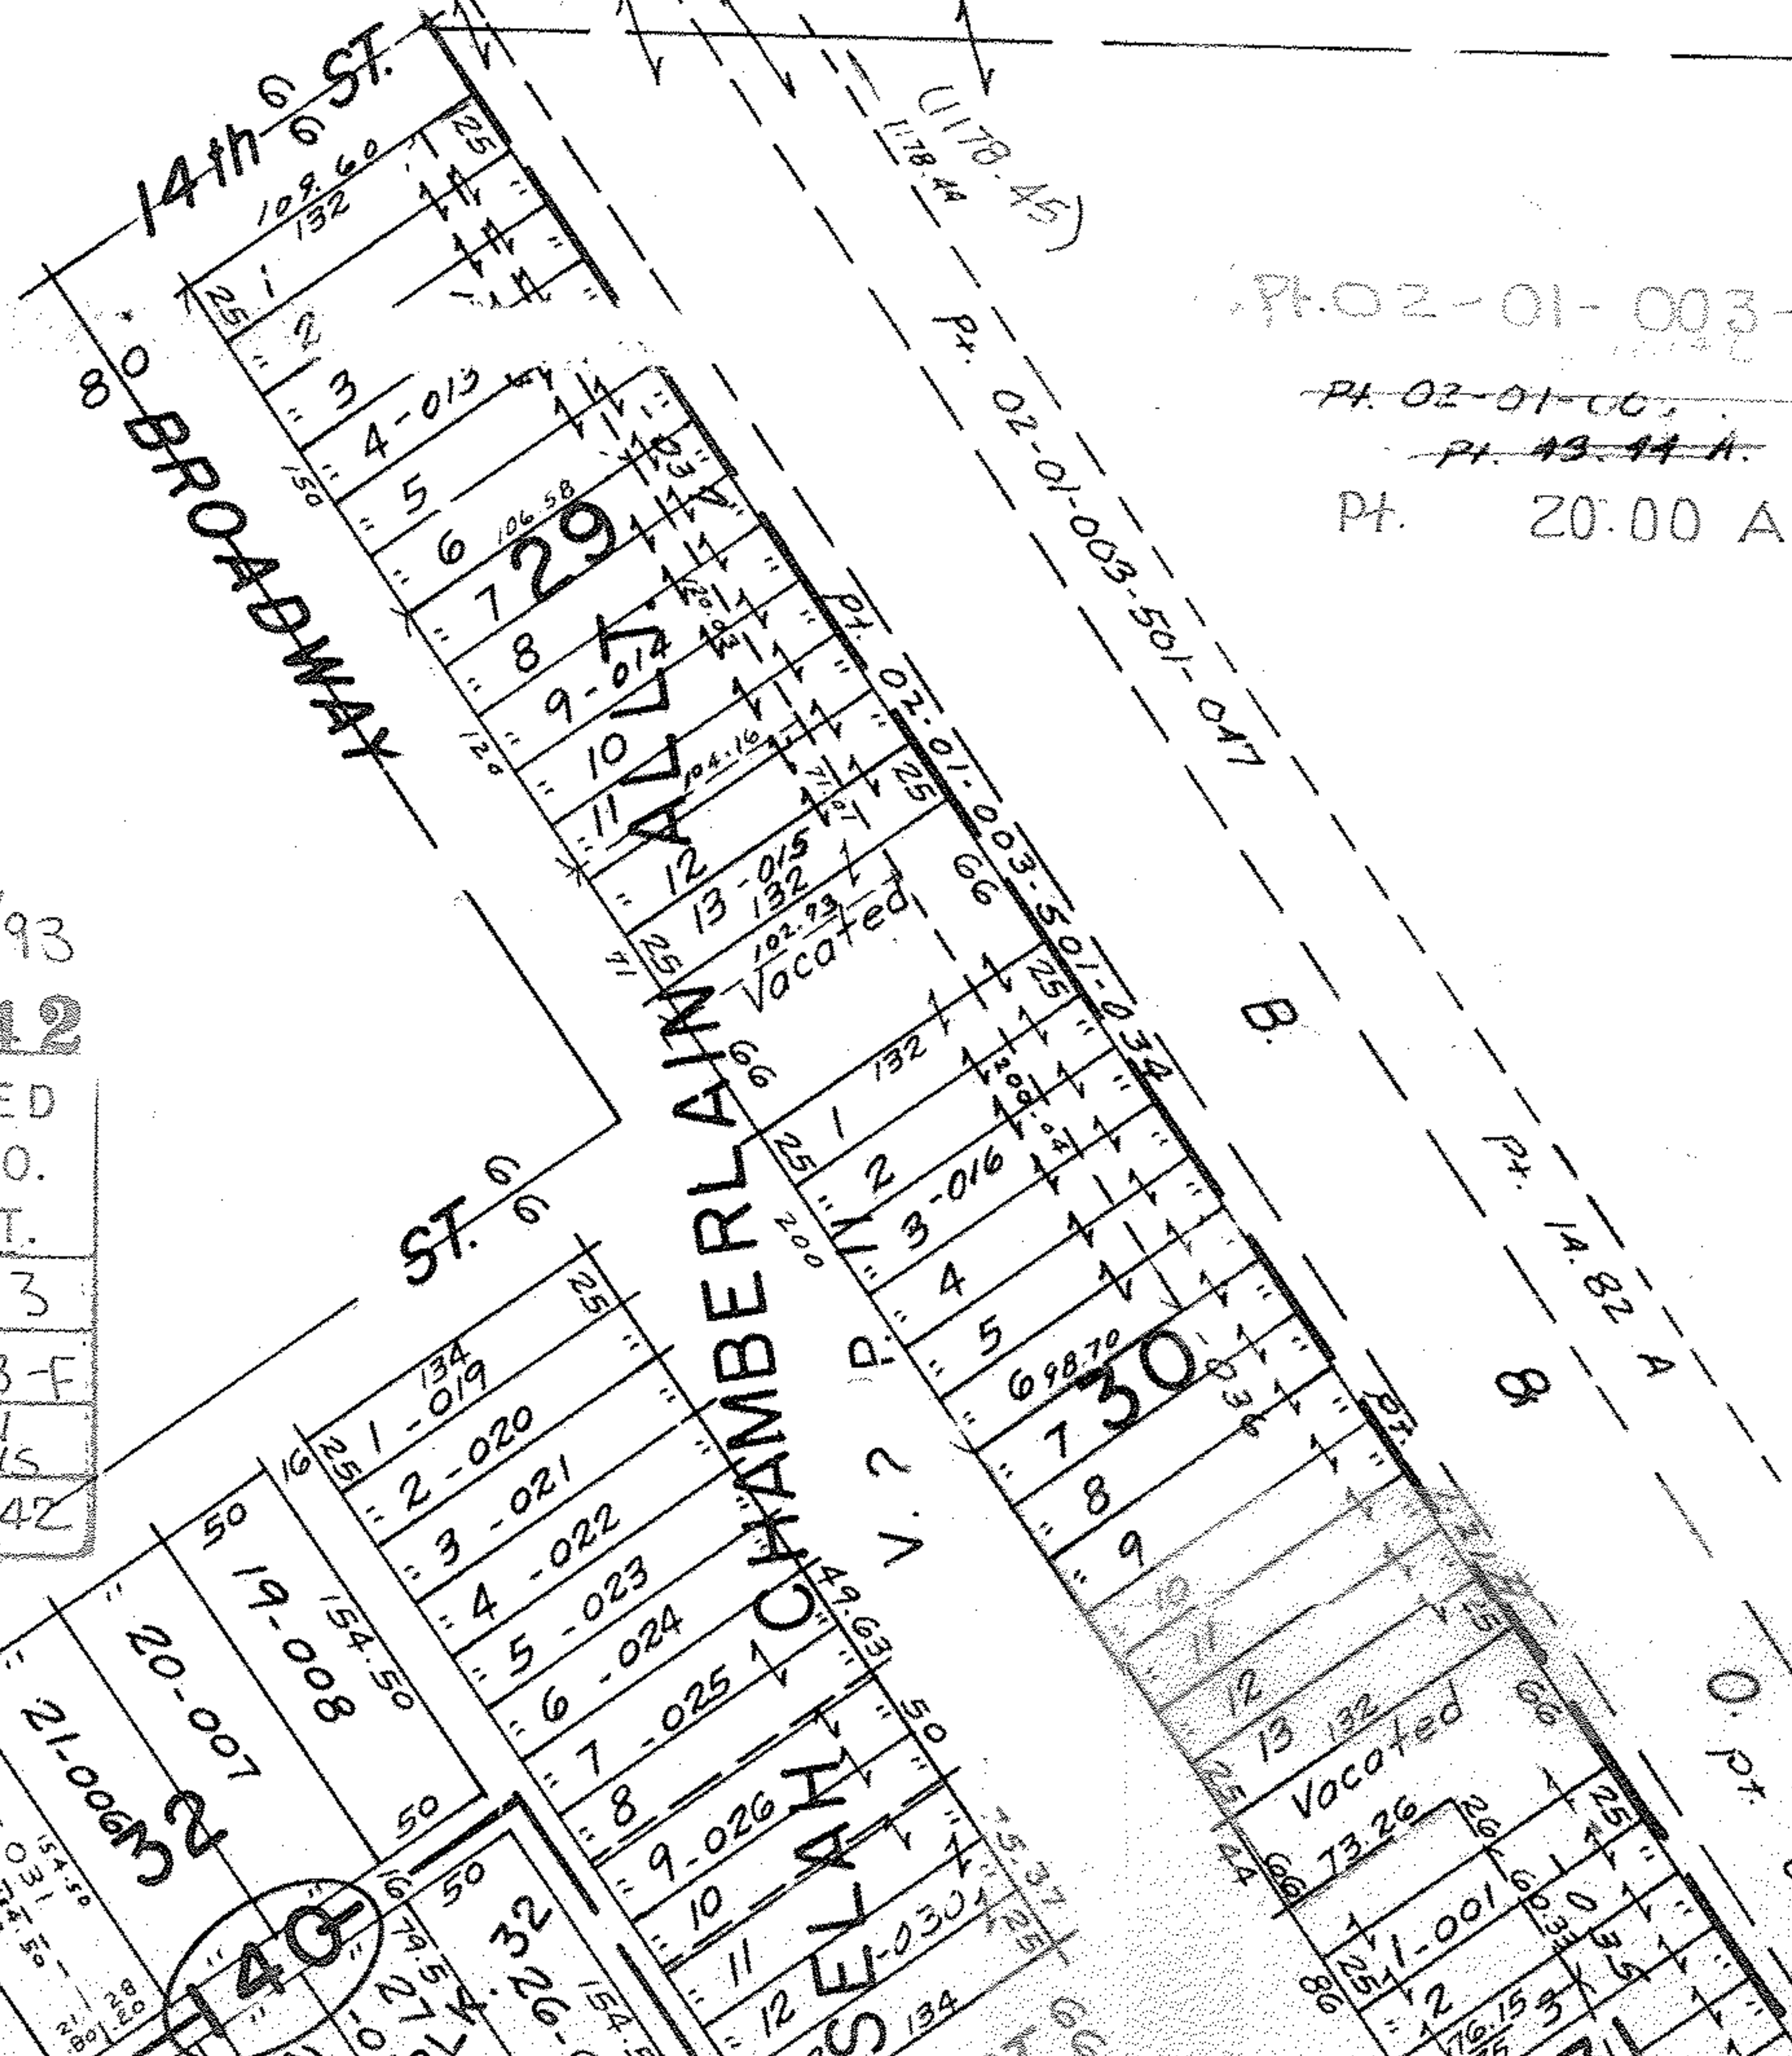

-004

Pt. 02-01-003-116-003

~~Pt. 02-01-003-046~~

~~Pt. 43-44 A~~

Pt. 20.00 A

115.27

2-01-

DOCK CORNER 124

116.55

112.48
112.47

222.76

POC