


2025

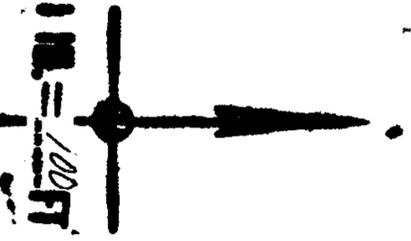


MEASUREMENTS

88 978-41-L

APPROVED
LORAIN CO.
MAP DEPT.
DATE 8-14-68
4-20-016G
BY <i>[Signature]</i>

9/24/68 R.K.

WOOSTER AVON LAKE

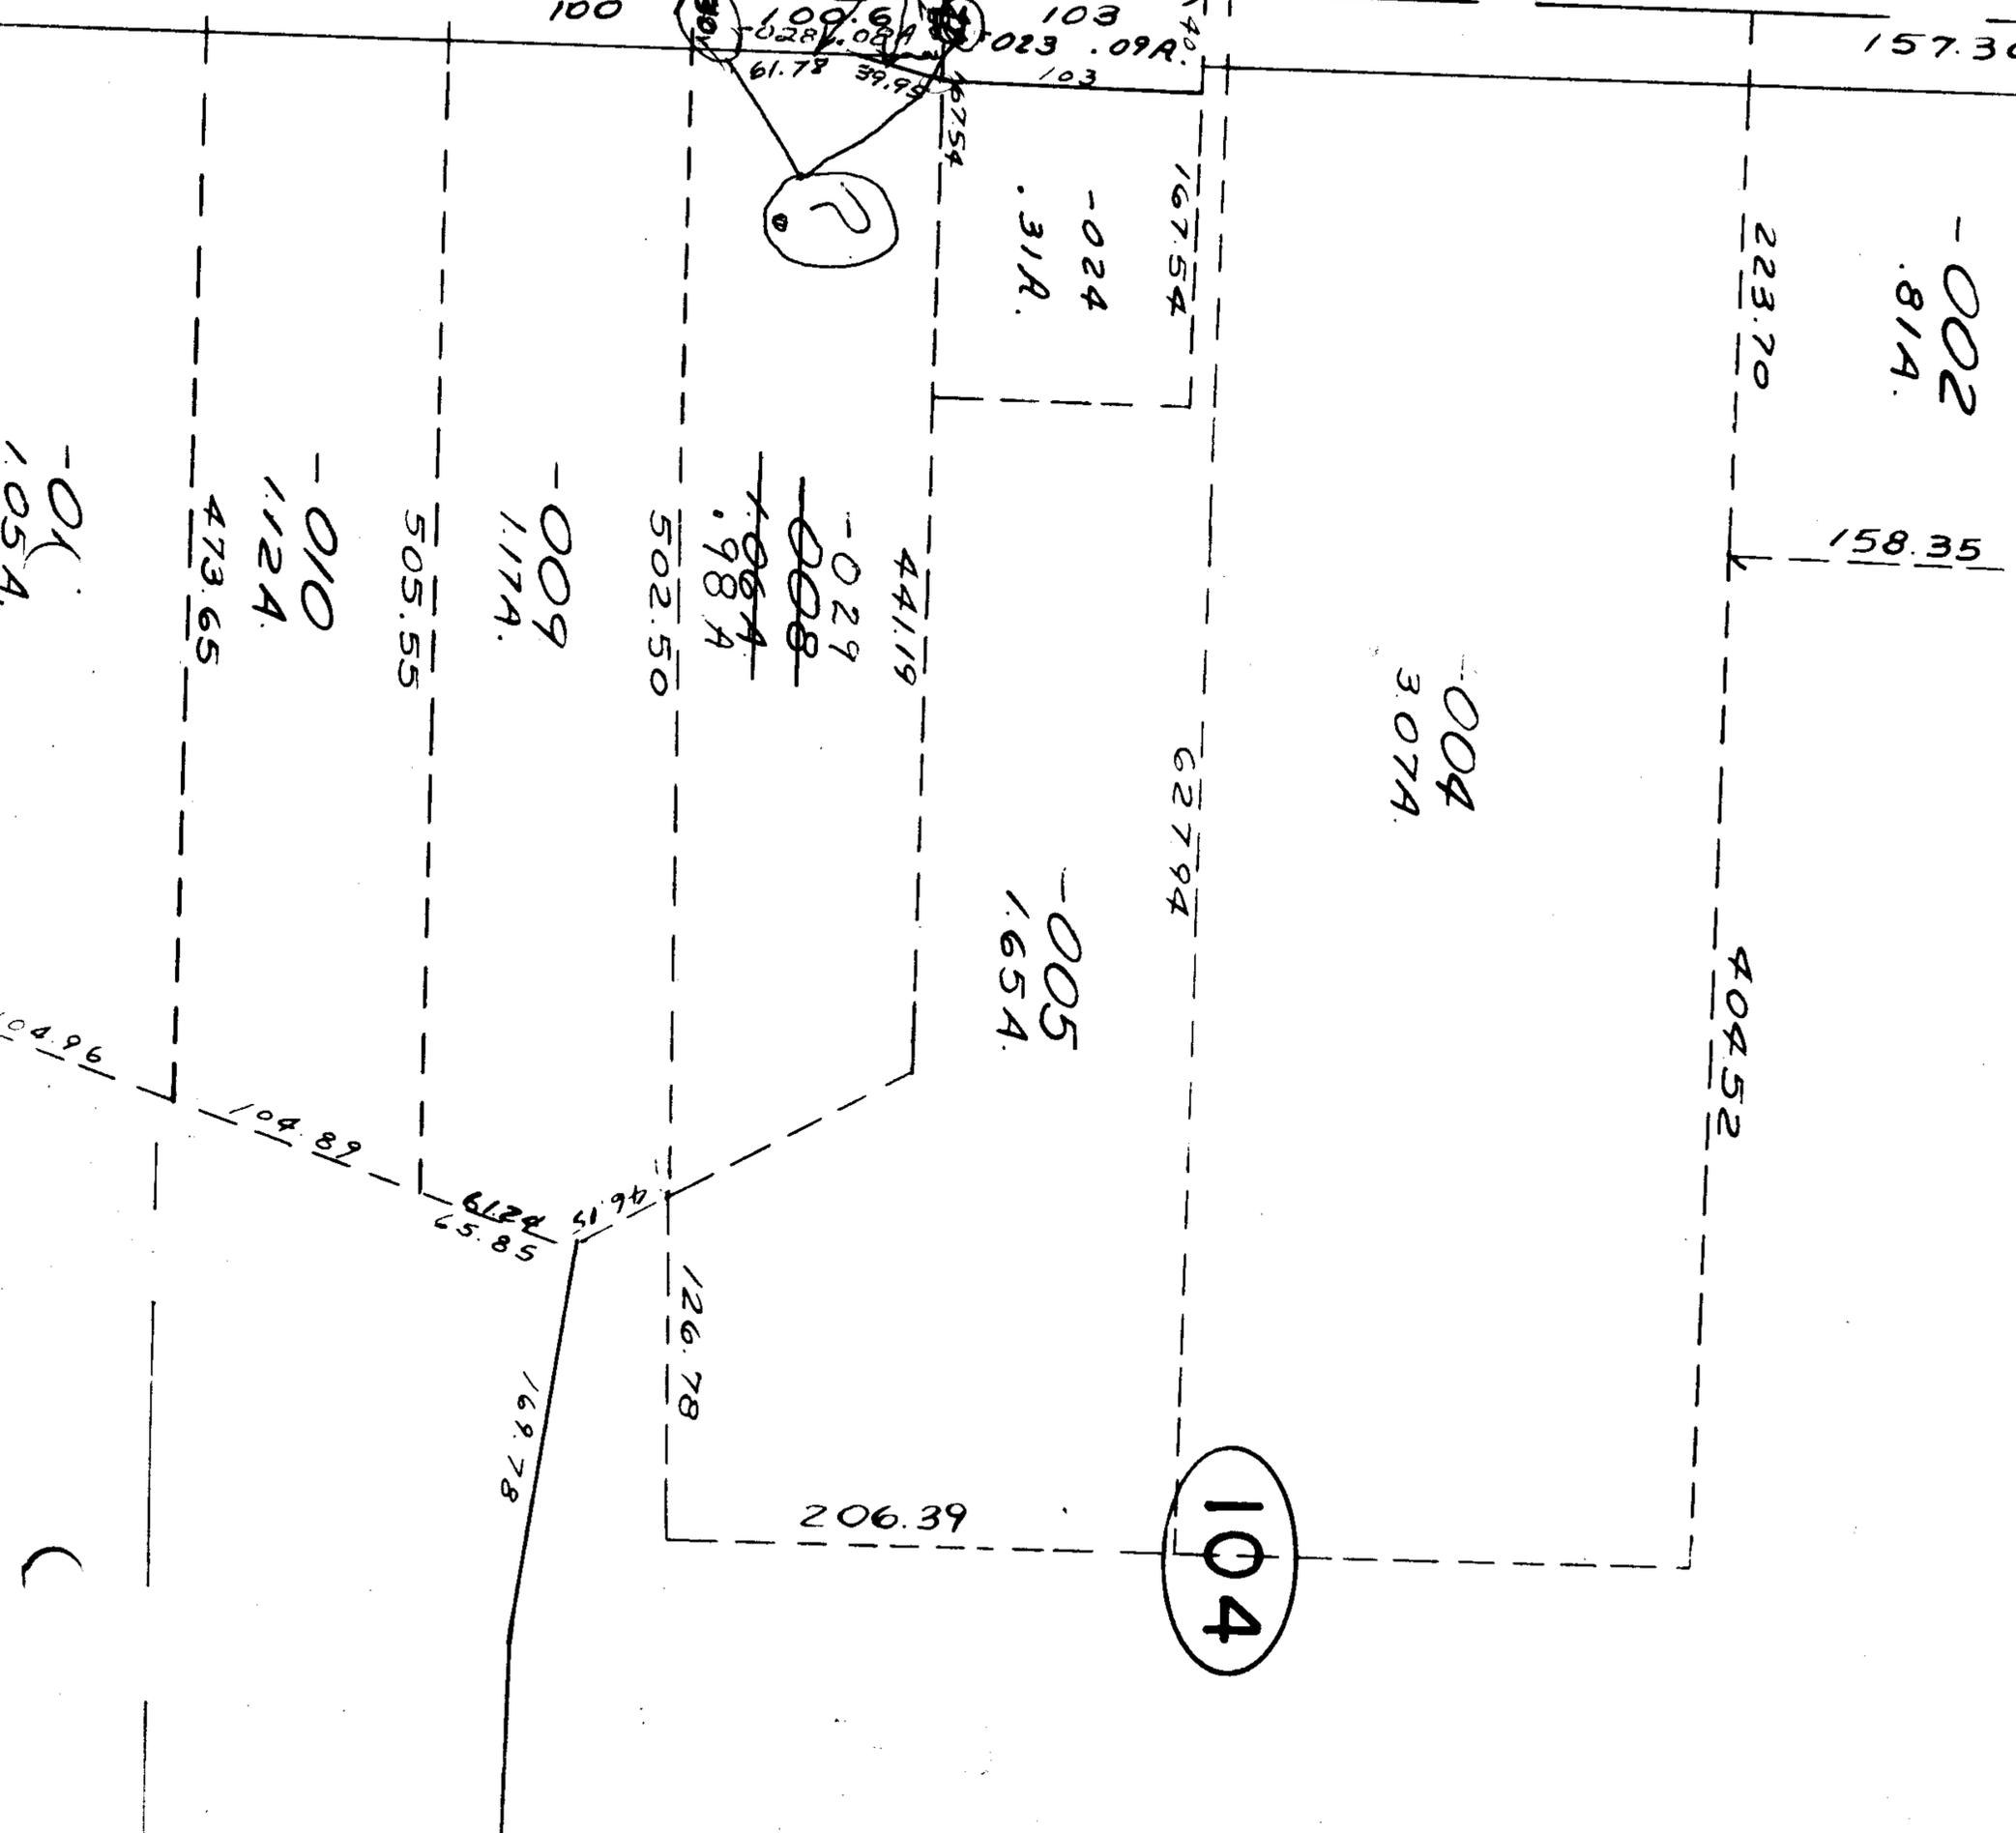

104

2

105A

102
81A

104
307A

105
165A

103
98A

109
117A

110
112A

473.65

105A
105A

157.30

223.70

158.35

404.52

627.94

167.54

44.19

502.50

505.55

104.96
98.57
61.24
46.15

126.78

169.78

206.39