


2029

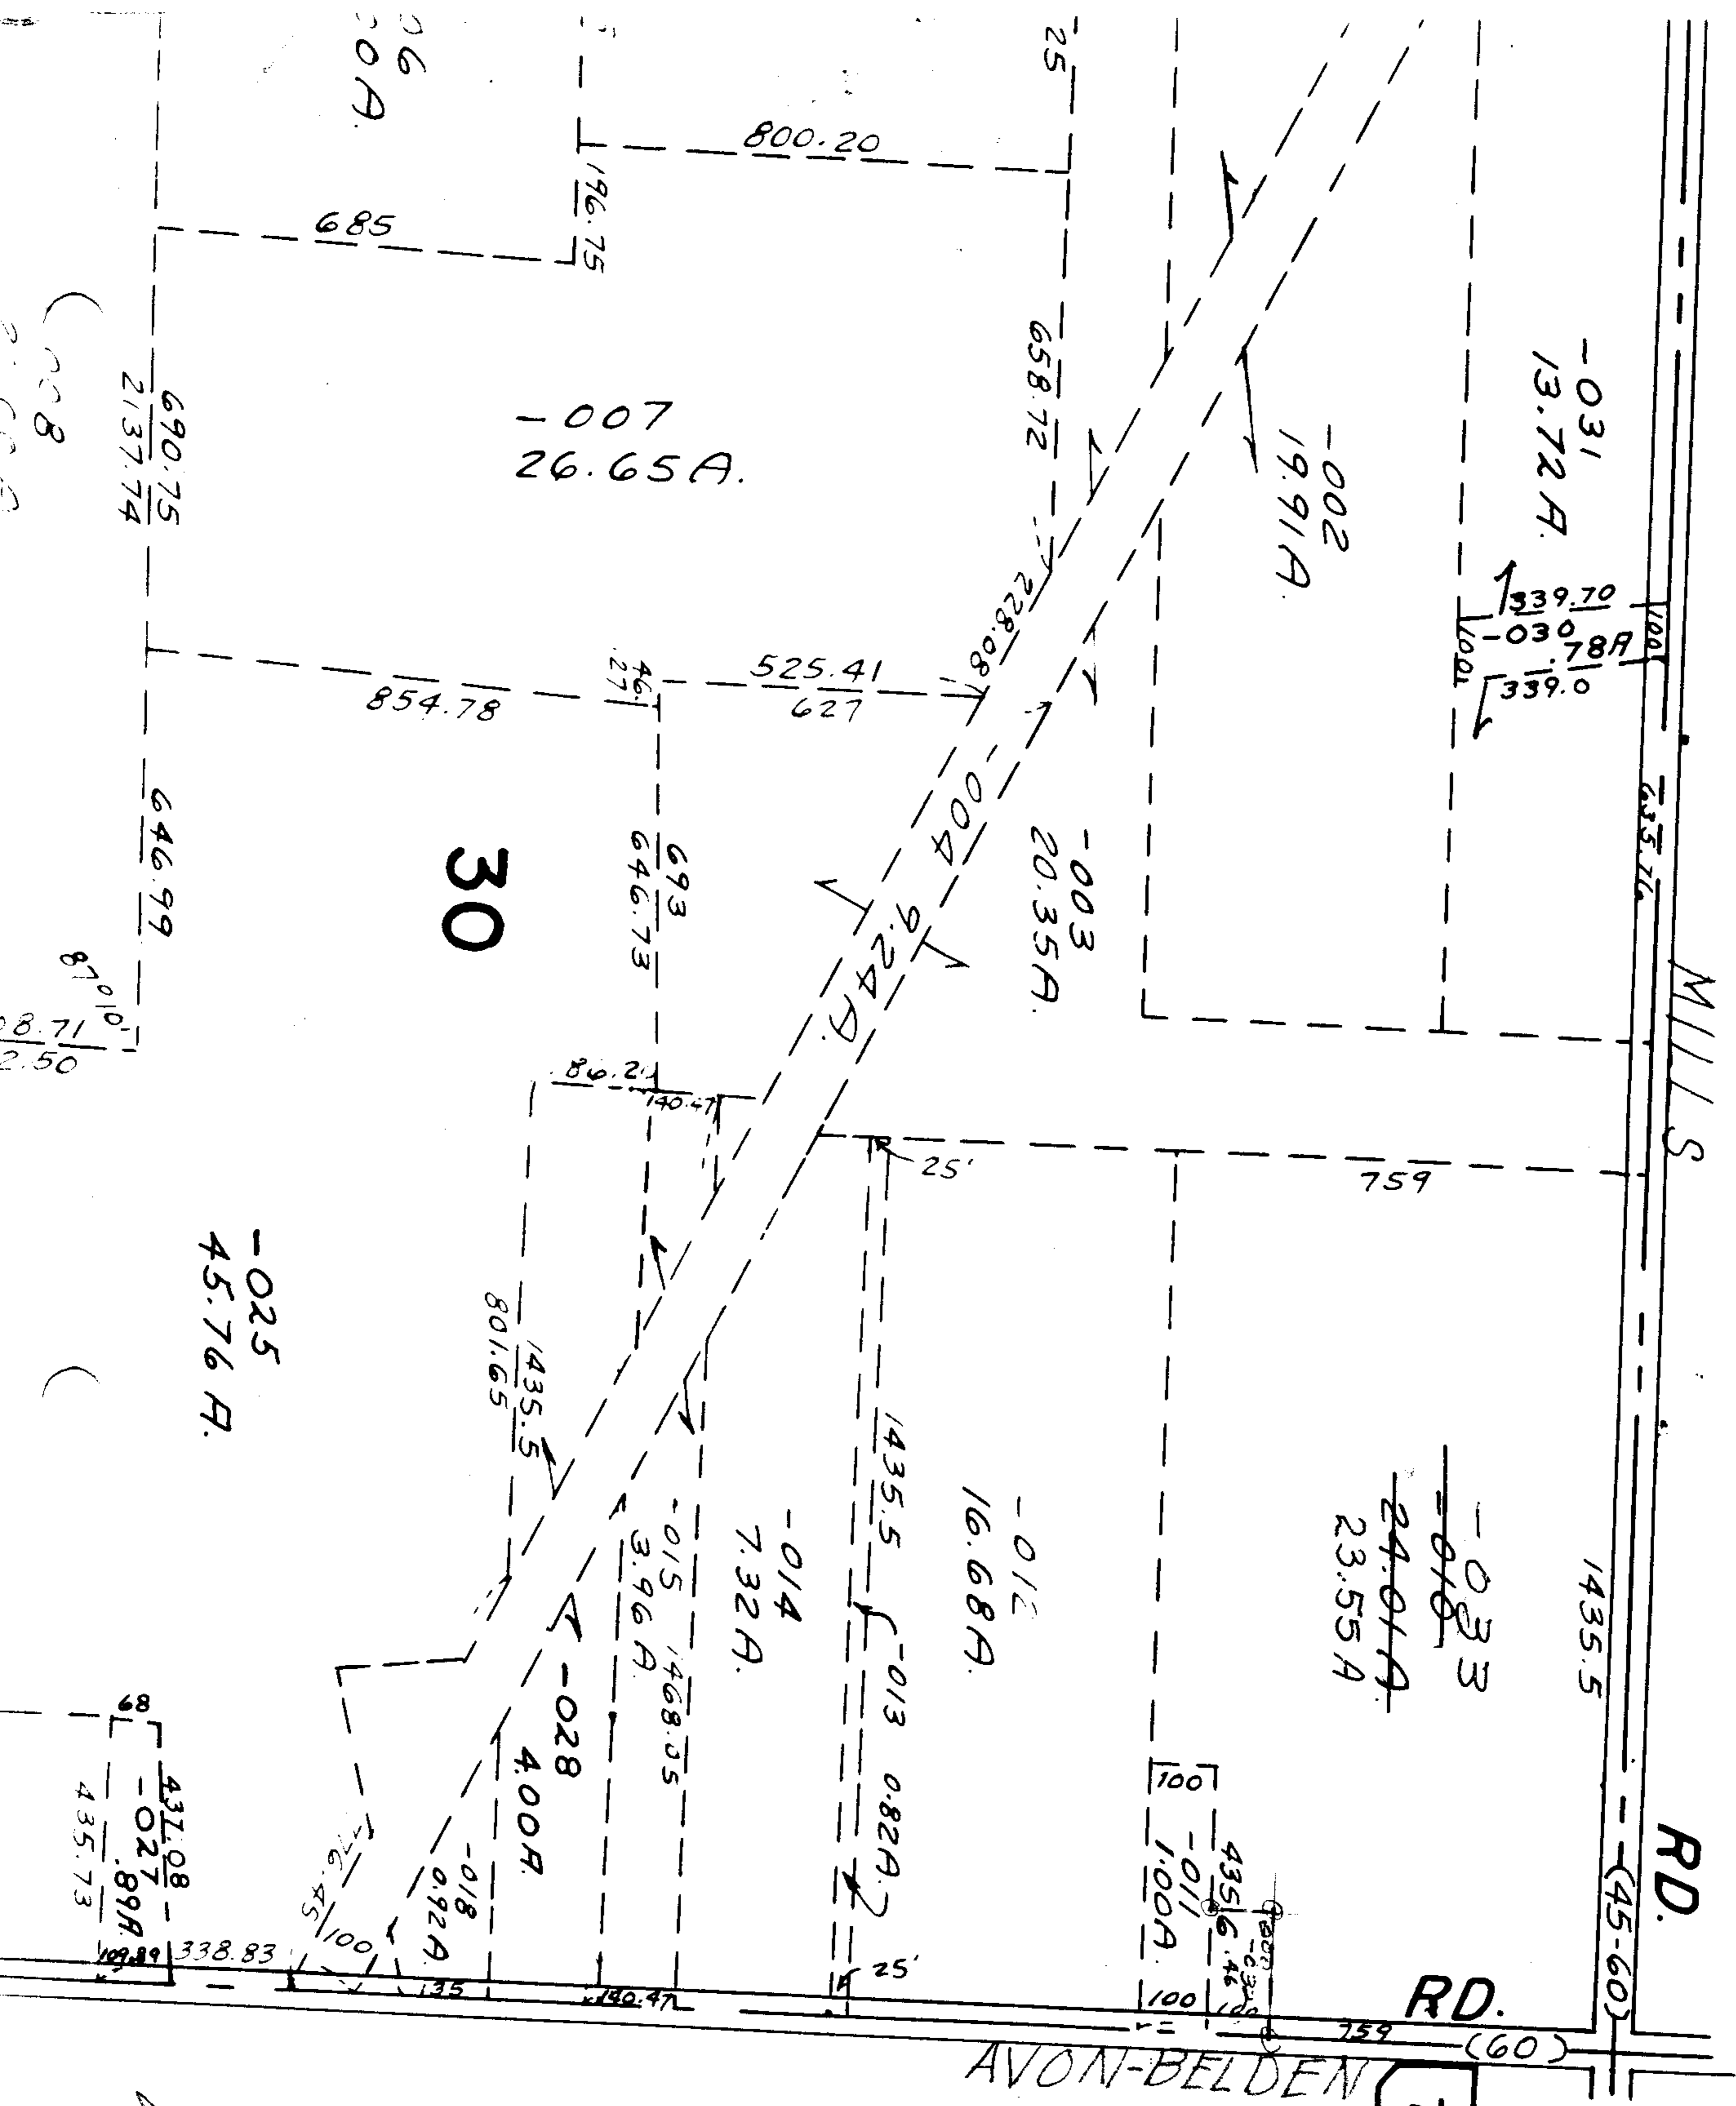

8898-41-4

APPROVED

LORAIN CO.

MAP DEPT.

DATE 8-15-68

7-B

BY *[Signature]*

9/26/68 R.K.



76

