

-018
4.36 A.

BENIK 1-27-91

UNCOMBINATION

04-00-015-109-068

-075
-076

587.20


JOHNSON

DEED FILED

2-22-93

O.R.

063

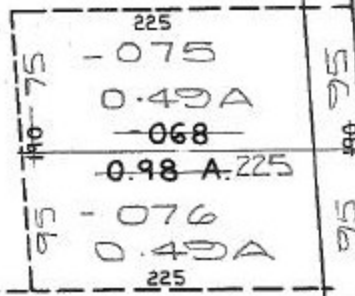

GREEN 6-27-84

-065
6/28/93
ROSS-
REVETER
20308A


APPROVED
LORAIN CO.
MAP DEPT.

DATE 5-6-93

PAGE 4-00-015-F

BY CAROLYN
FRANCIS

VOID AFTER # 20308-A

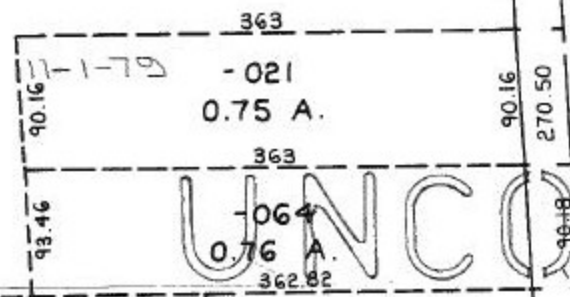

112.82
12.16

-023

SOUTH CENTER RD
WHEELER AVENUE
LAKE RD
SEE 4-00-015-G

PARCEL WAS
COMBINED 12-4-81 #17775-A
PARCEL IS BEING
UNCOMBINE 5-6-93
#20308 A

SEE DV. 1194/277
REF. 937/880

UNCOMB.